TASMAN & CROWN LYELL EXTD. M. CO., N. L.

PLAN OF WORKINGS

SCALE

0 40 80 100 FT
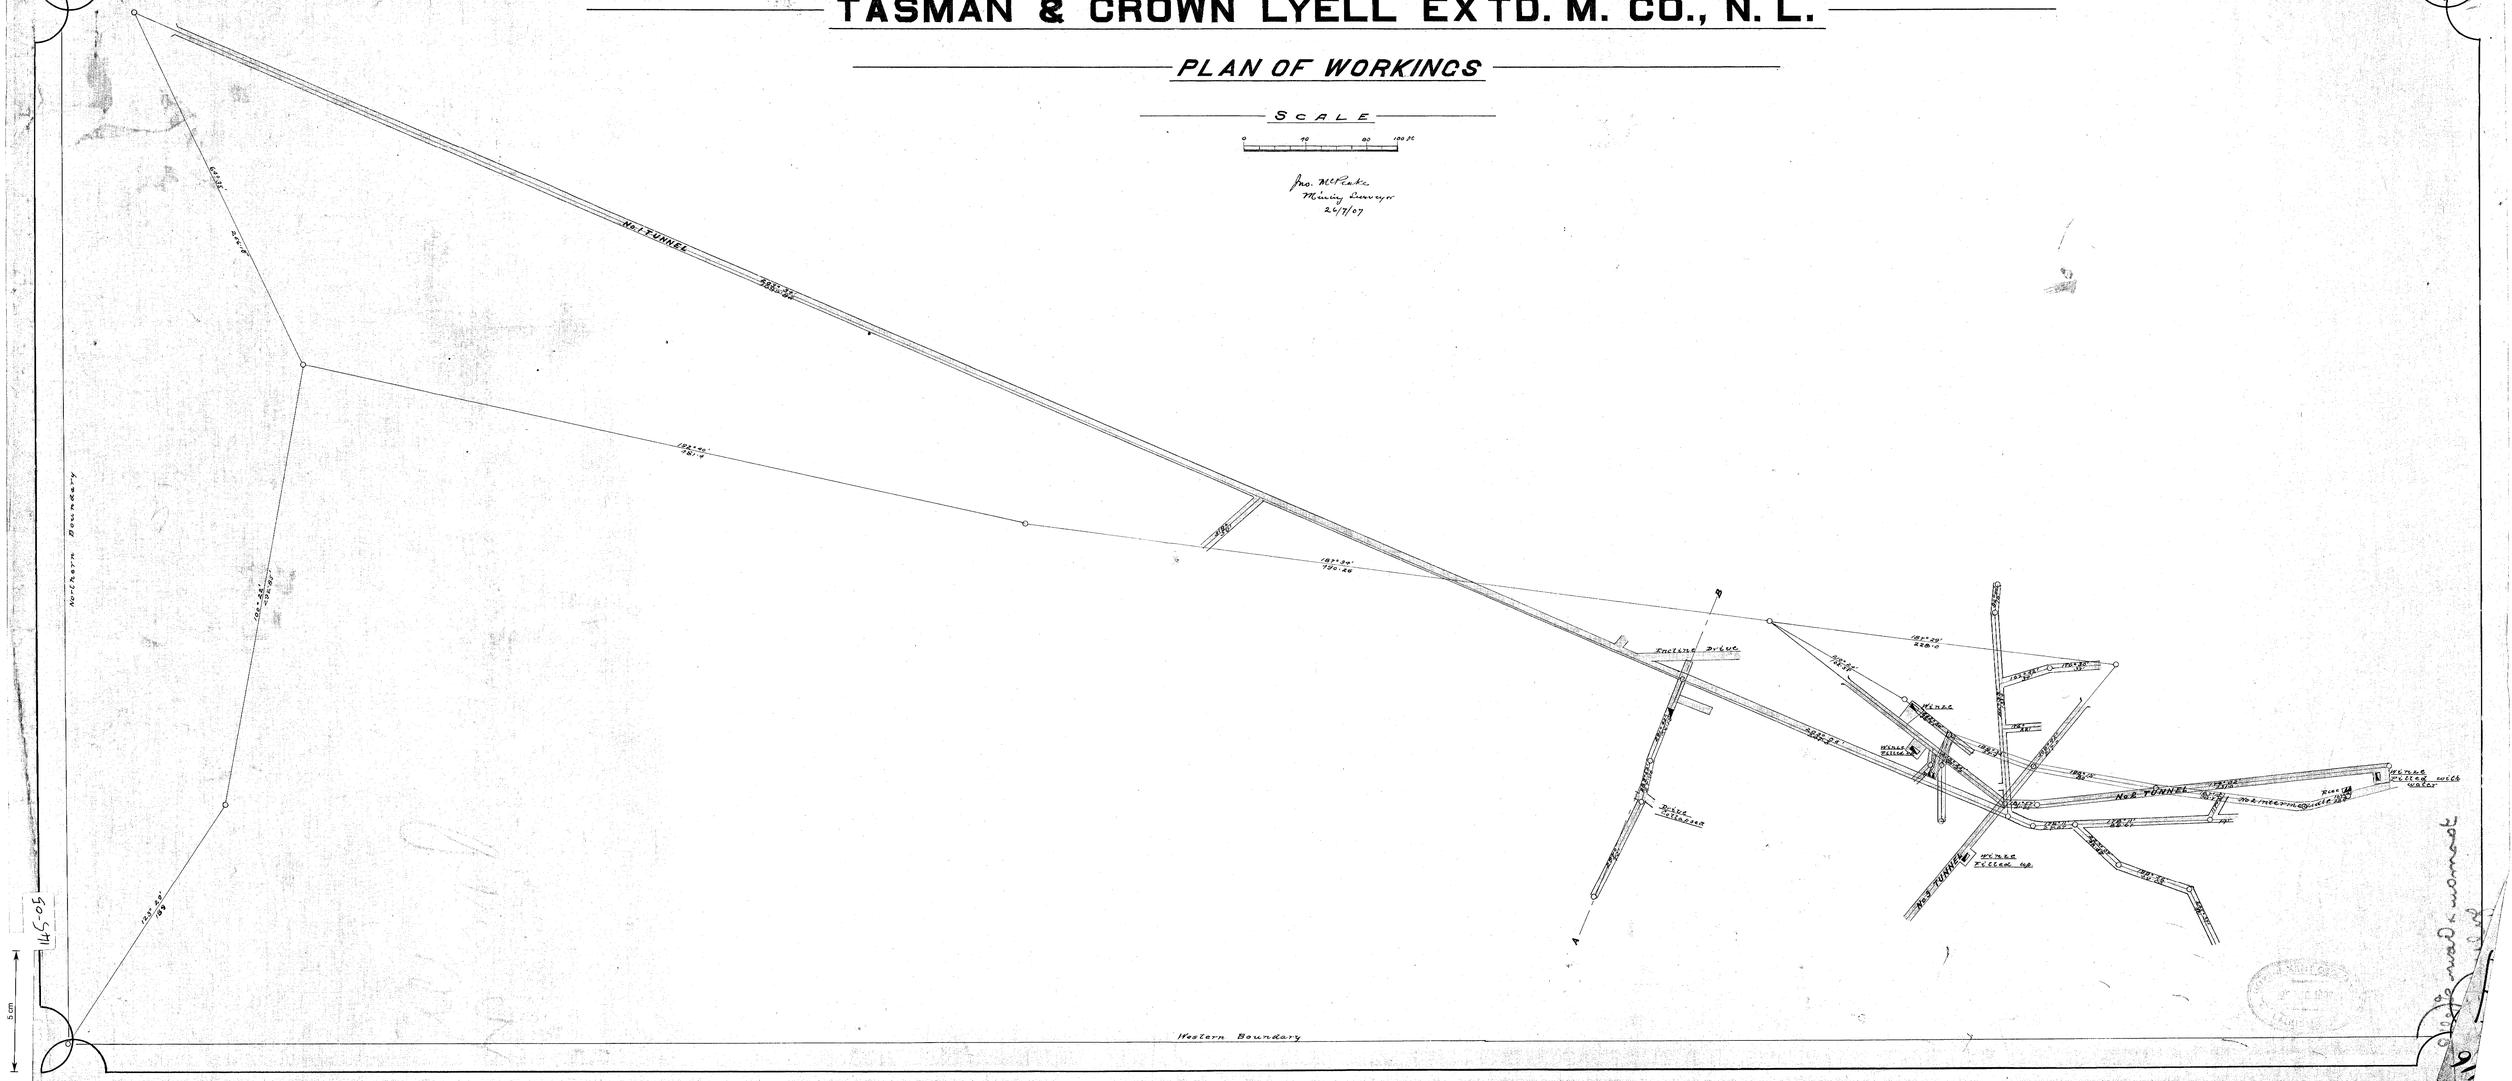
Jas. McPeake
Mining Surveyor
26/7/07