

rad. 100 ft  
ppst. 100 ft

MARIPOSA S M Cor No Liability



PLAN & CROSS SECTION

Scale  
Plan 25 feet to 1 inch Cross Section 40 feet to 1 inch



2415 87  
M  
40 acres

1410 87  
M  
40 acres

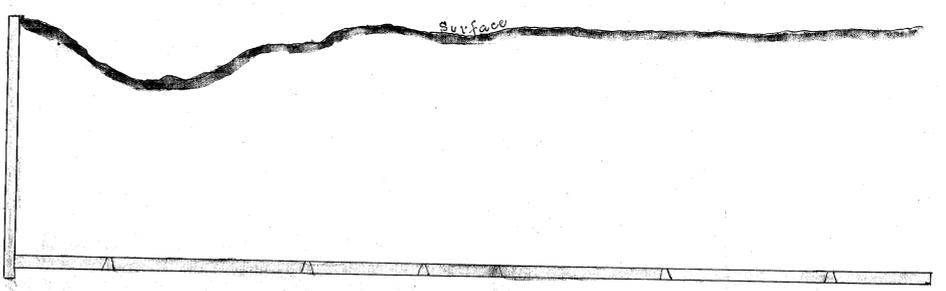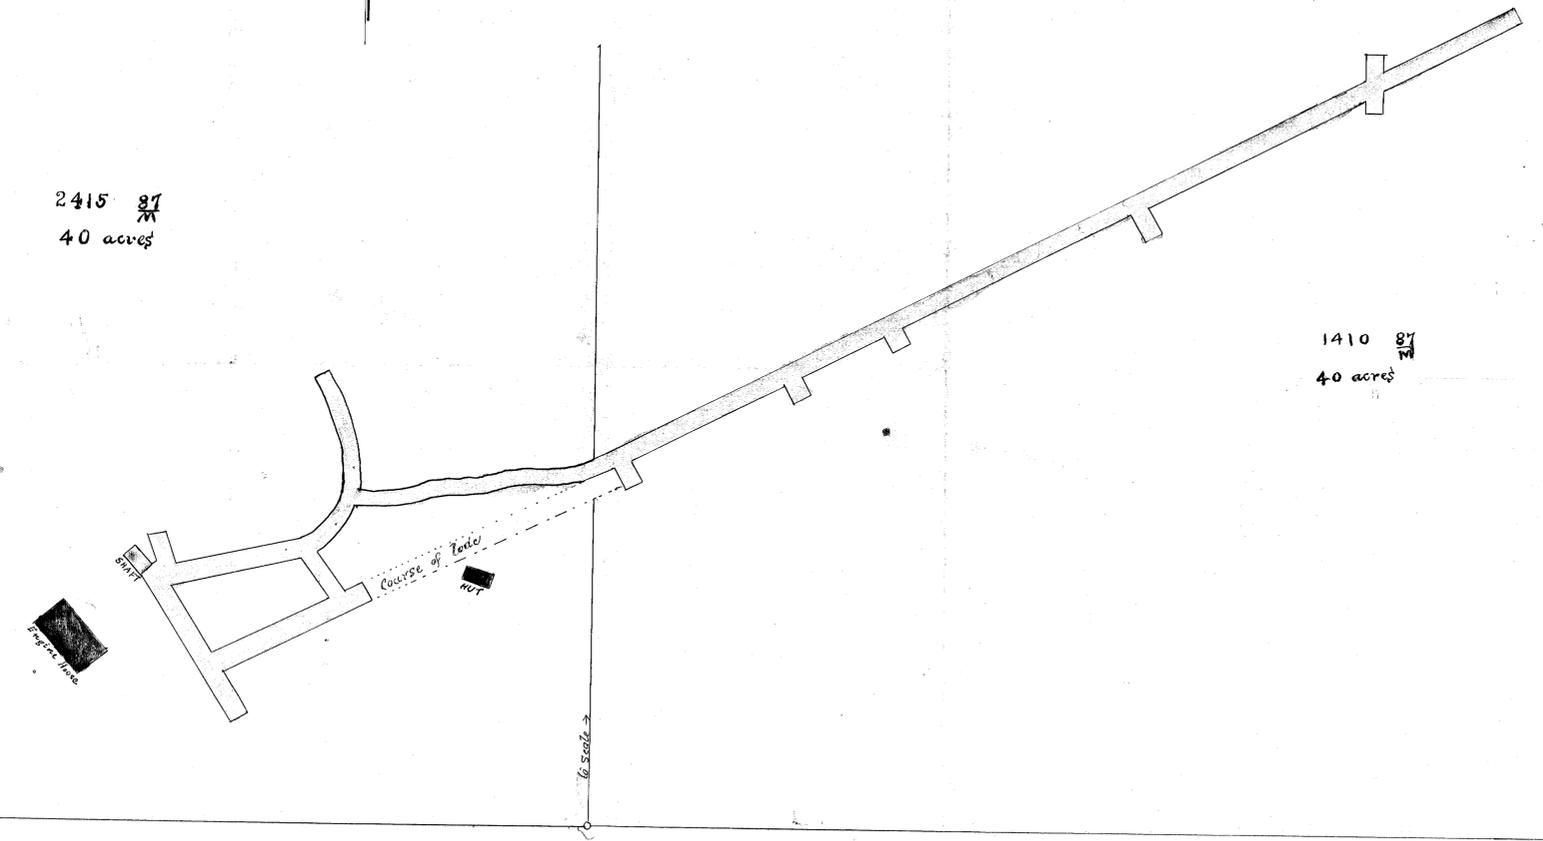

5 cm

109711

146

109711