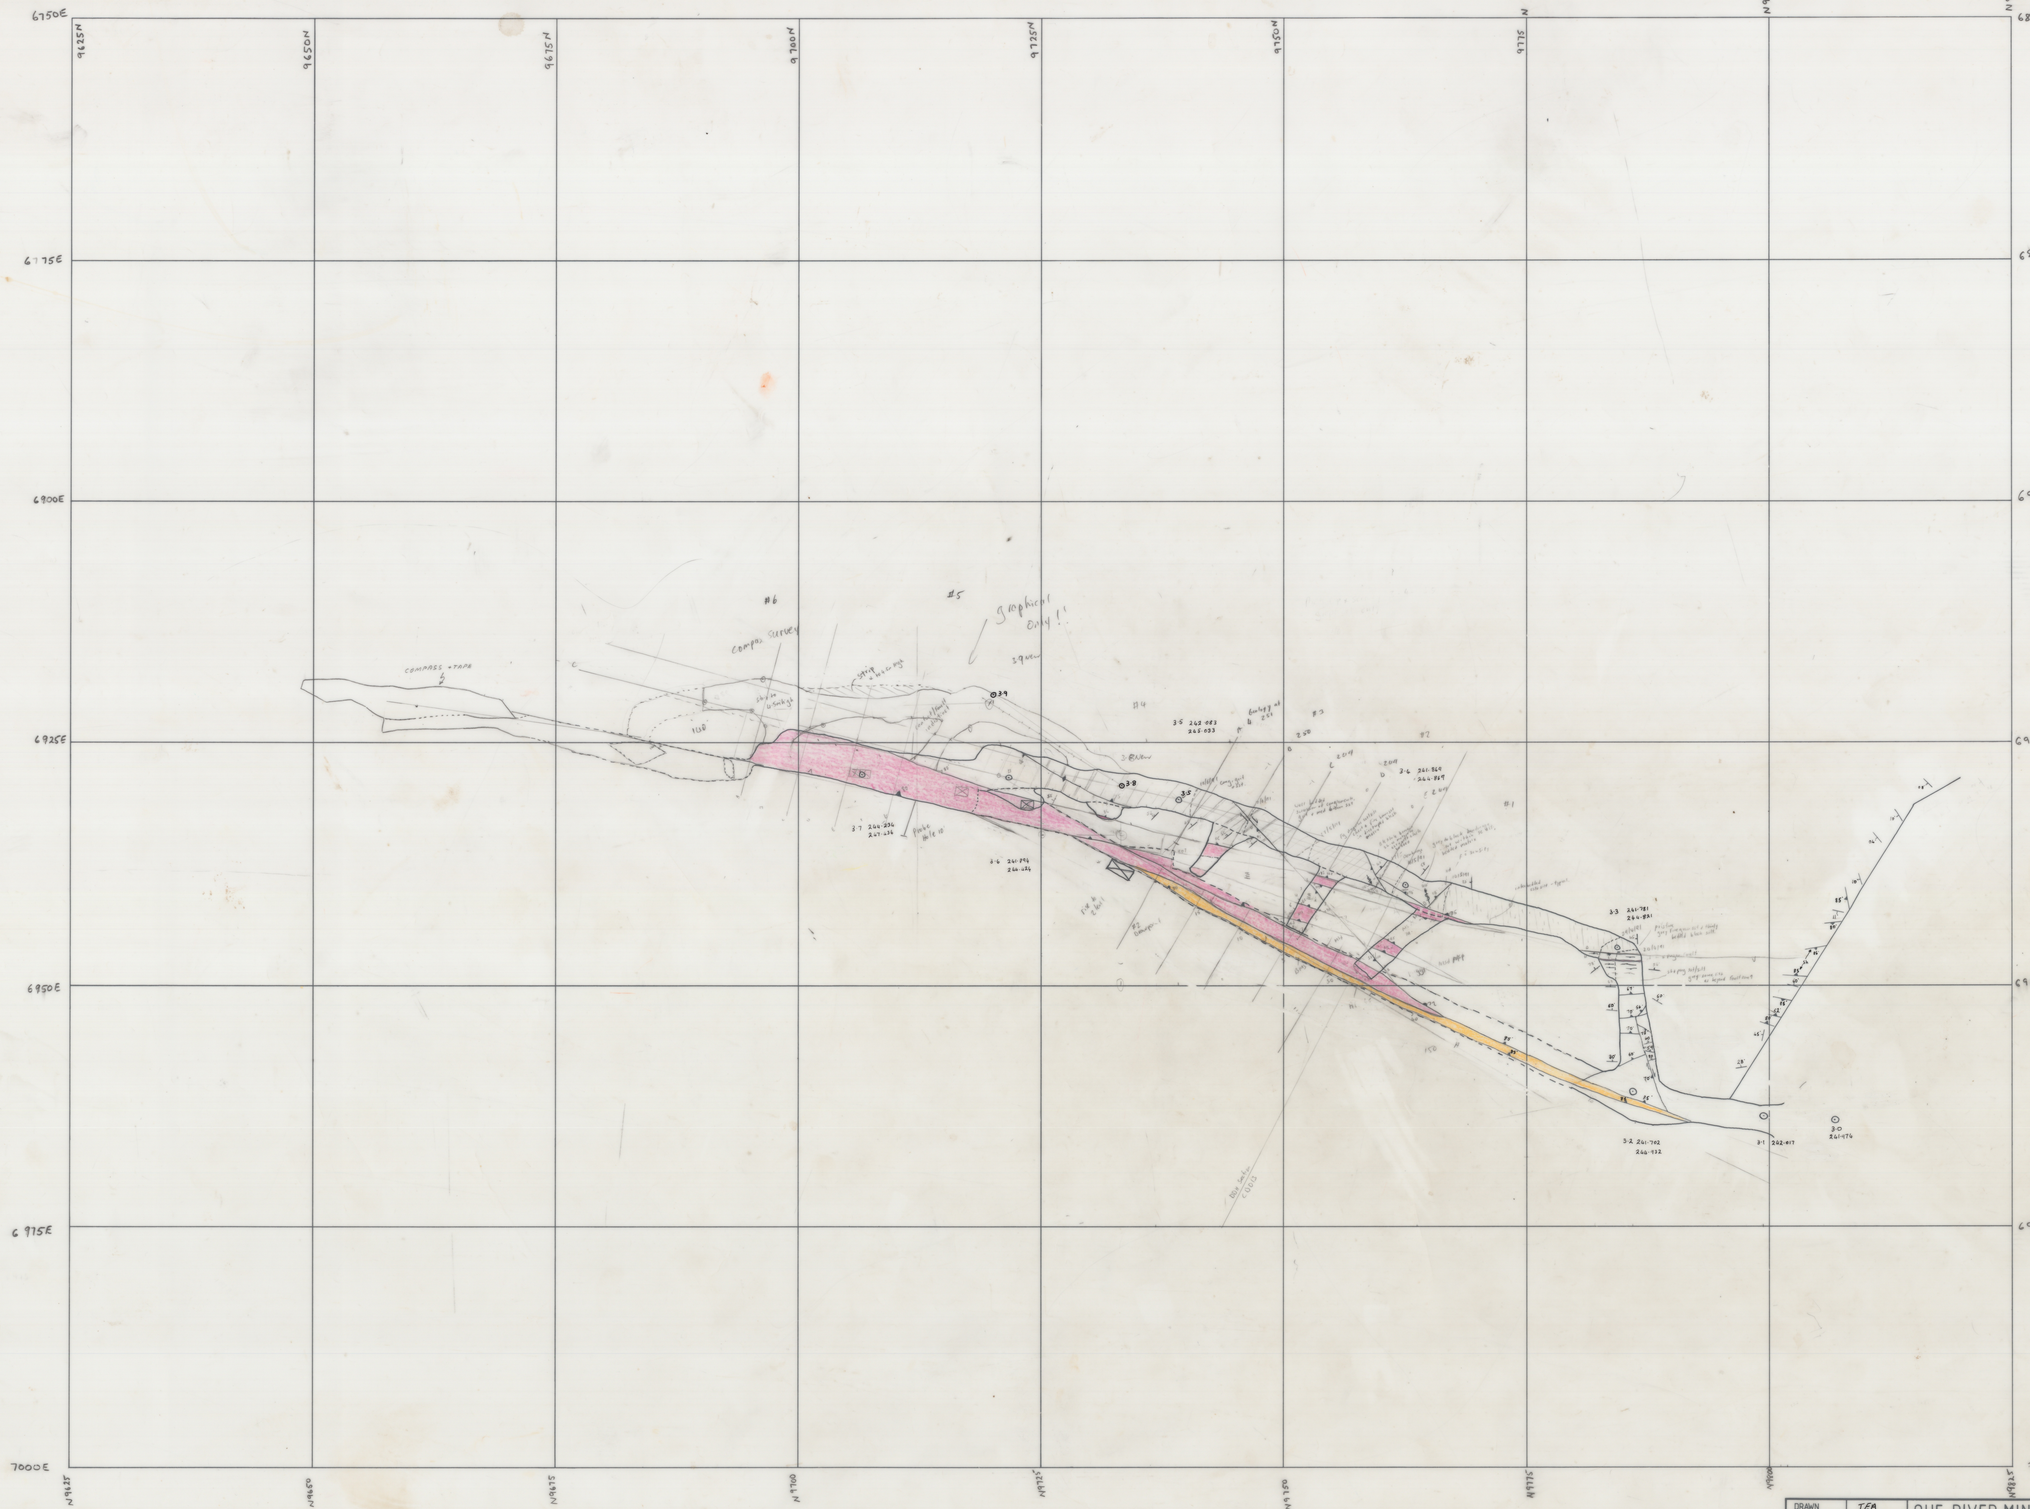

DRAWN	IEA	QUE RIVER MINING PTY. LTD.
TRACED		3 Level 263 RL
CHECKED		DRAWING No.
APPROVED		
SCALE 1:250	DATE 10/4/91	REVISION / SHEET

3 Level
1:250
RL = 263

3 Level
1:250

0154-
022