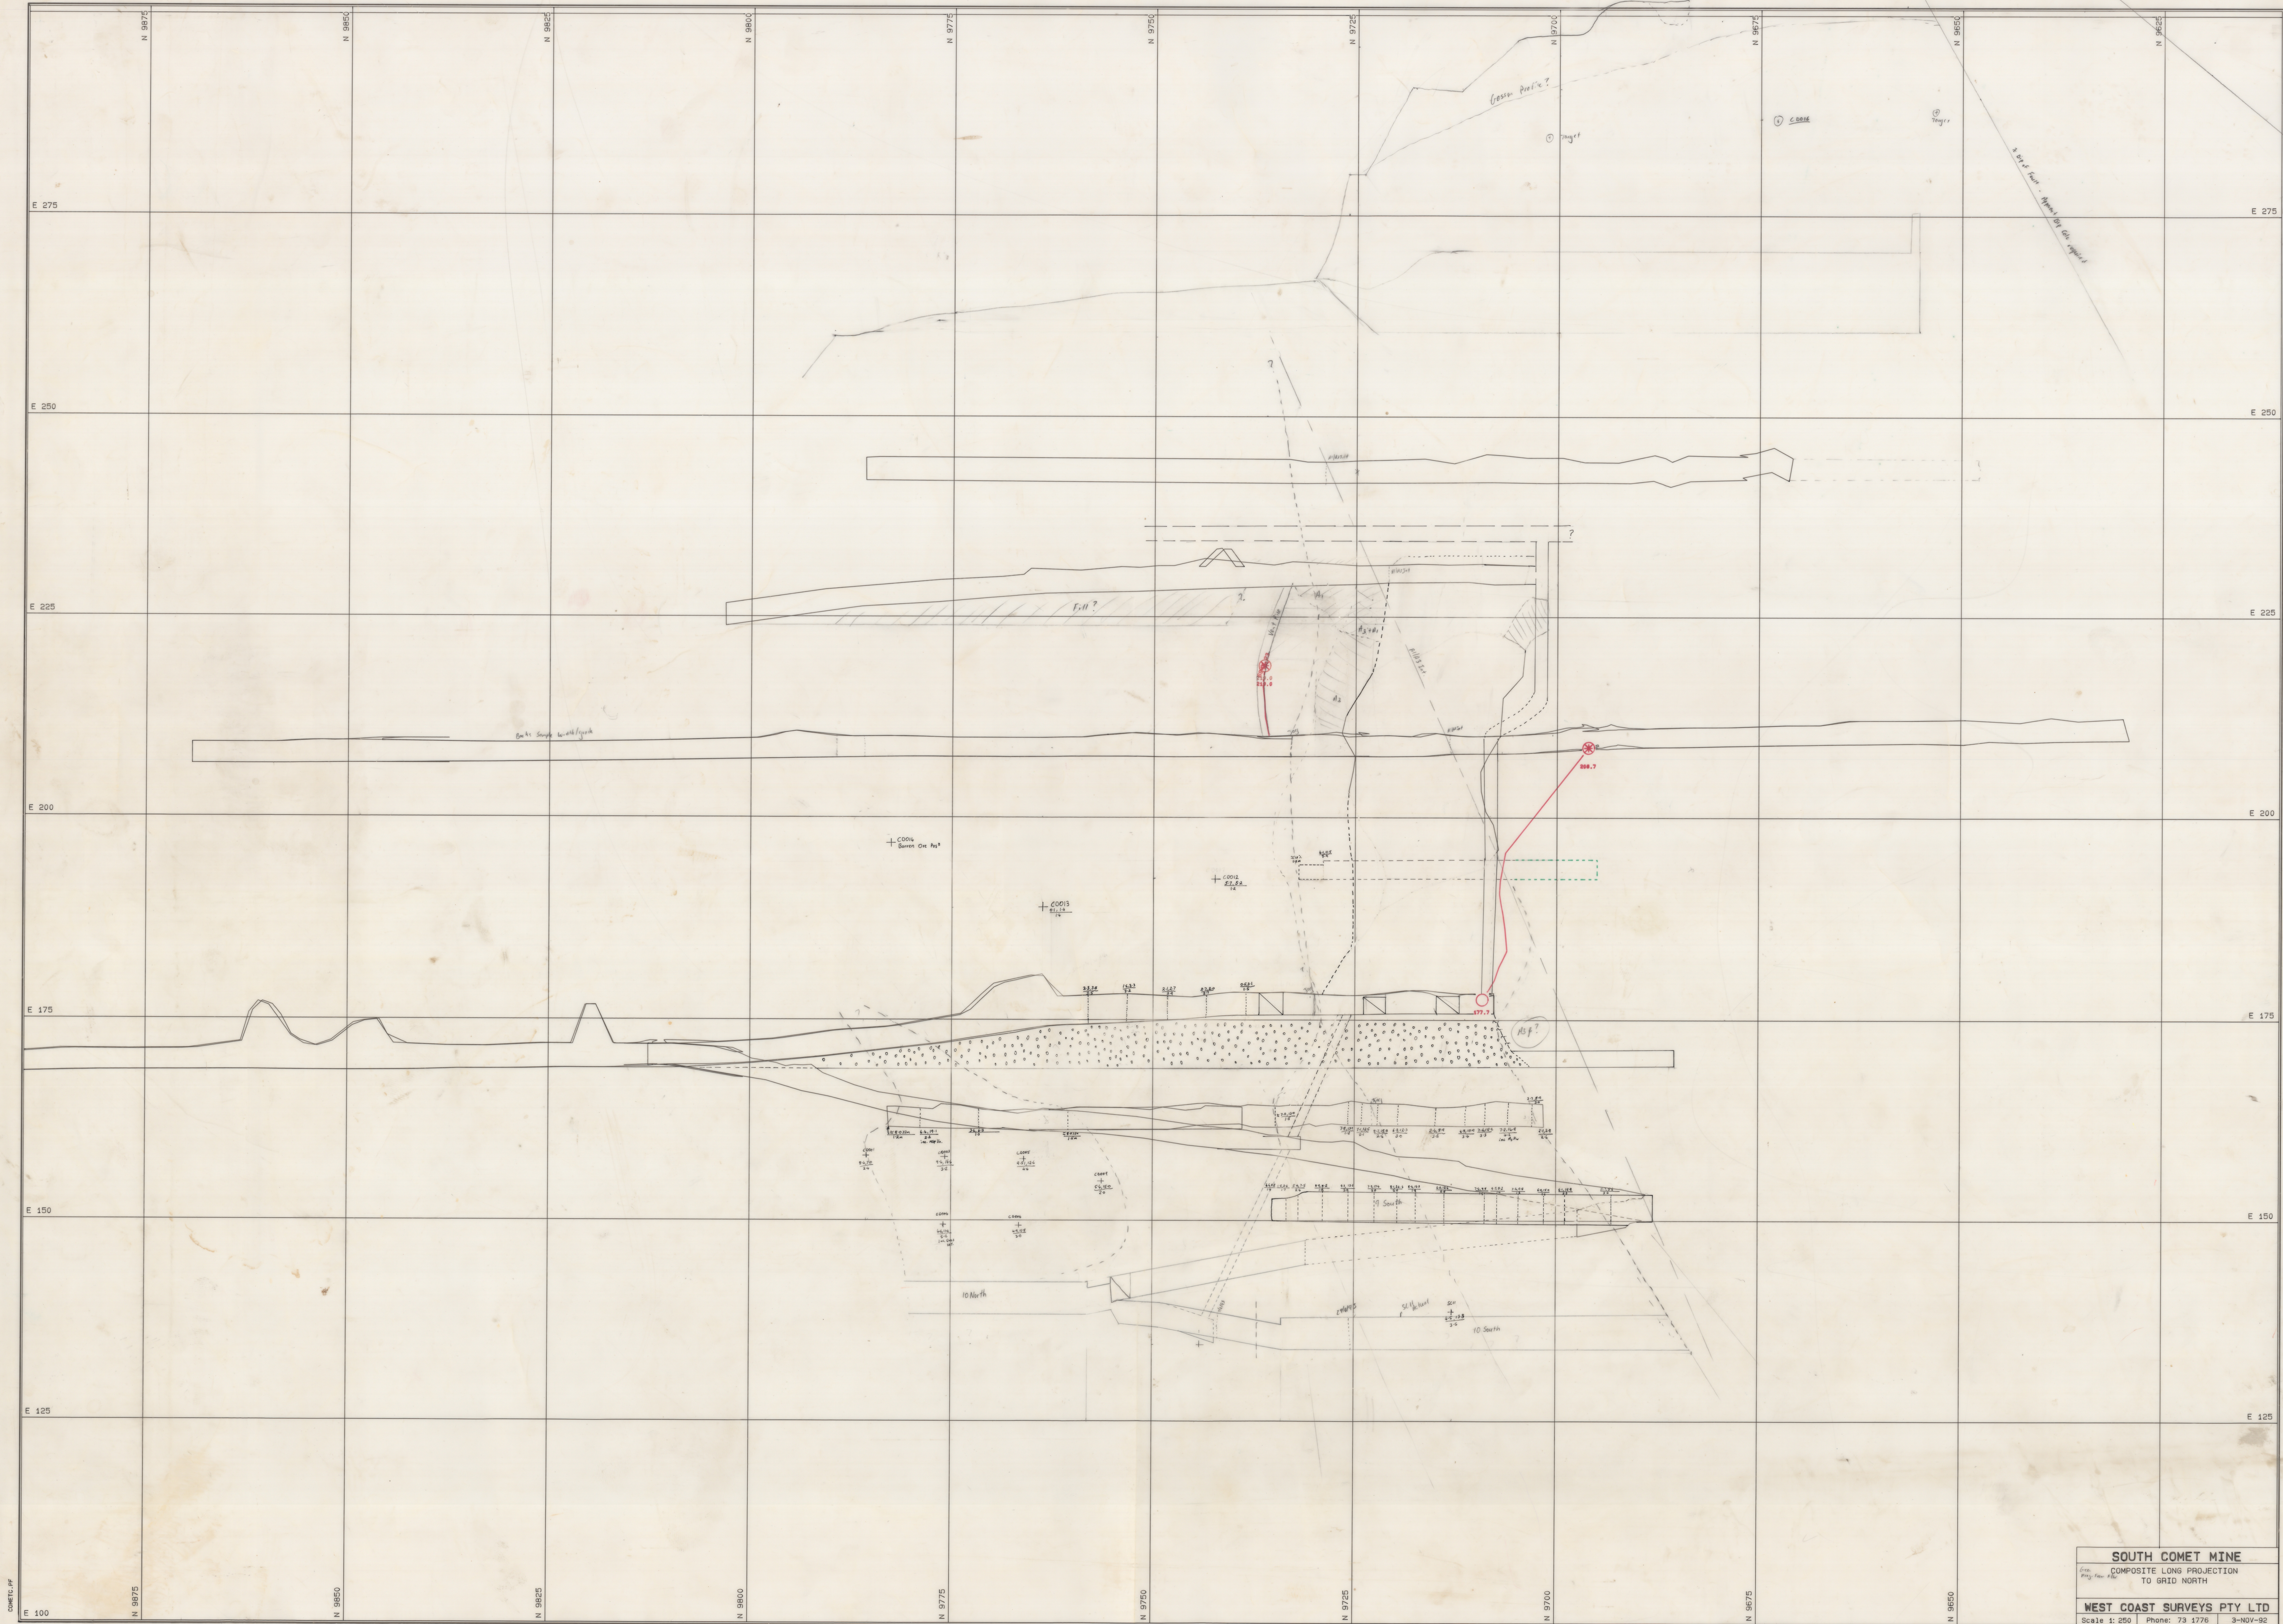


1:250 SOUTH COMET MINE COMPOSITE LONG PROJECTION 0154-045