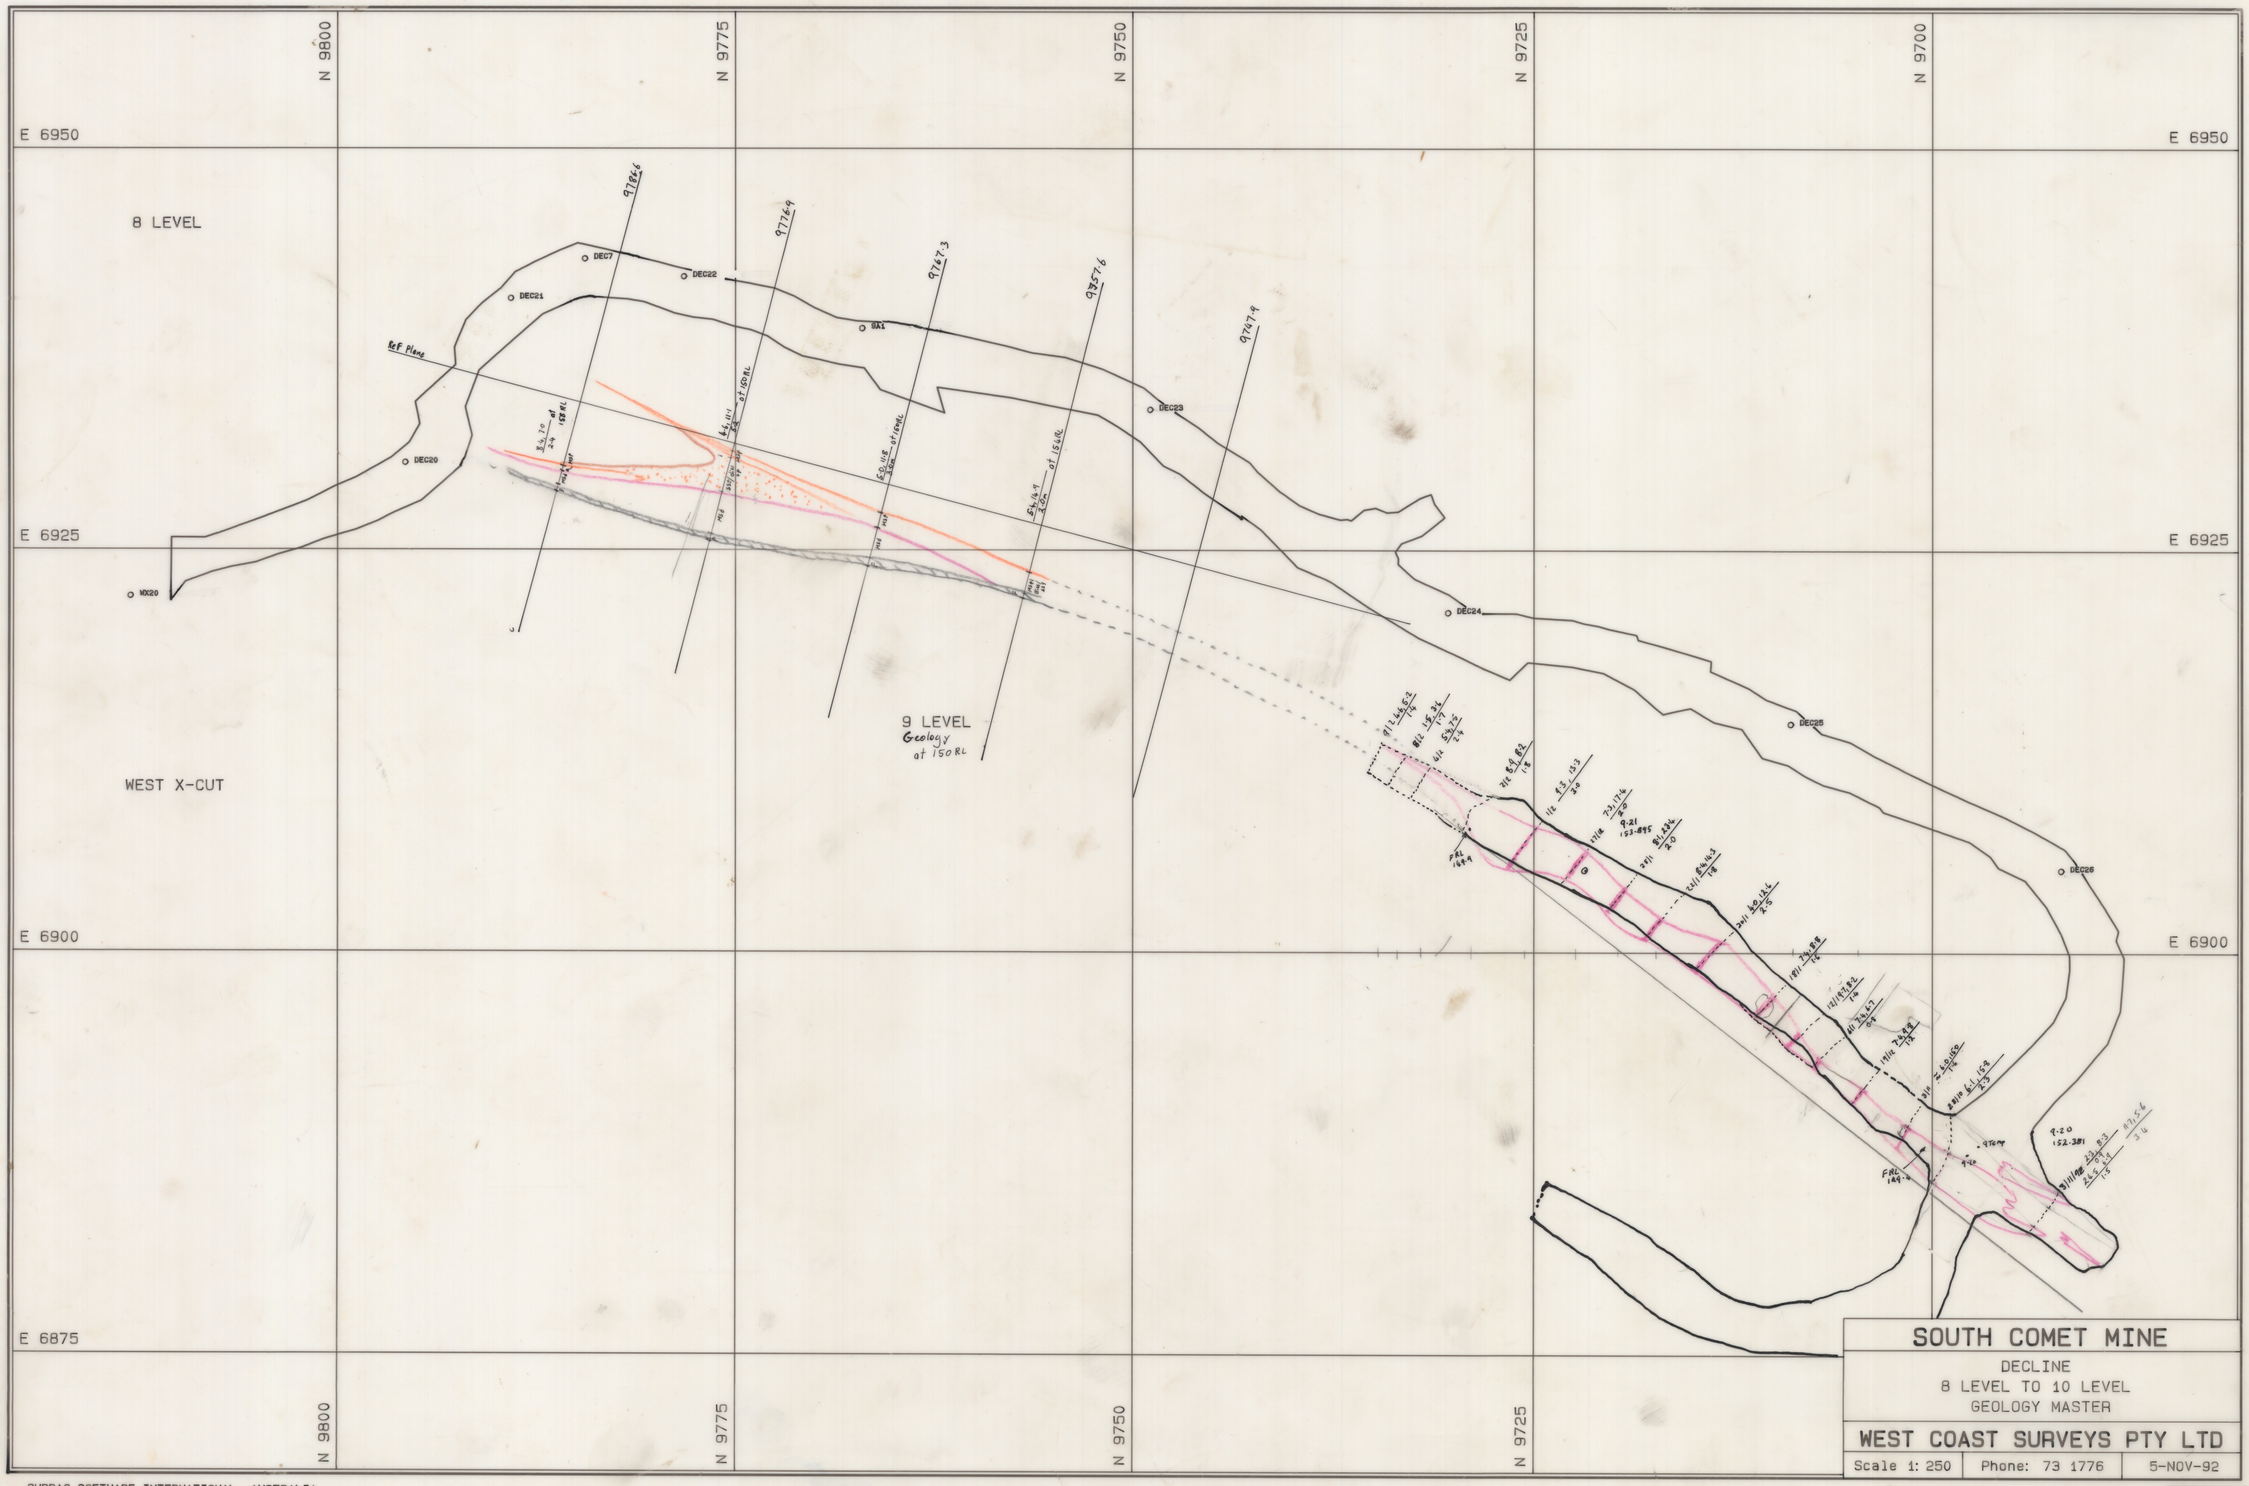

5 cm

1:250

SOUTH COMET MINE

DECLINE GEOL. MASTER

0154-054