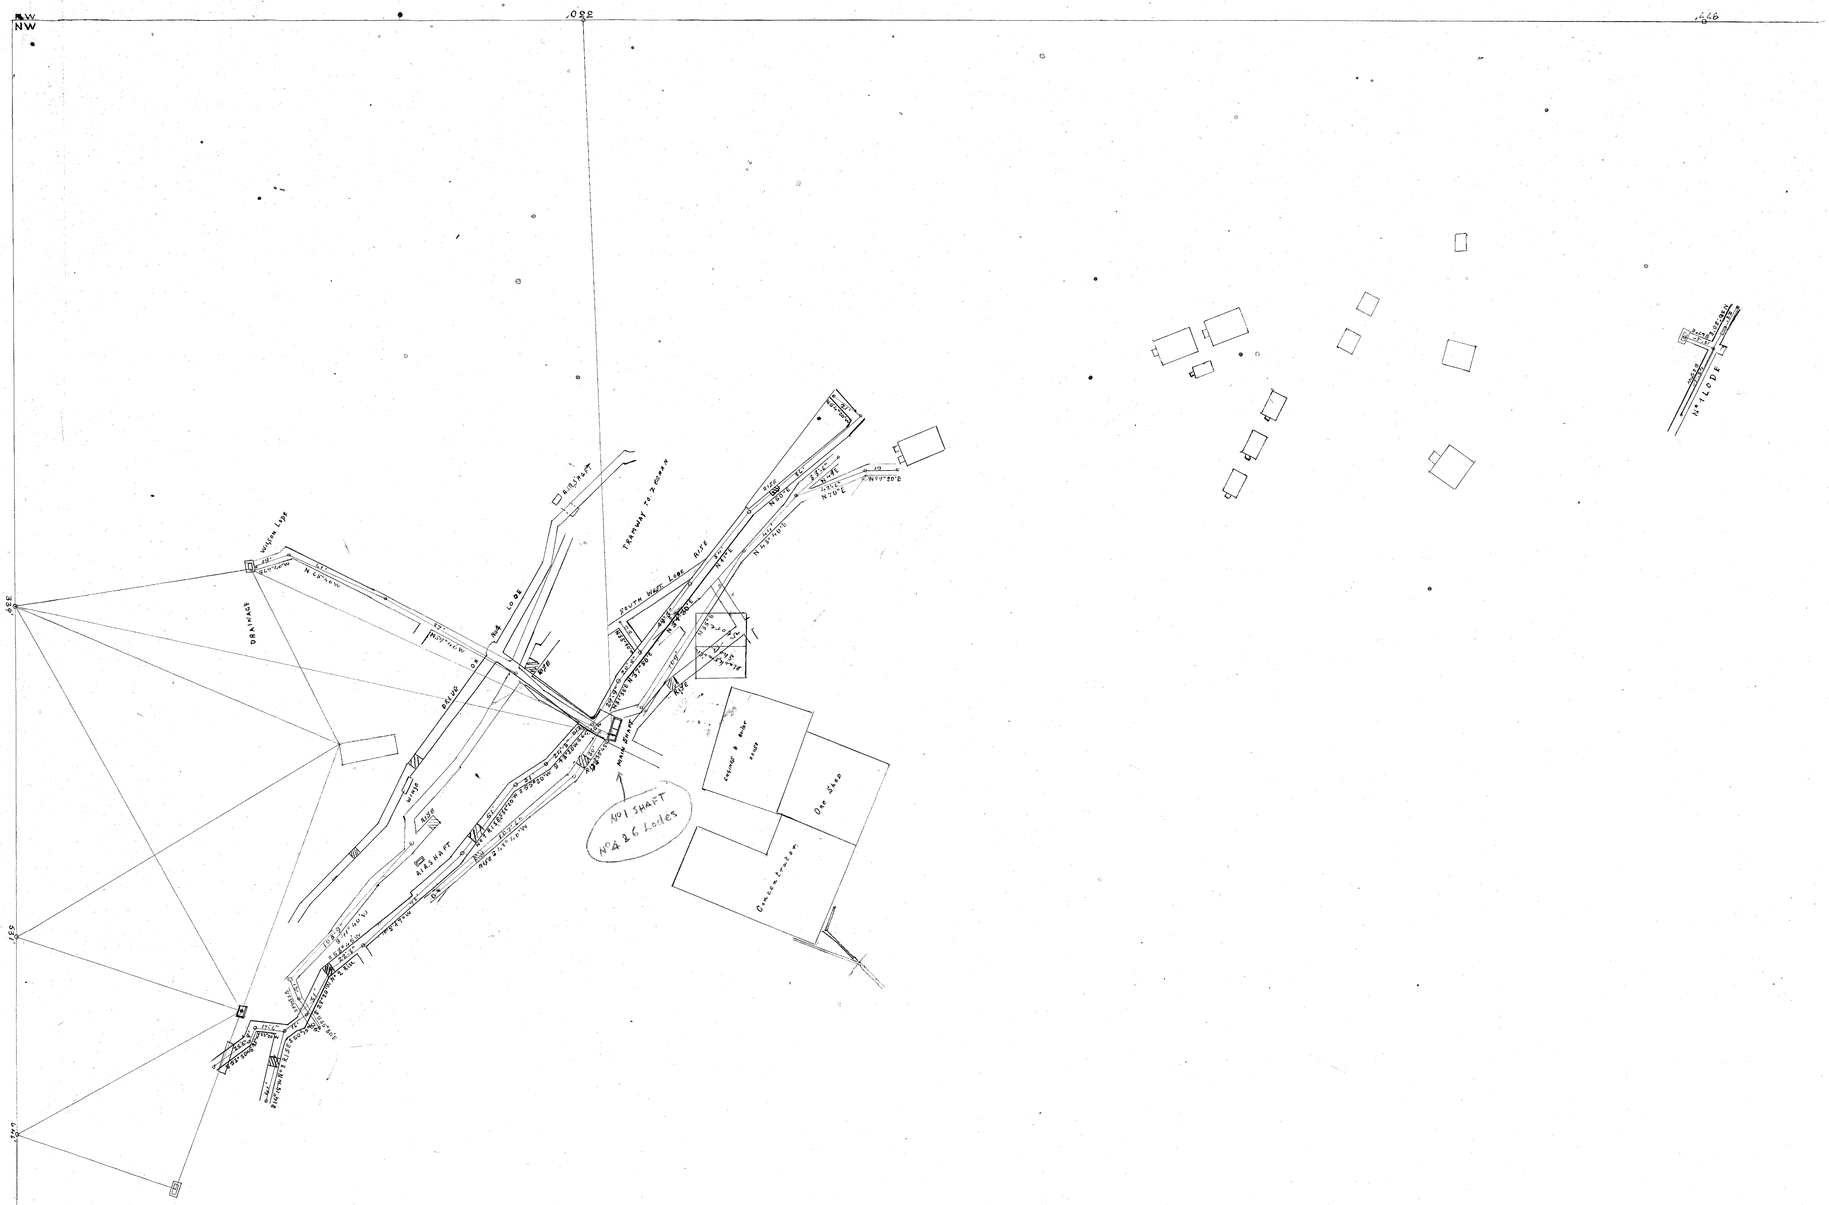

THE MOUNT ZEEHAN
(TAS.) SILVER LEAD MINES LIMD
ARGENT SECTION No 2.

SCALE 30 FEET TO 1 INCH

1893 Jul 22nd

155-14

5 cm

155-14

H Bennett 21/1/95