155-15

Mt ZEEHAN (TAS) S.L.M.

ARGENT SECTION

MINING WORKS

Scale 30 feet to an inch

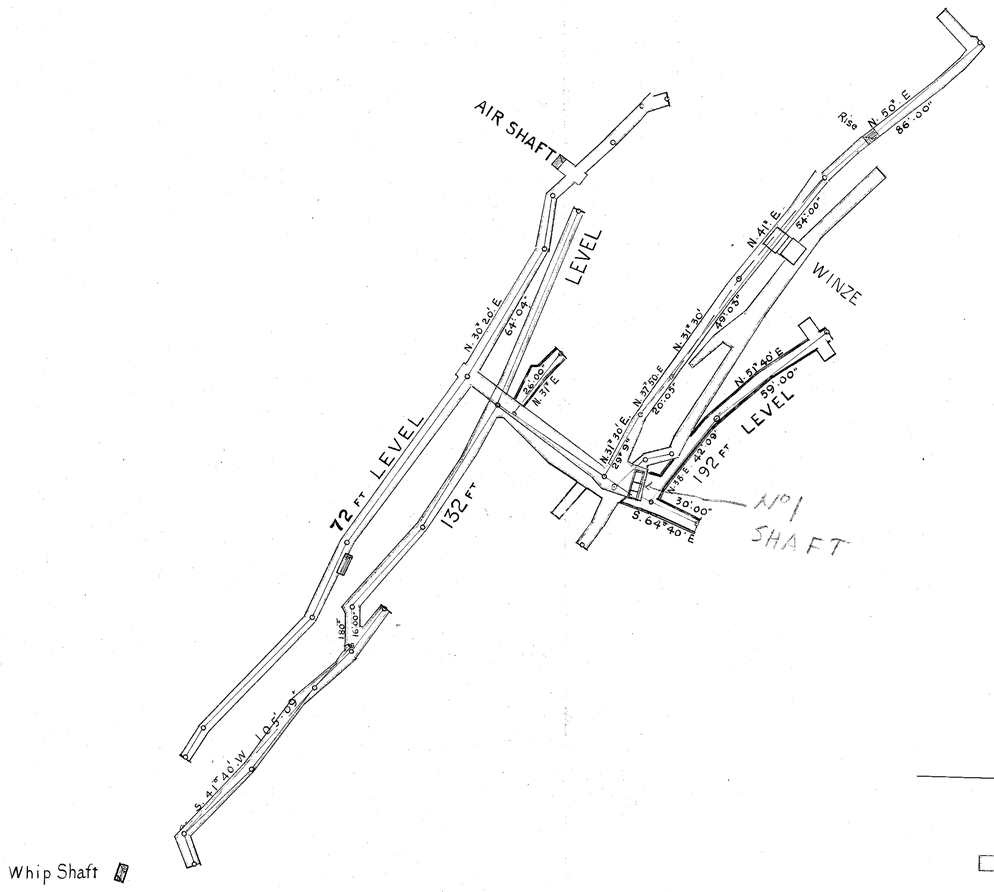

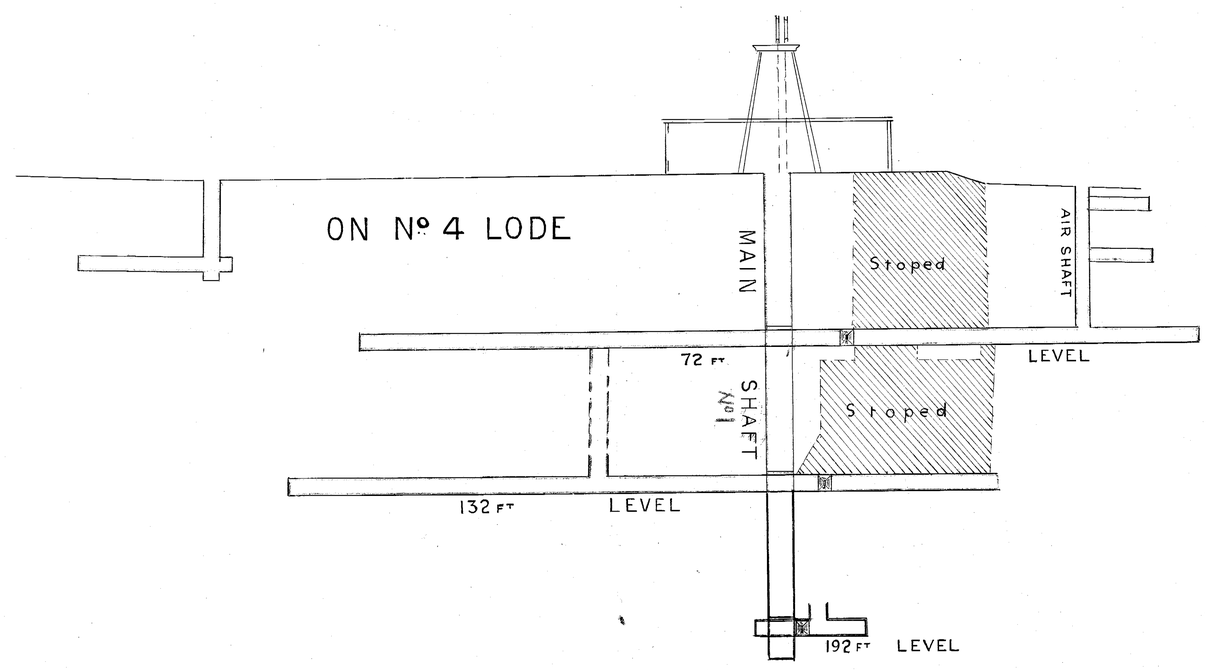

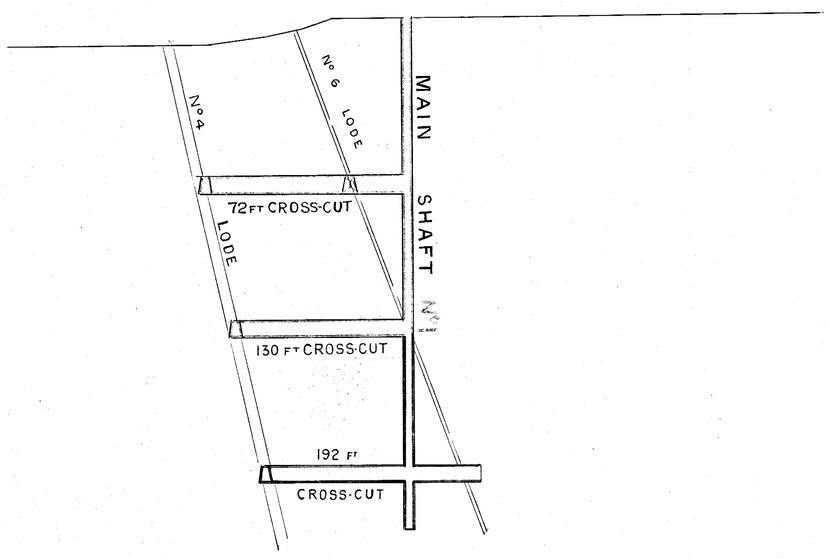

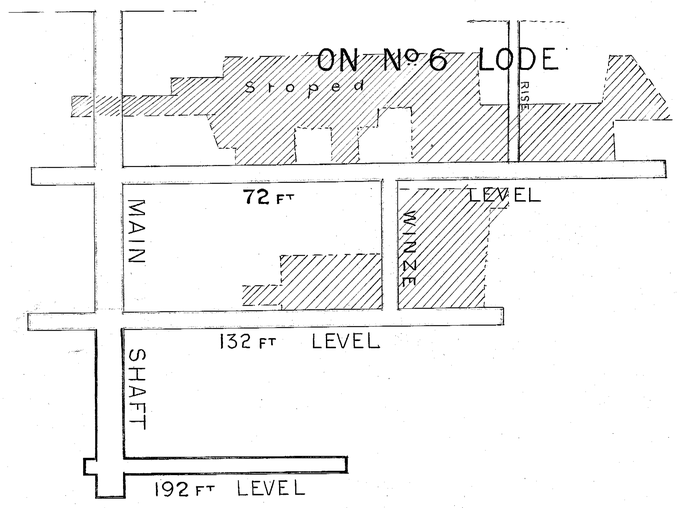

Clutsloper
Asst Sur
Del.
Zeehan Jan