
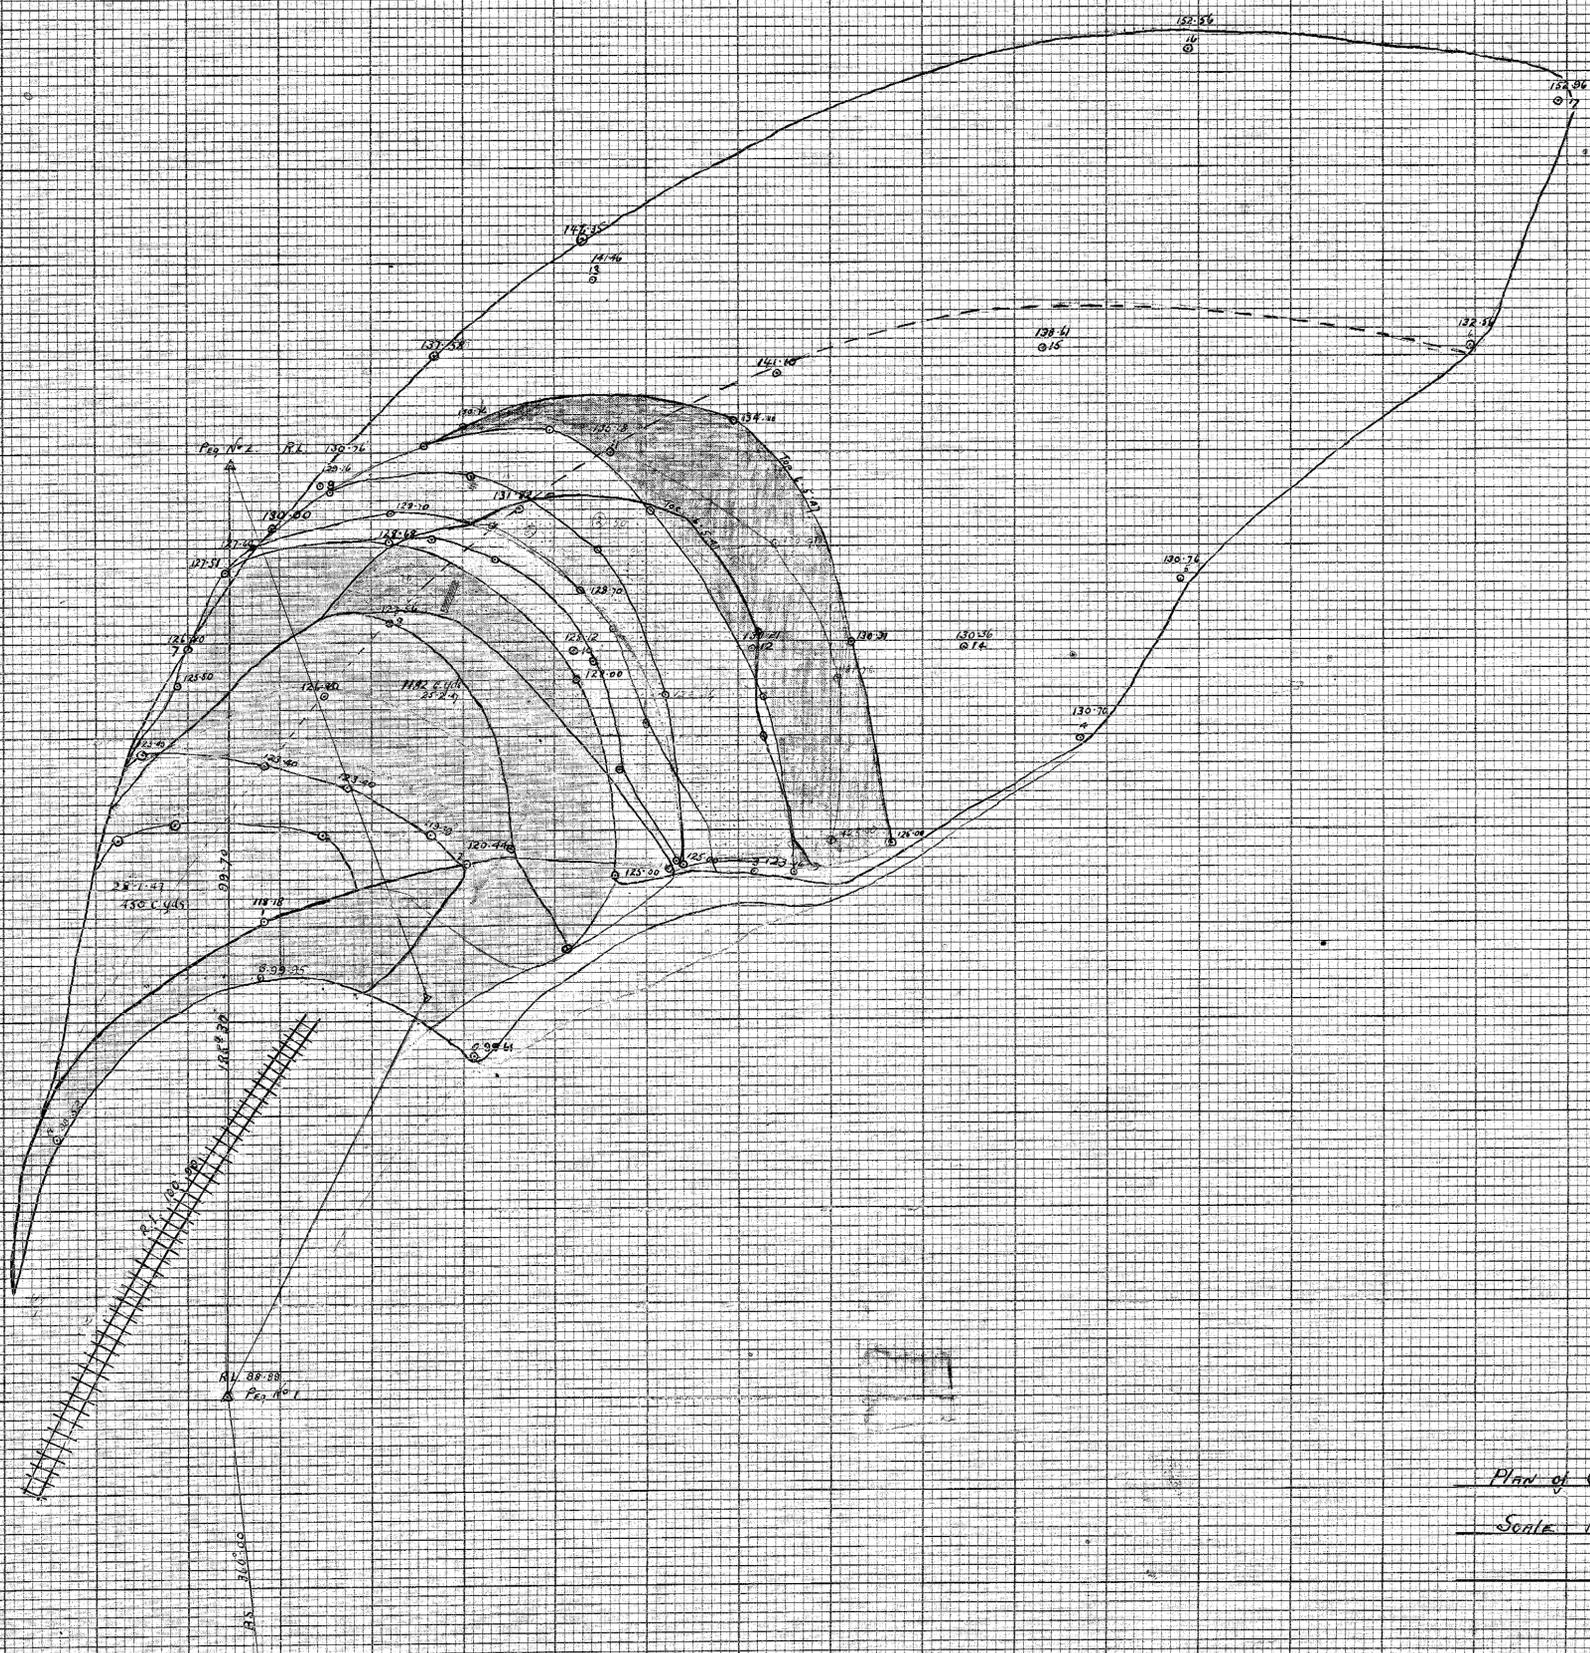


155-20

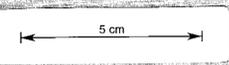

Plan of Overburden GREEN DEVELOPMENT  
 Scale 10" = 1" DATE 20-1-47