Complete resurvey. Permanent marks used by T.F. Muir for 1899 Survey not being available – vide memo attached to field notes. K.S.B. 18 May 1900

—Copper Mines OF Mt Lyell West—

—Underground Survey 1899—

—Scale–25 Feet to 1 Inch—
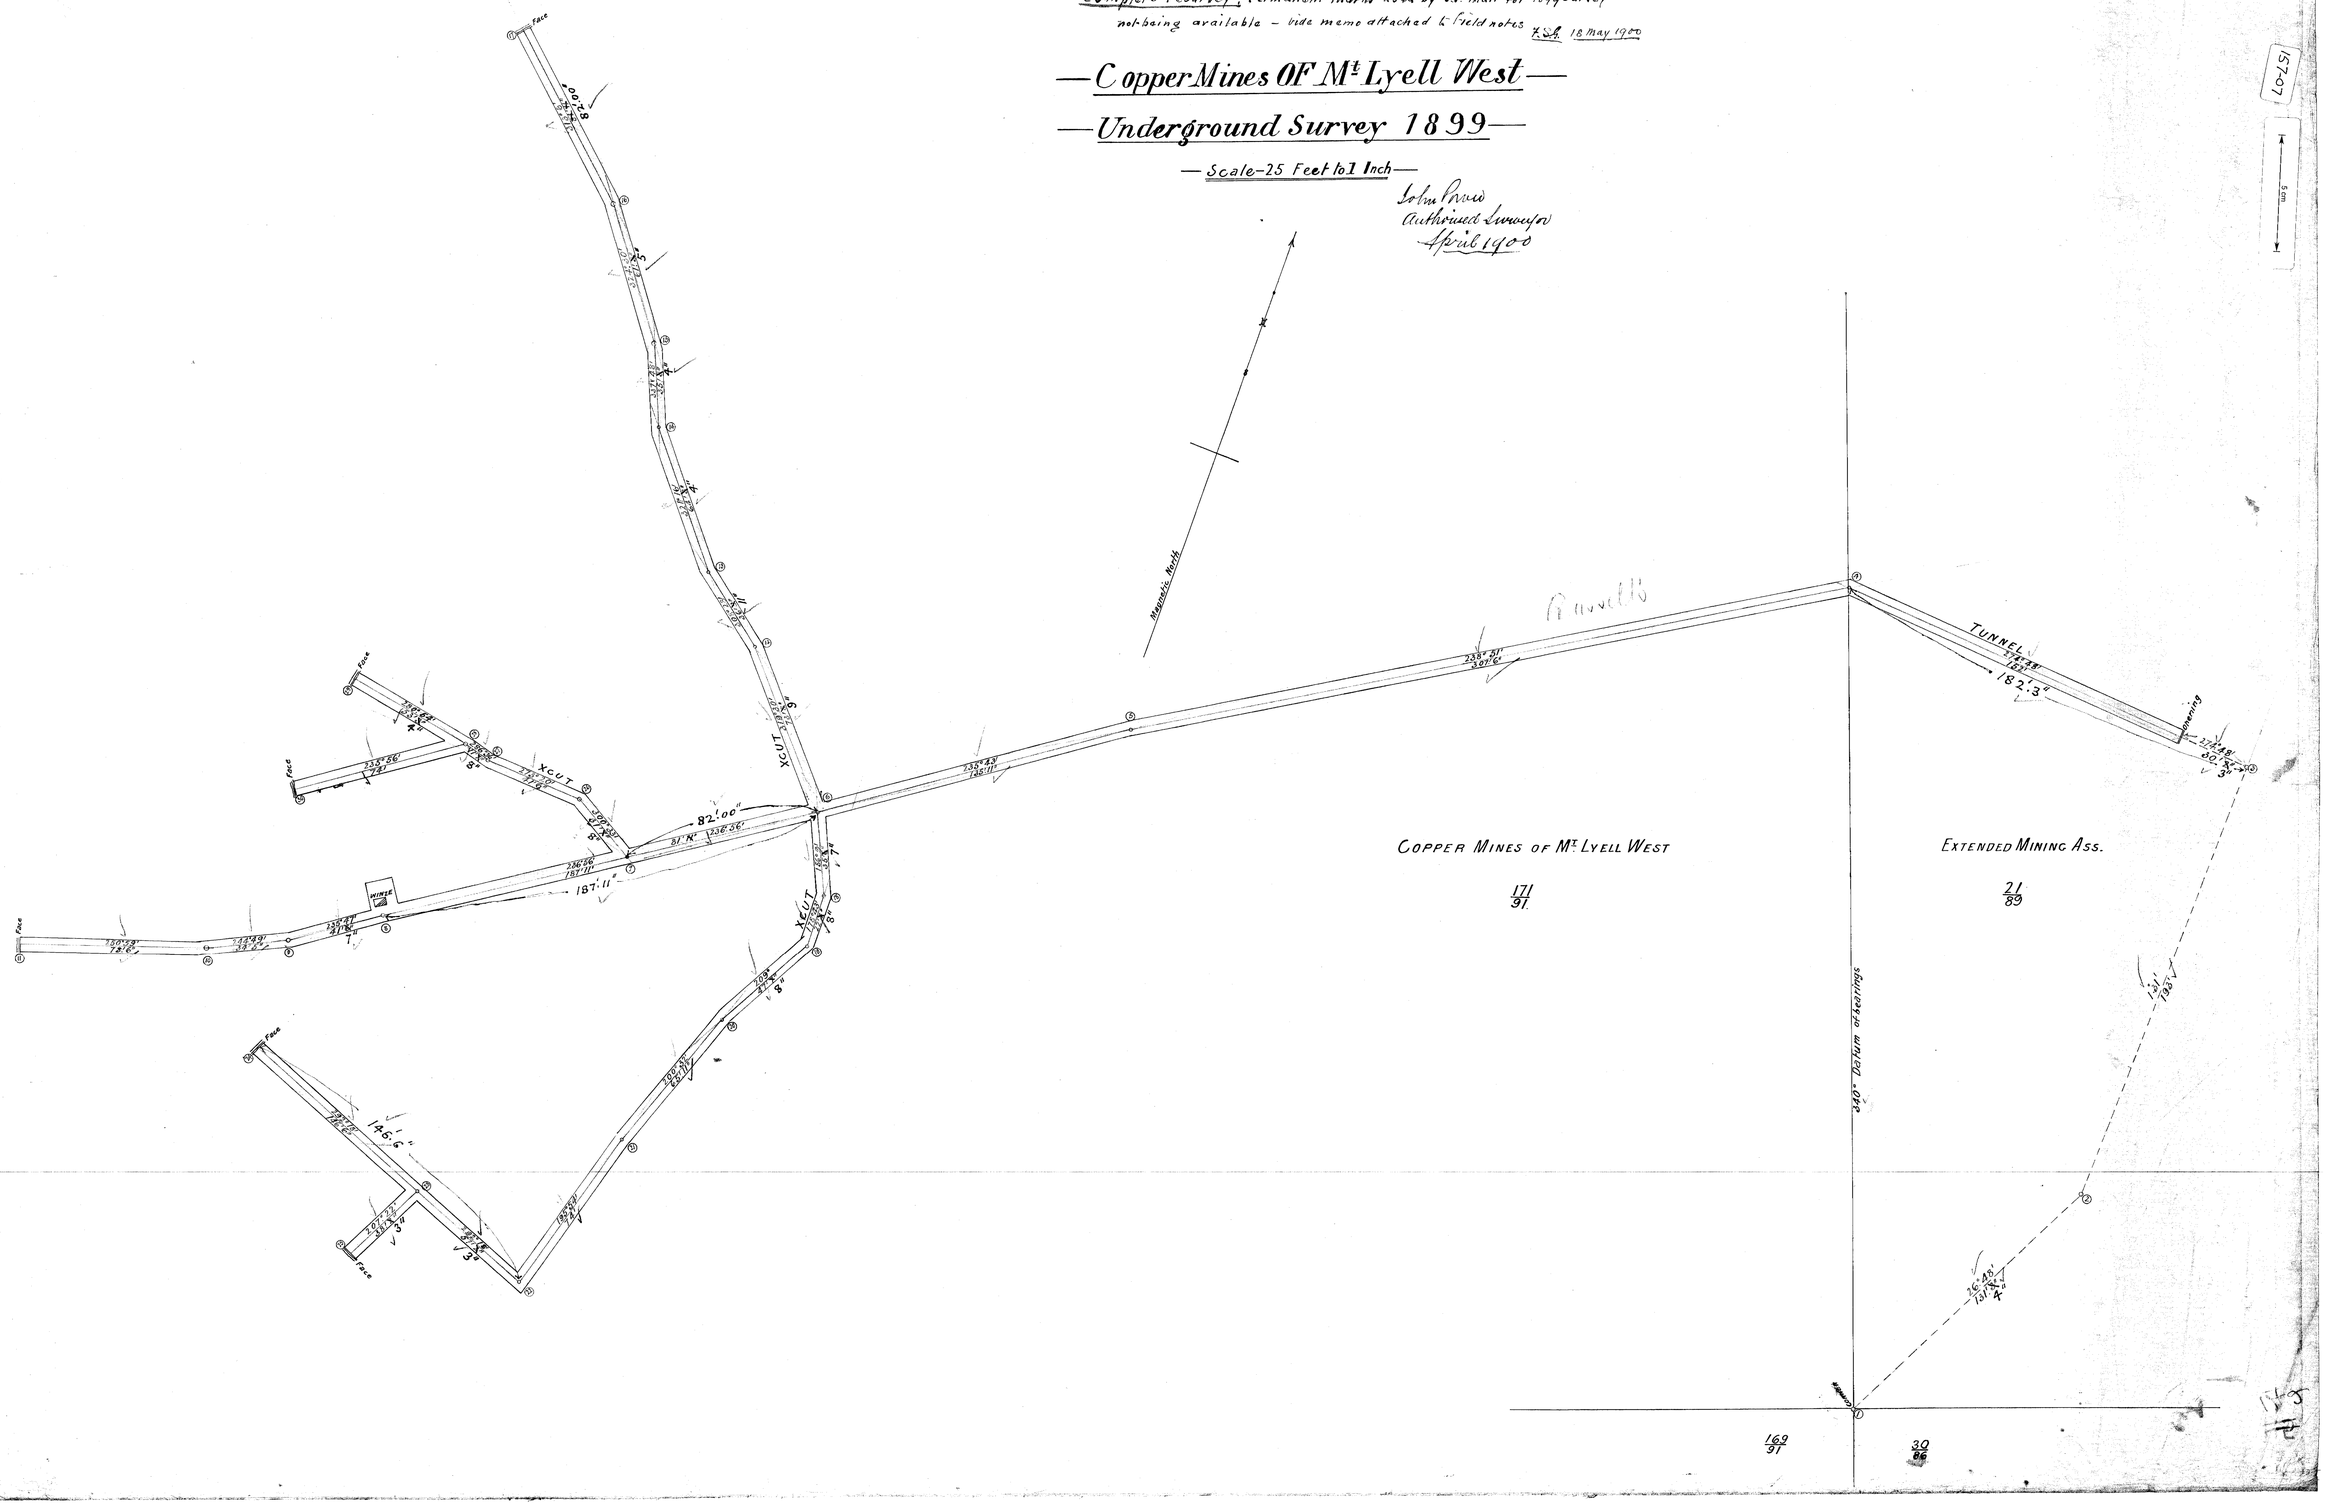
John Prud
Authorised Surveyor
April 1900