


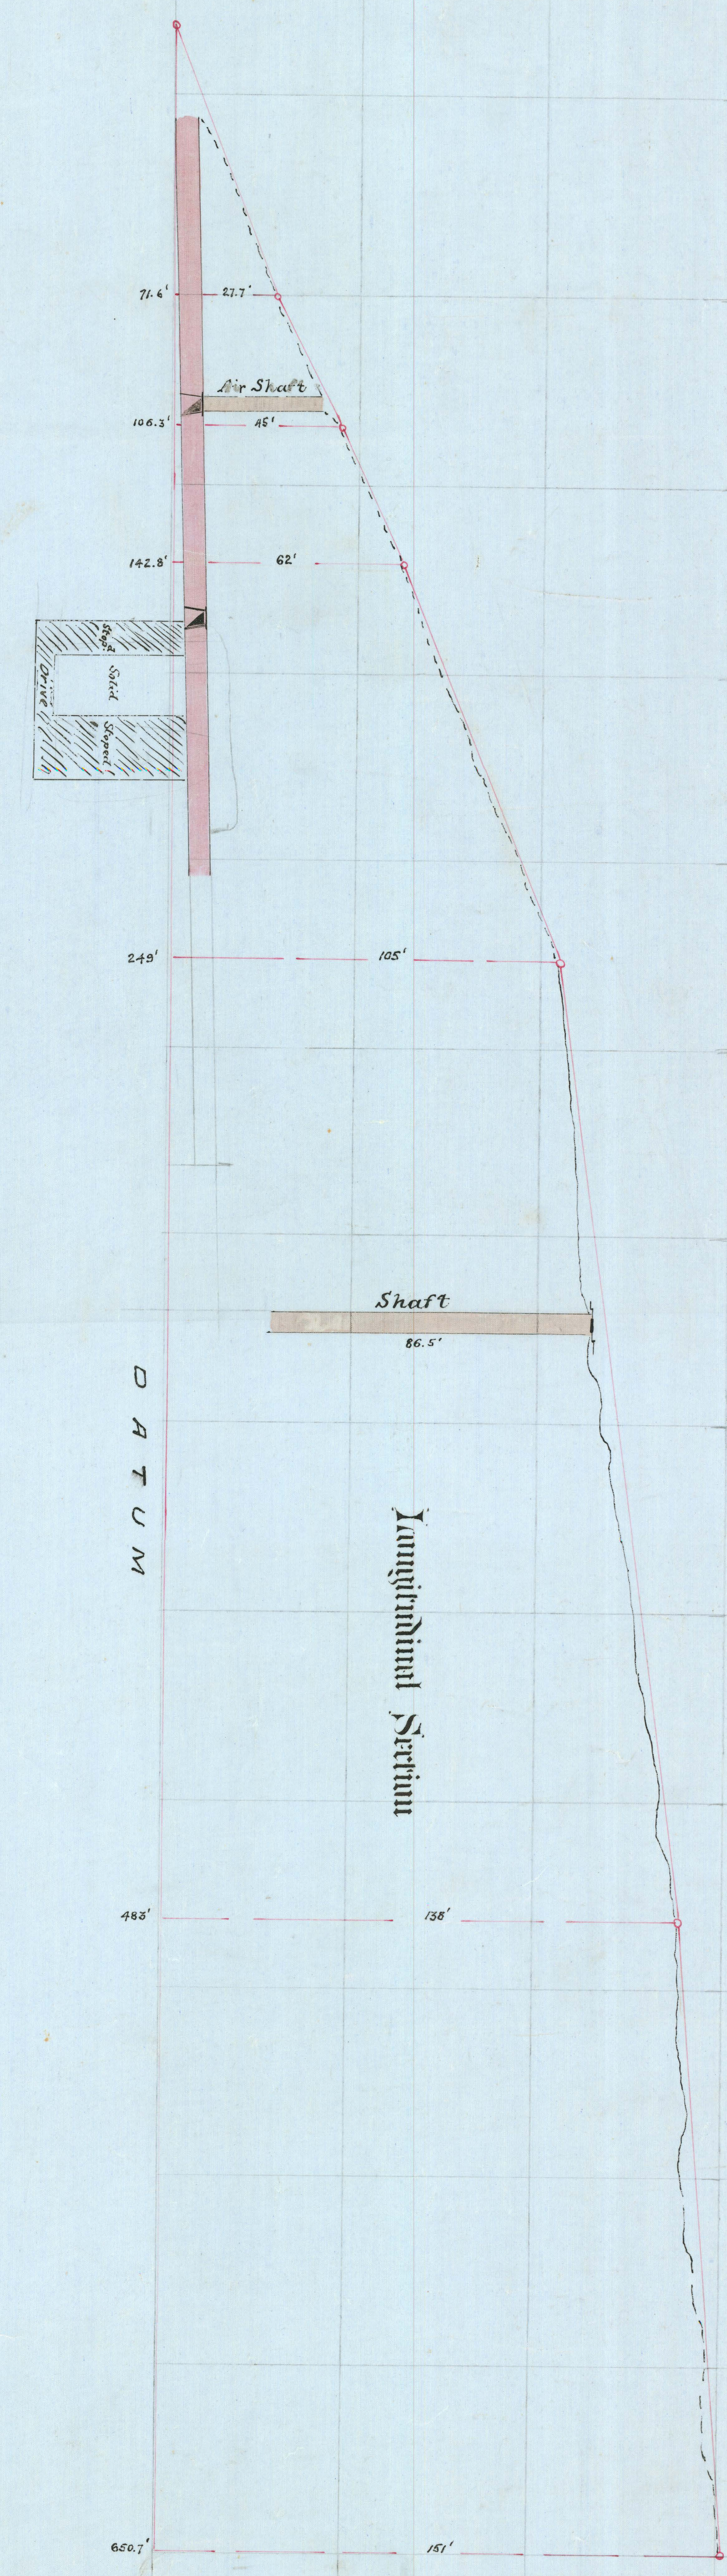

INSPECTOR OF MINES
6 APR 1904