WASHINGTON EXTENDED . S. M. Co

WHYTE RIVER

Scale 50 feet to one inch

1893

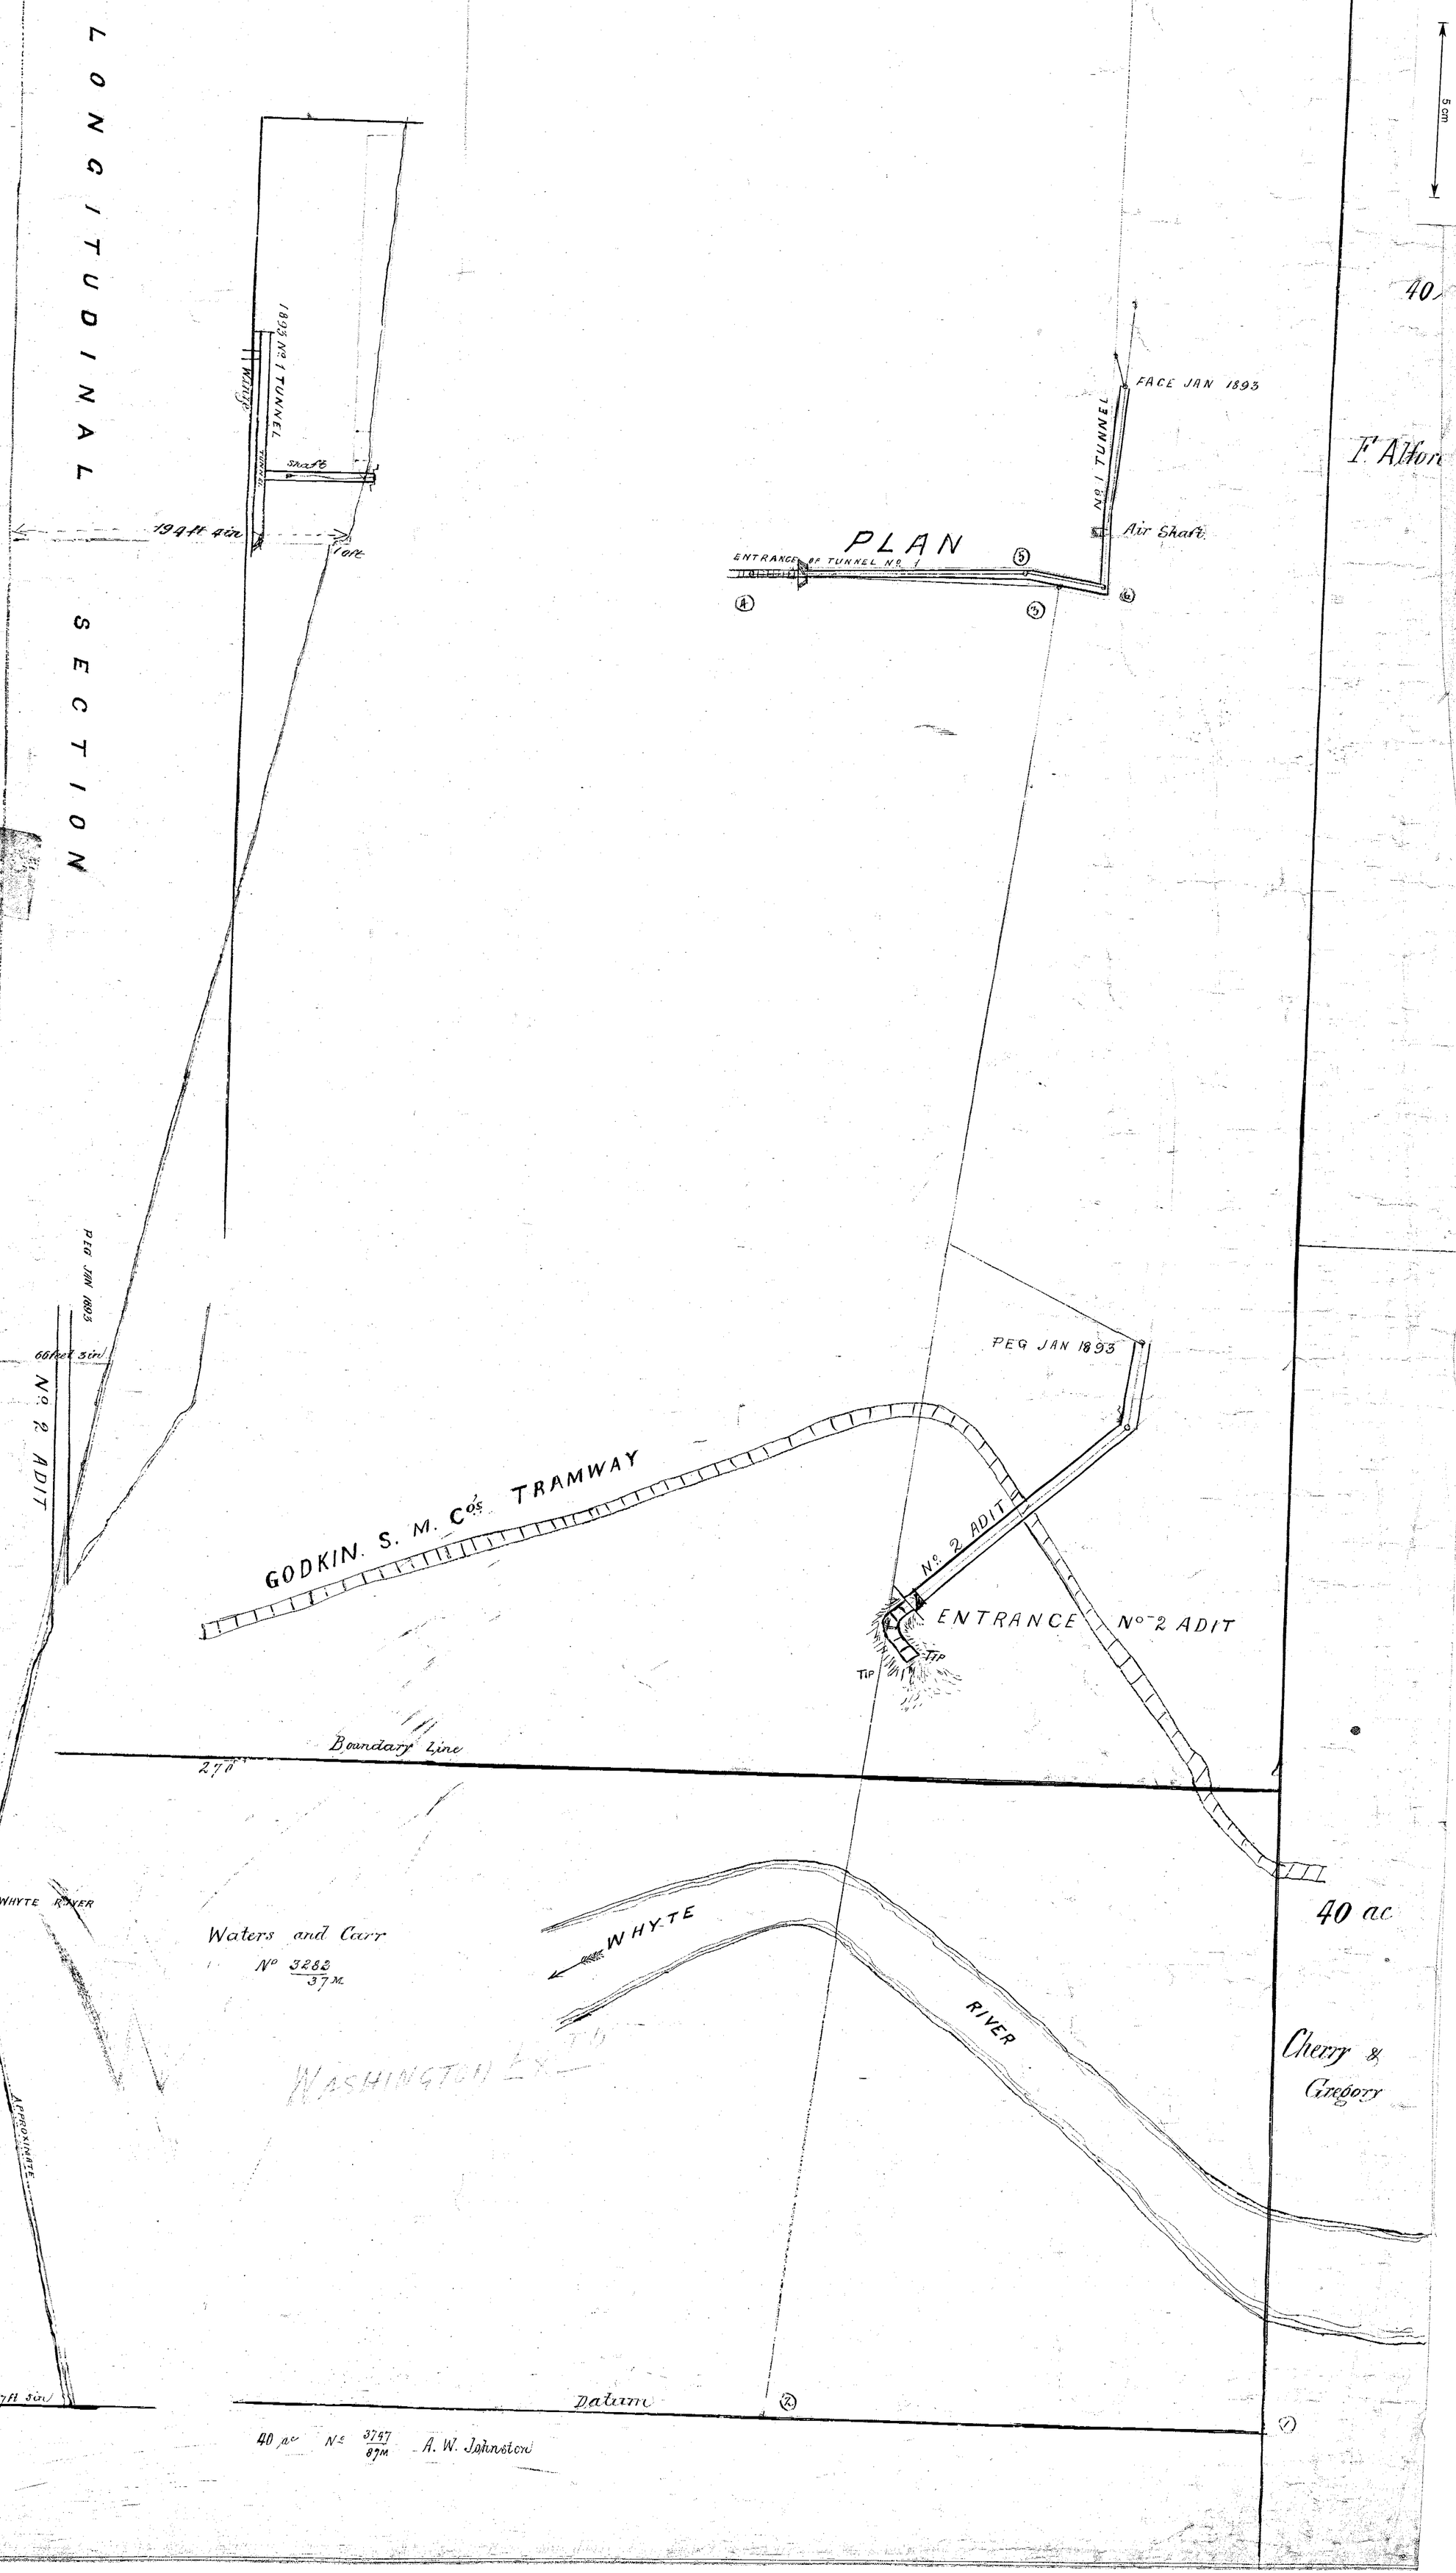

January 1893.