166-04

166-04

5 cm

PLAN

OF THE

GODKIN S. M. COMPANY'S

(Now "Magnet" Victoria)

Underground Works

WHYTE RIVER

Scale 50 Feet to 1 Inch

I, David Jones, of Waratah in Tasmania, District Surveyor, do hereby certify that this plan is sufficiently correct for the purposes of the Mining Act, 1905
4½ Theod.

David Jones.
District Surveyor,
Waratah,
Tasmania.

24th June 1906

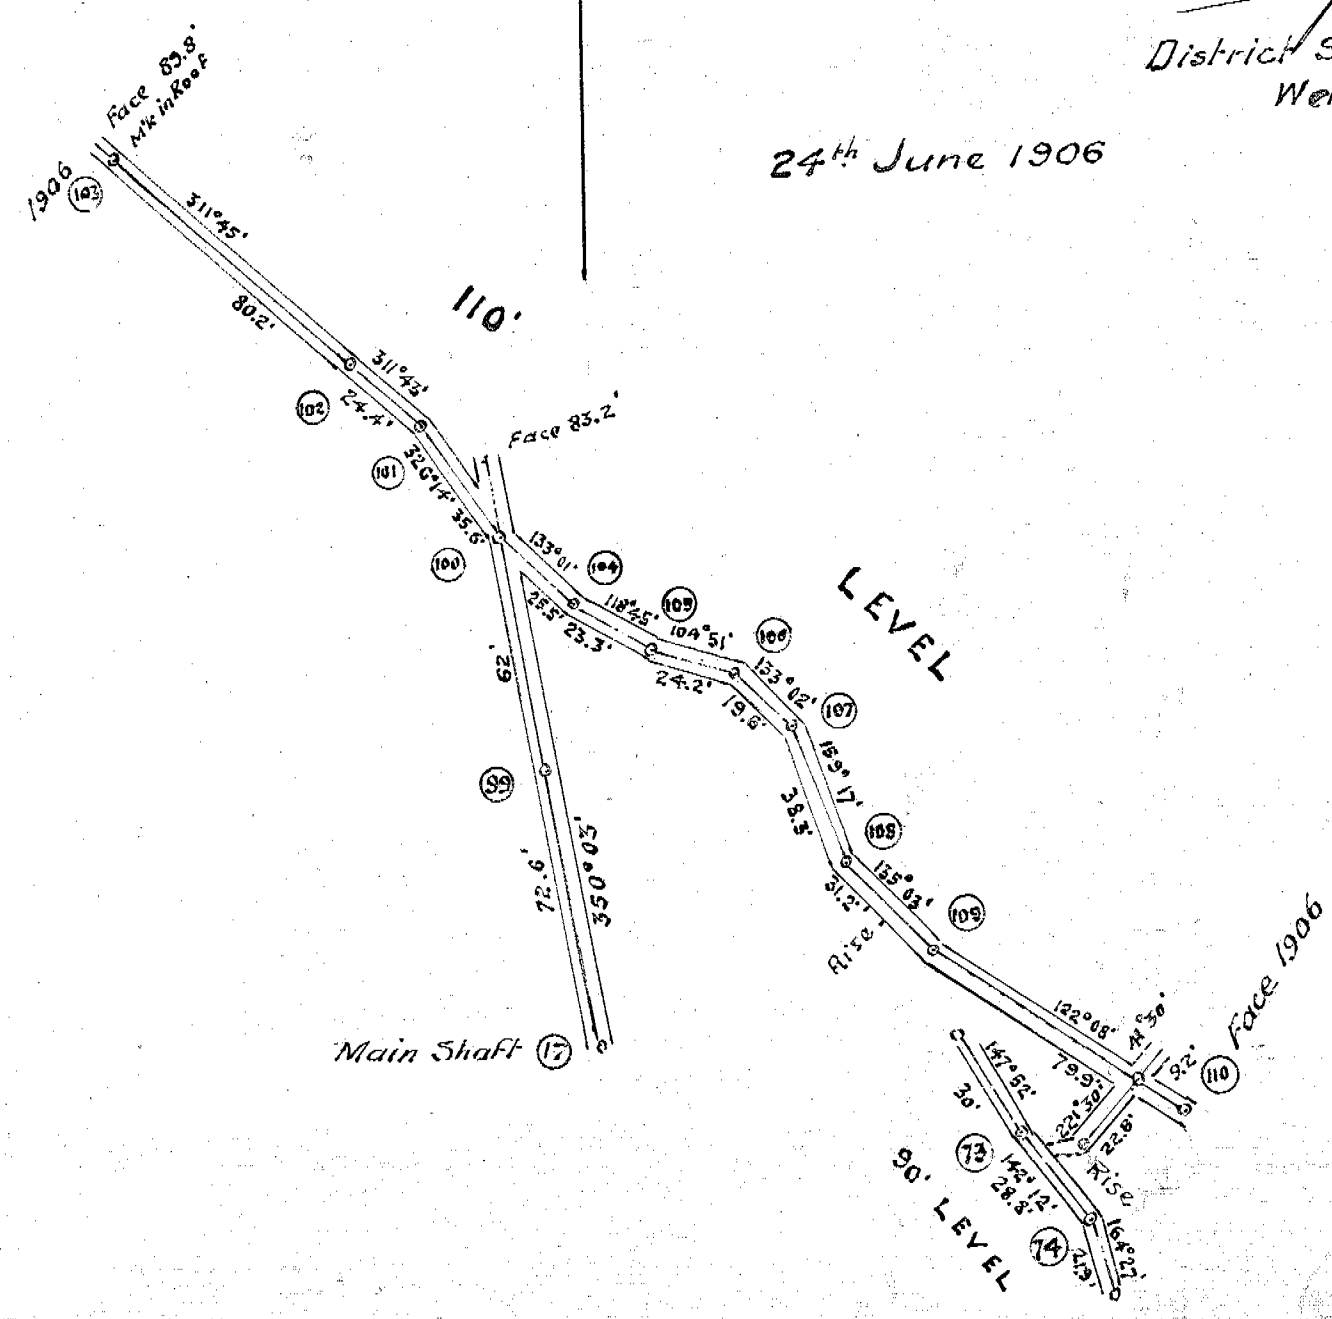

DAVID JONES
DISTRICT SURVEYOR,
WARATAH,
TASMANIA.

2nd 1906