166-06

166-06

5 cm

PLAN

OF THE

CODKIN S. M. COMPANY'S

Underground Works

WHYTE RIVER.

Scale 50 Feet to 1 Inch

GOVERNMENT ASSAYER
23 JUL 1917
LAUNCESTON, TASMANIA.

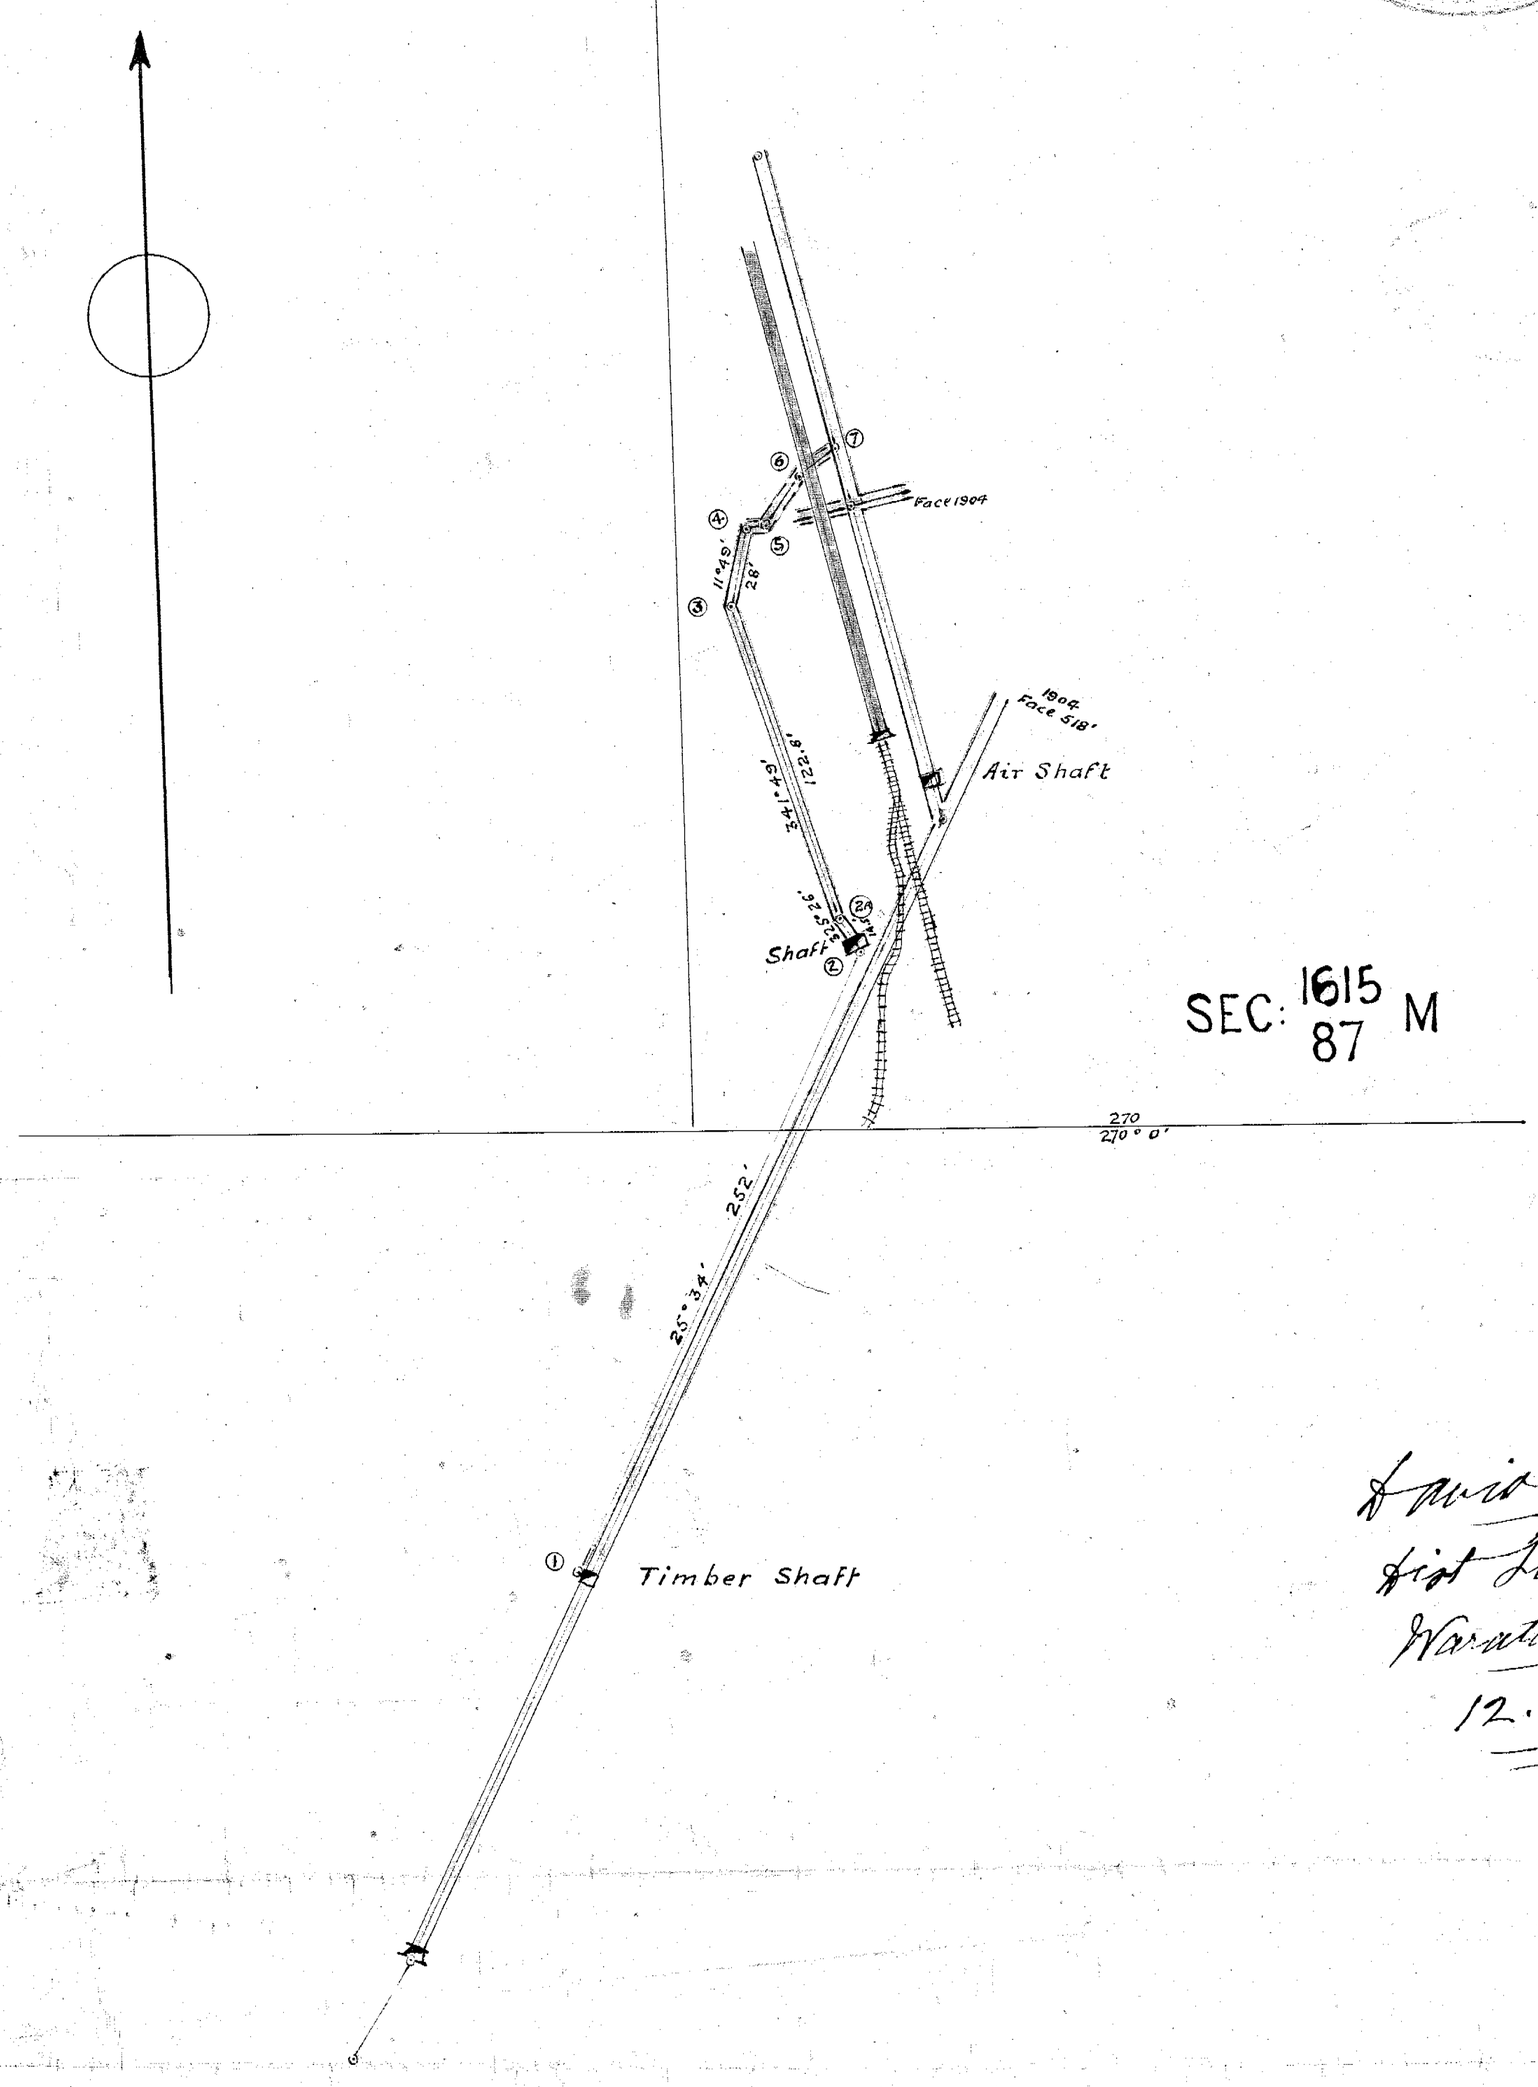

SEC: 1615 87 M

David Jones,
Dist Surveyor,
Waratah Tasmania.
12. 7. 17.

Photographed 1918 (3)