PLAN & SECTION

OF

UNDERGROUND WORKINGS CLIFF S.M. COMPANY
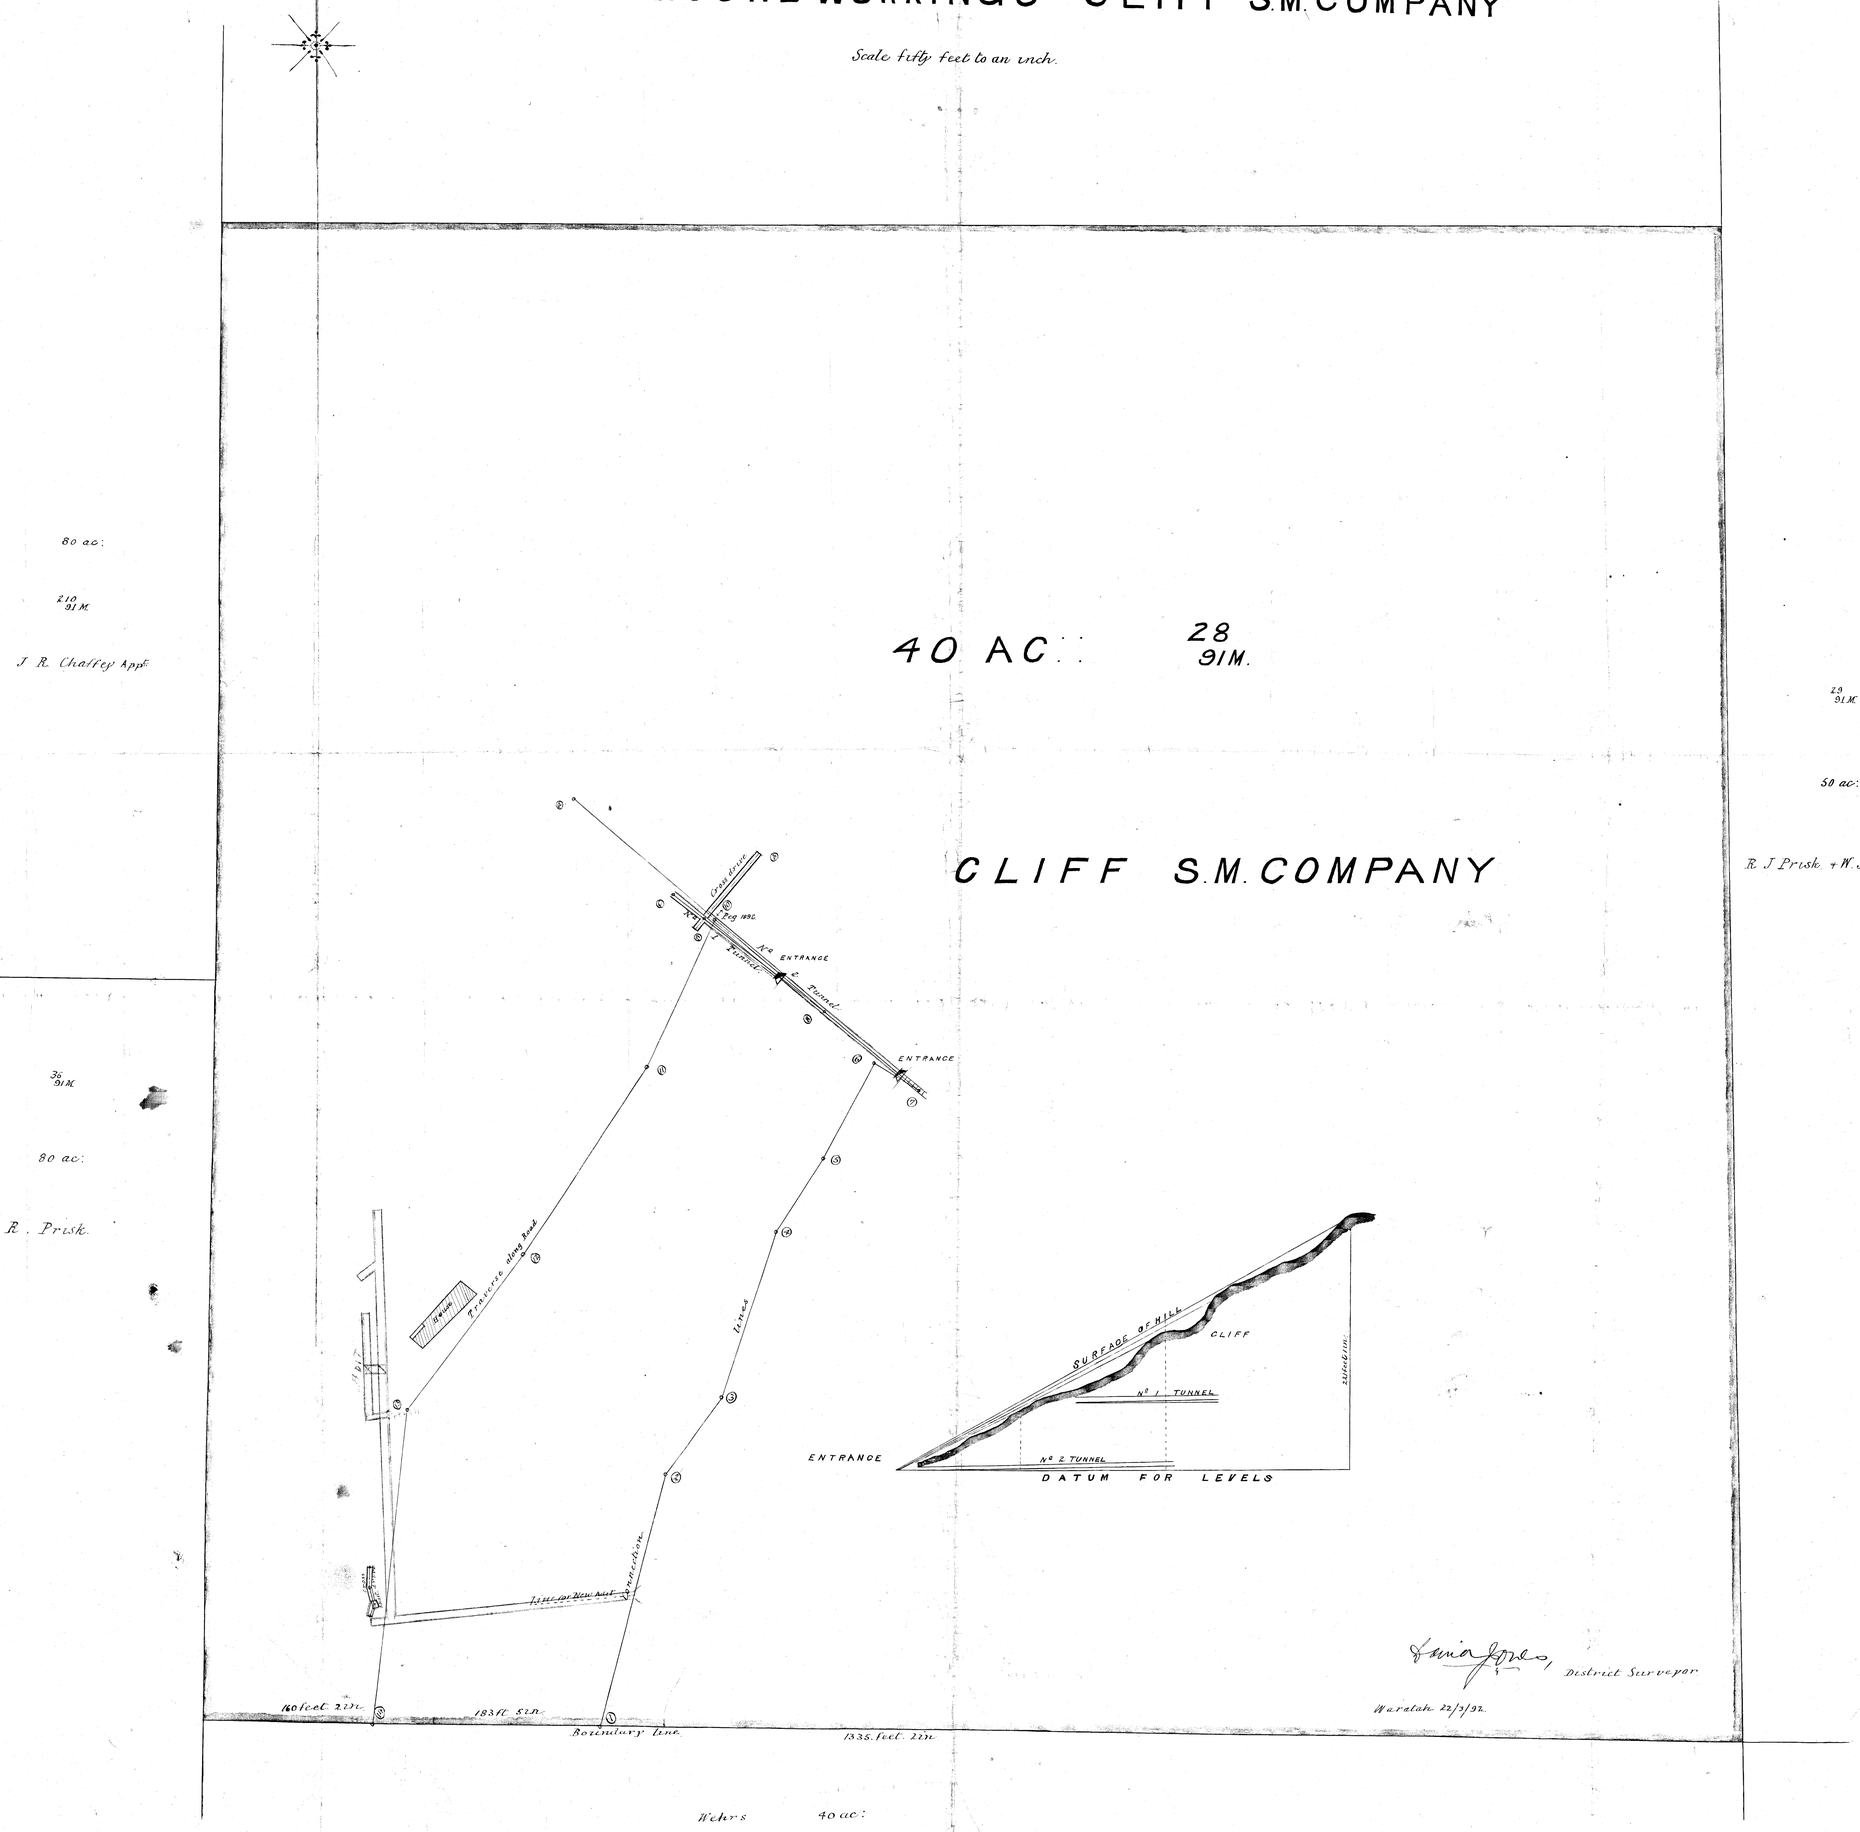
Scale fifty feet to an inch.