WEST CHUM G. M.

Longitudinal Section

Scale 25 Feet to an Inch.

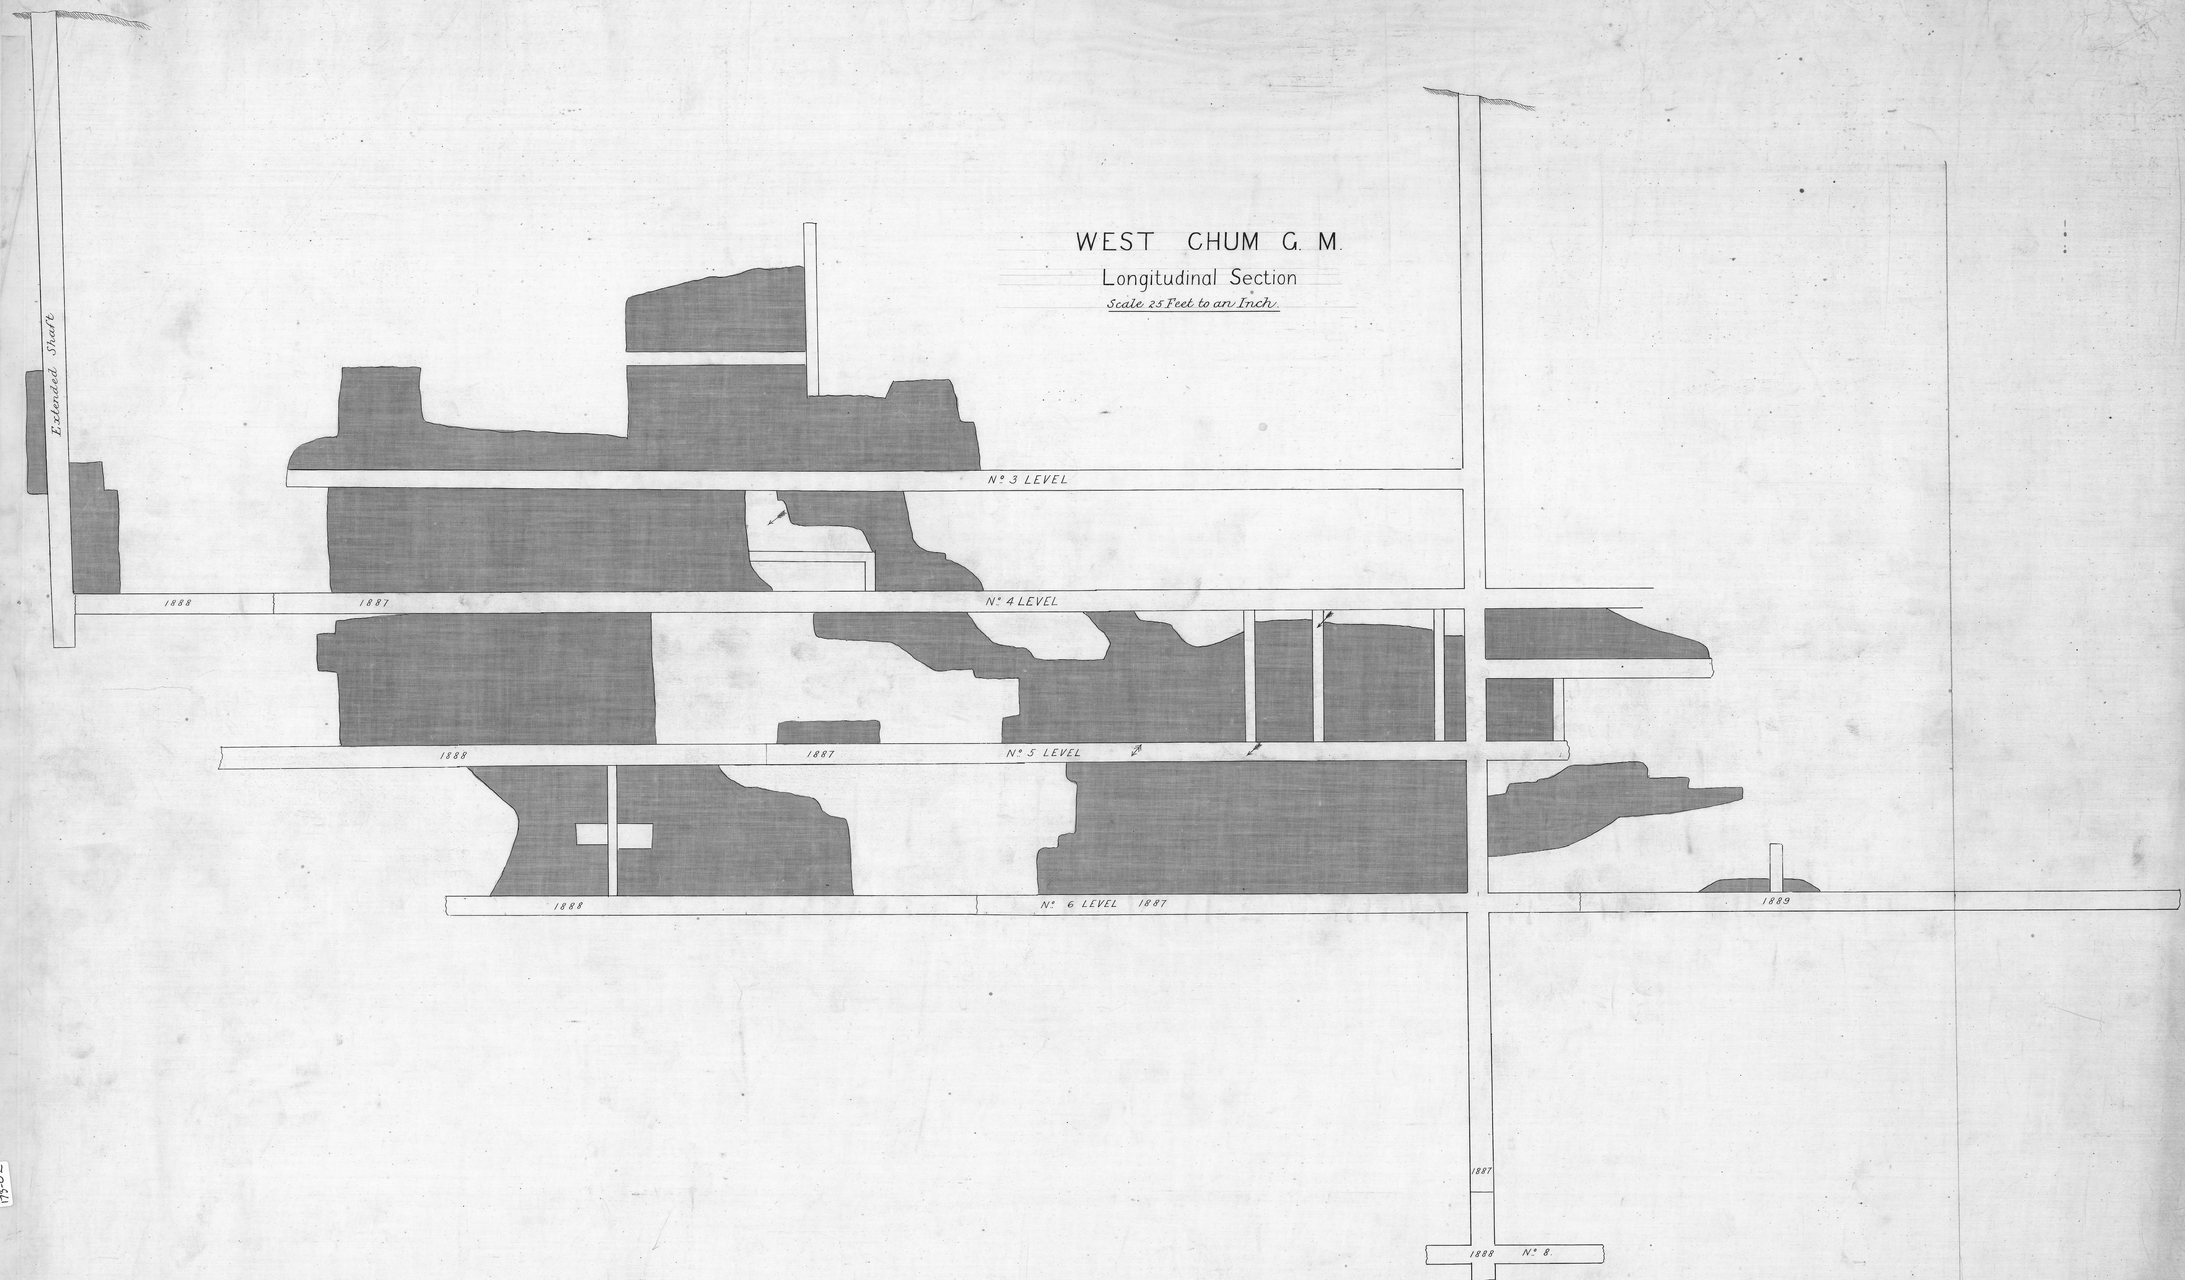

[illegible]