Salmon Gold Estate
(West Miami)
Jan 1903

176-02

SALMON GOLD ESTATES
WEST MIAMI MINE

Scale 25 feet to an inch

CROSS SECTION

LOOKING NORTH
Scale 25 feet to an inch

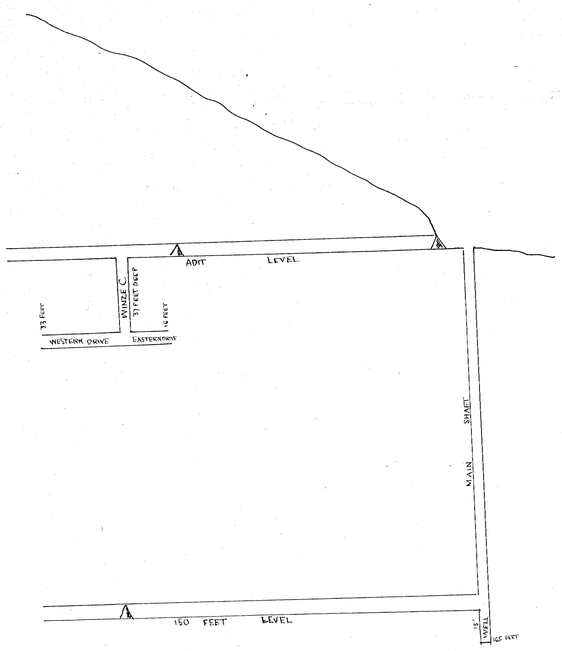

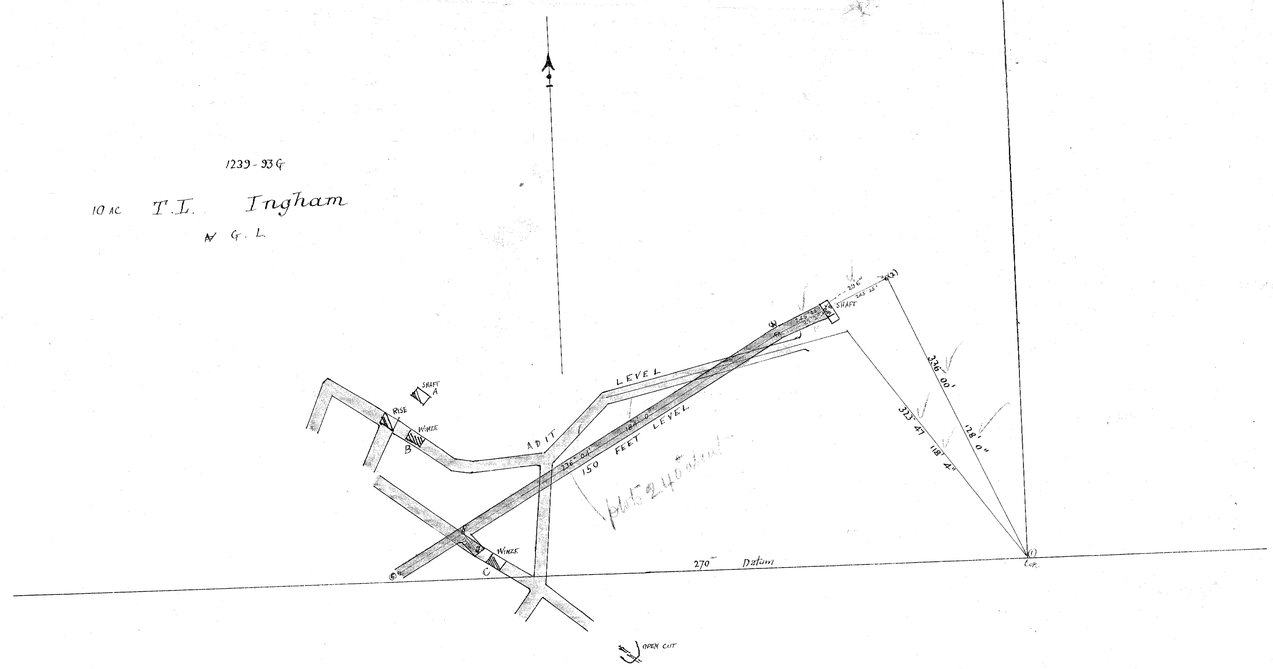

10 AC T. I. Ingham
G. I.

Campbell Smith
Authorised Surveyor
Jan 1903

Surveyed with 4" transit theodolite

INSPECTOR OF MINES
24 JAN 1903
BRISBANE

176-02

5 cm