WEST MIAMI MINE

COUNTY OF CORNWALL

PARISH OF WOODFORD

Scale 25 feet to an inch

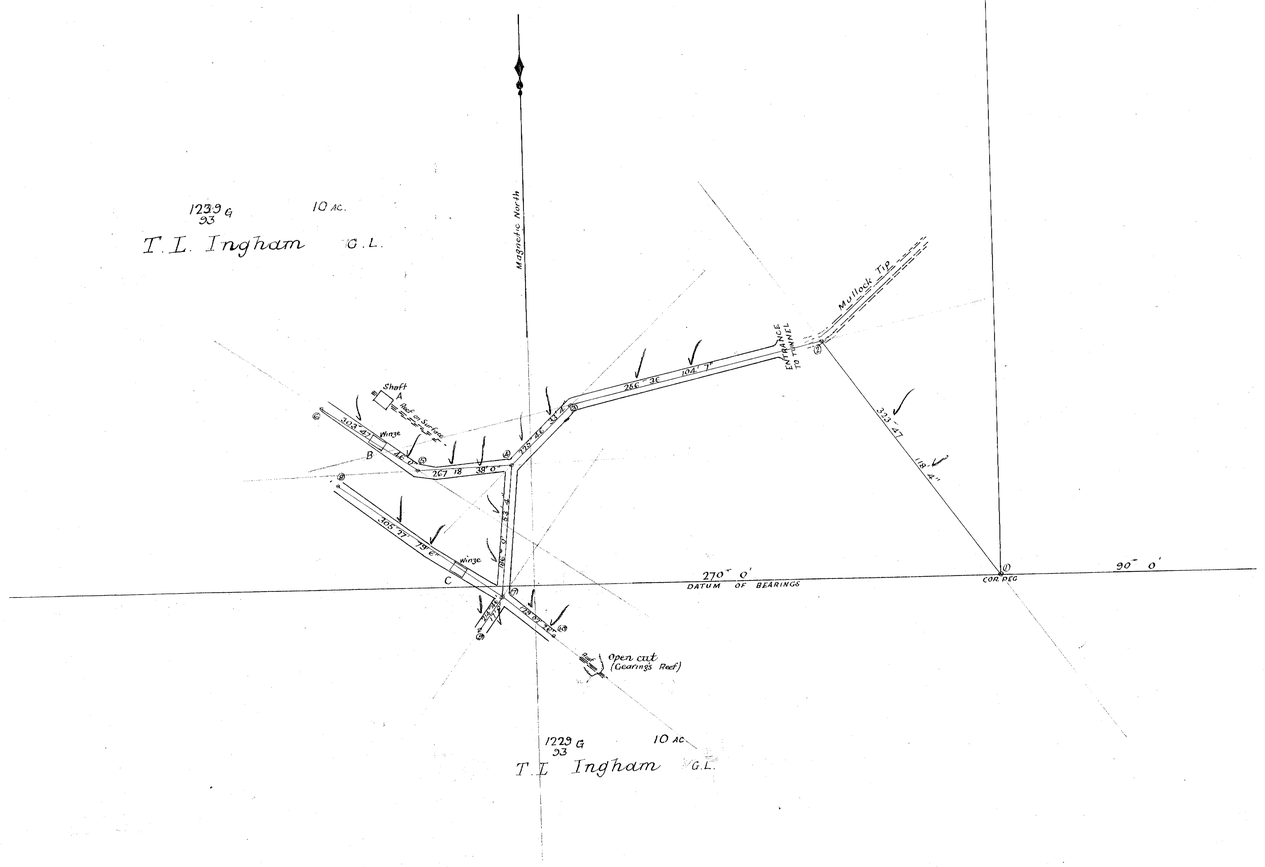

A. Shaft from Surface 62 feet deep on the underlay
B. Winze 21 feet deep
C. Winze 37 feet deep with drive 16 feet east and one 33 feet west from that depth

Campbell Smith
Authorised Surveyor
January 1901

MINES INSPECTOR OF MINES
13 FEB 1901
LAUNCESTON