


178-01

WOMBAT TIN MINE

Showing Position of Assay Samples

Workings and Assay Values ^{down to 30 ft.} copied
from original Plan

Scale 5 ft to an Inch

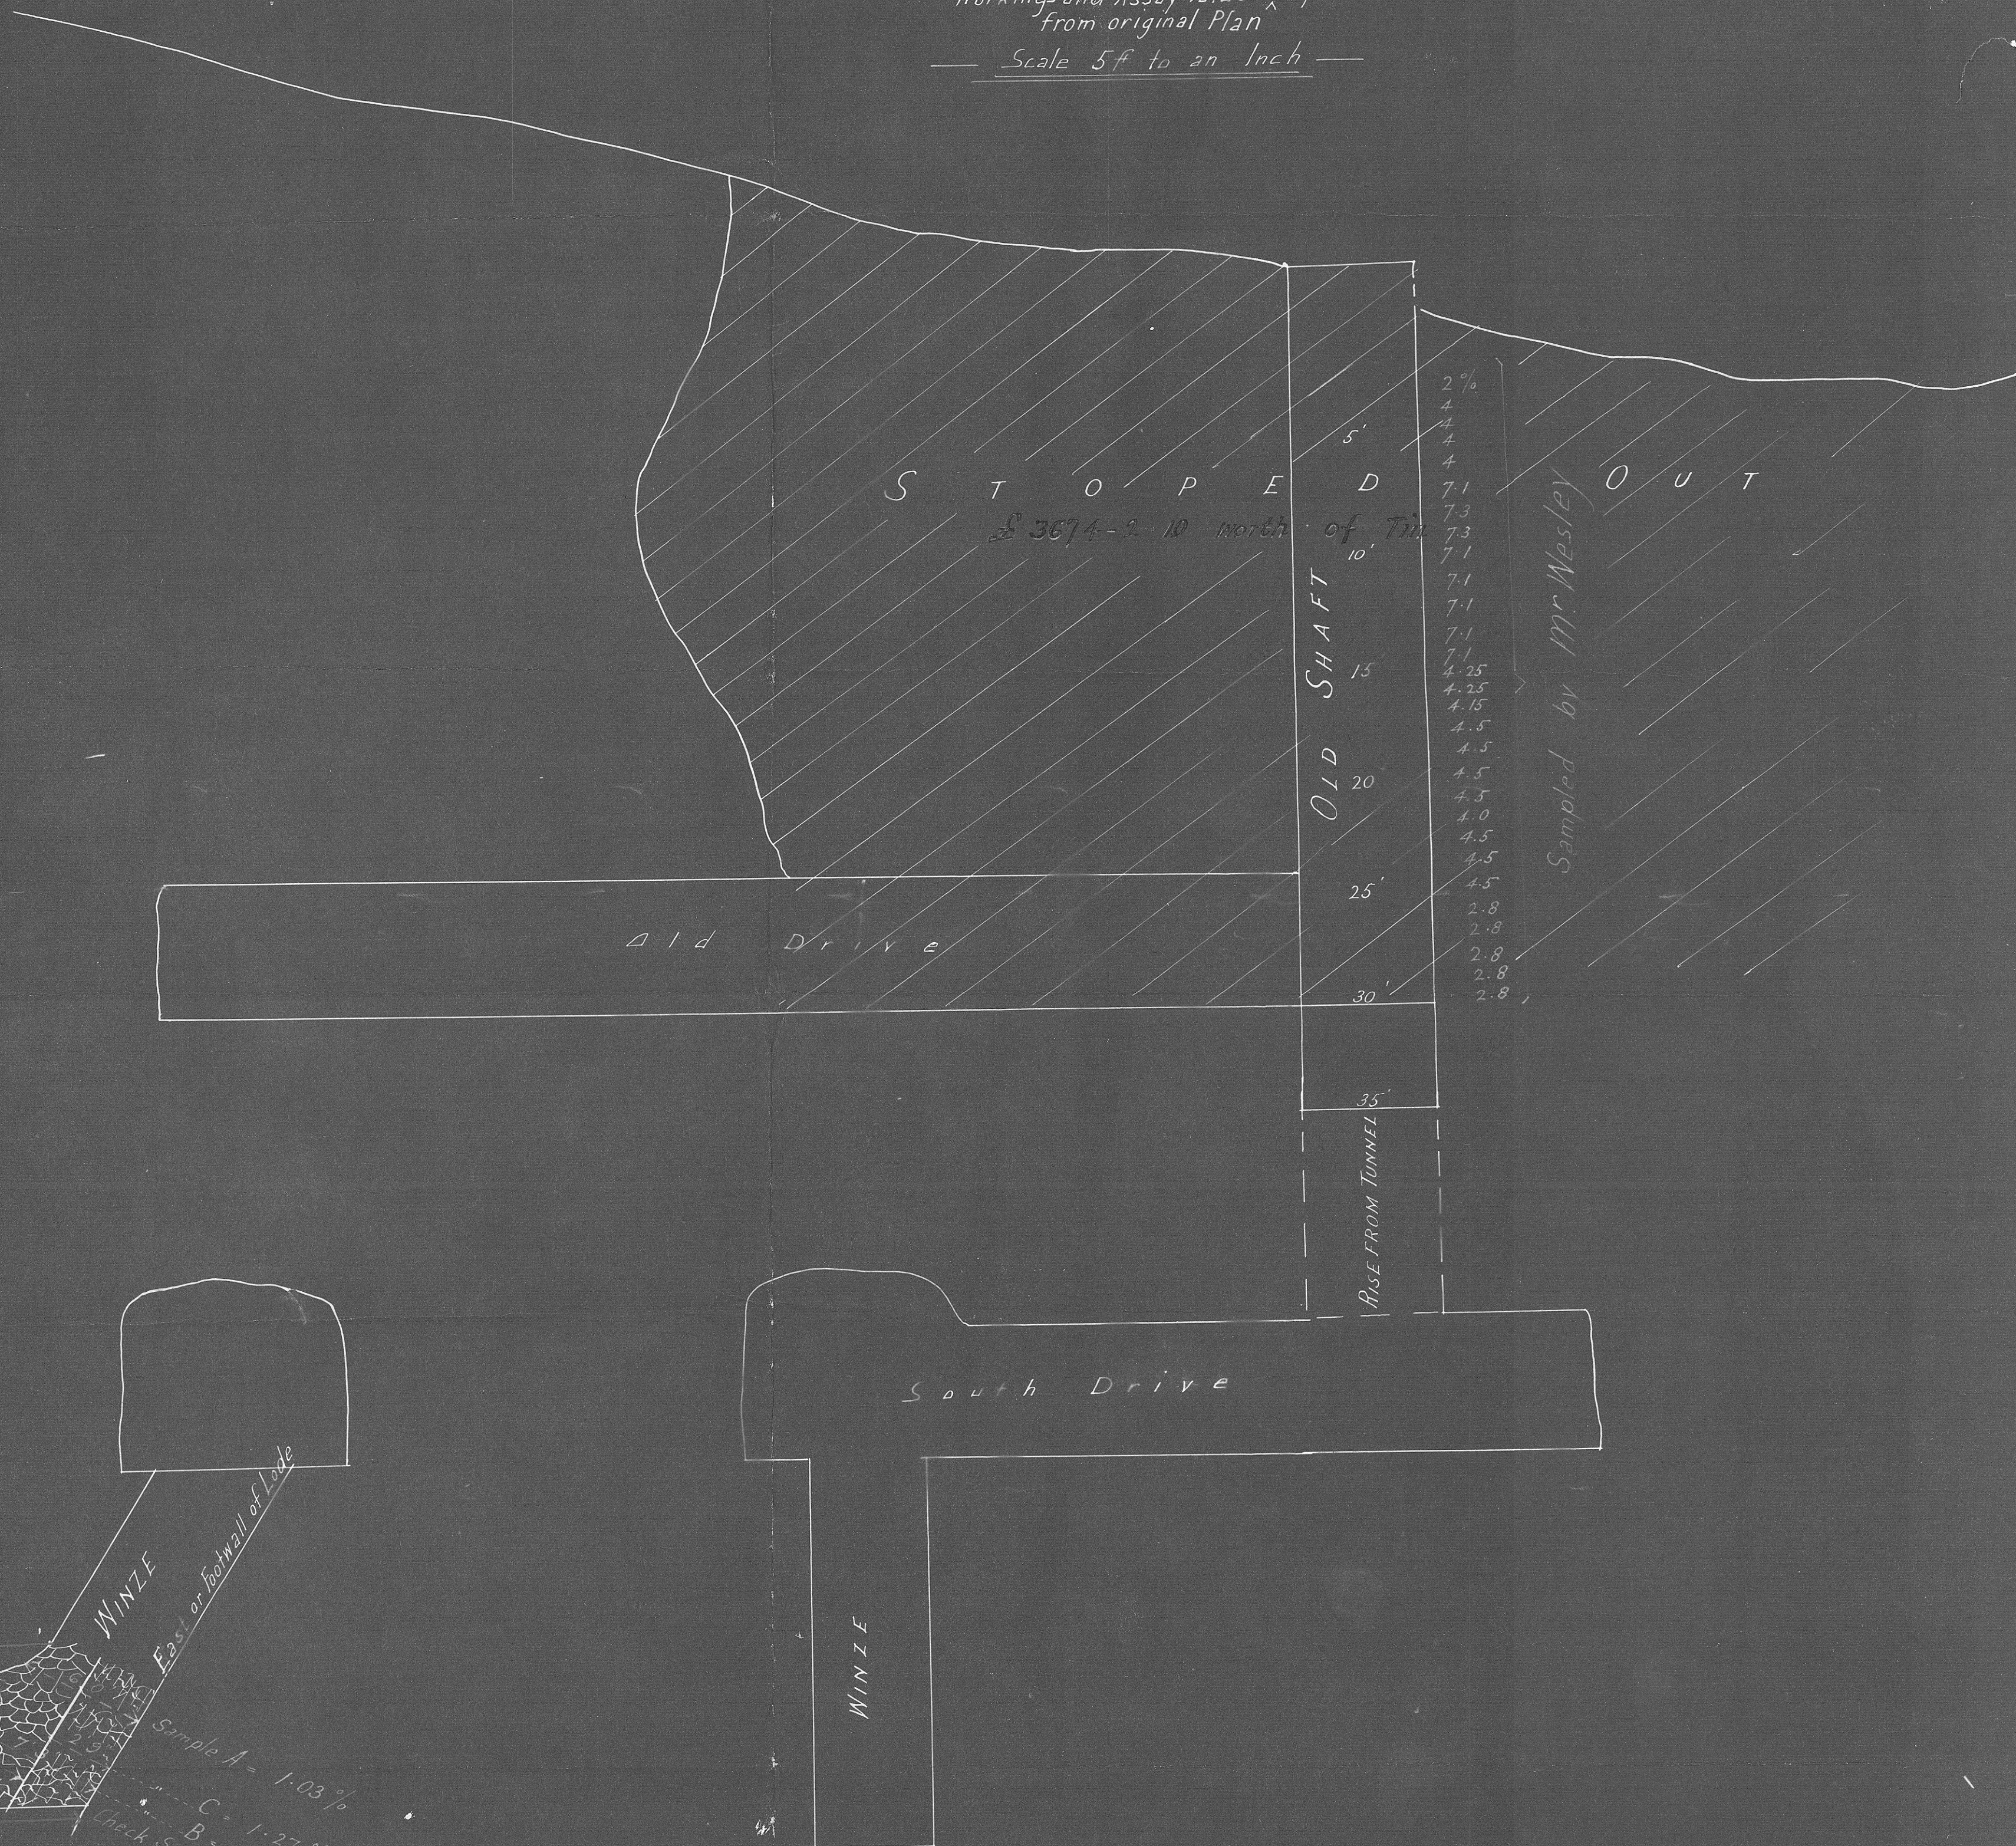

Samples taken from South Face of Winze