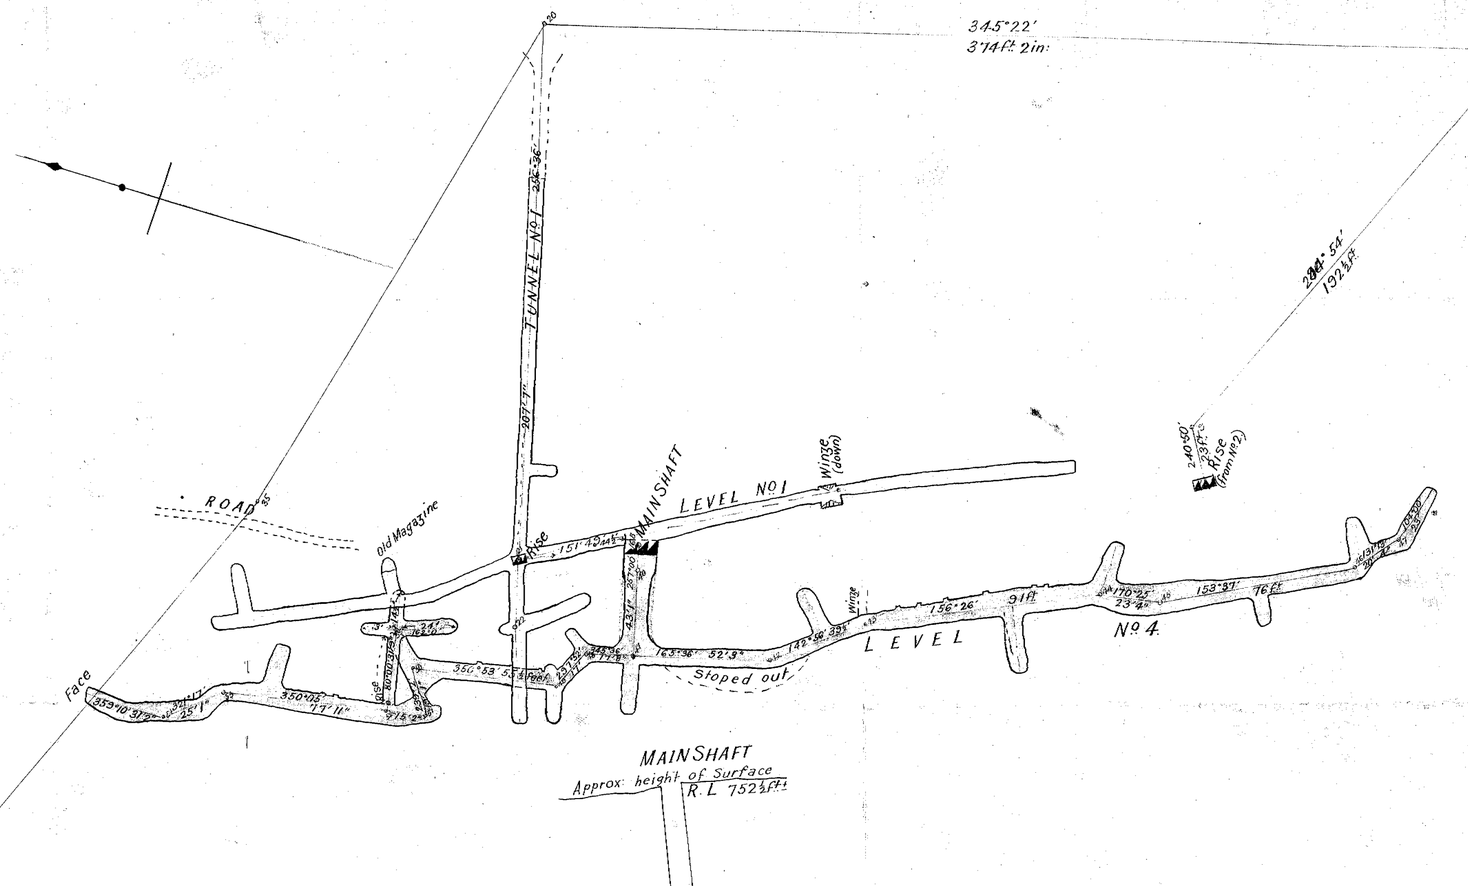

LONGITUDINAL SECTION

Vertical Scale 40 feet to an inch.

Mt BALFOUR COPPER

REWARD MINE

Scale: 40 feet to an inch.

123 M 80ac: W.W.F. & T.G. Murray M.L.

H. M. Harrisson

Mining Surveyor

Survey commenced 28.1.11.

" finished 18.12.13

180-03

180-03