PLAN OF

AN UNDERGROUND SURVEY OF THE

MIAMI MINE

SALMON GOLD SYNDICATE OF TASMANIA LIMITED LESSEES

UNDER THE GOLD FIELDS REGULATION ACT

Scale One Chain to an inch

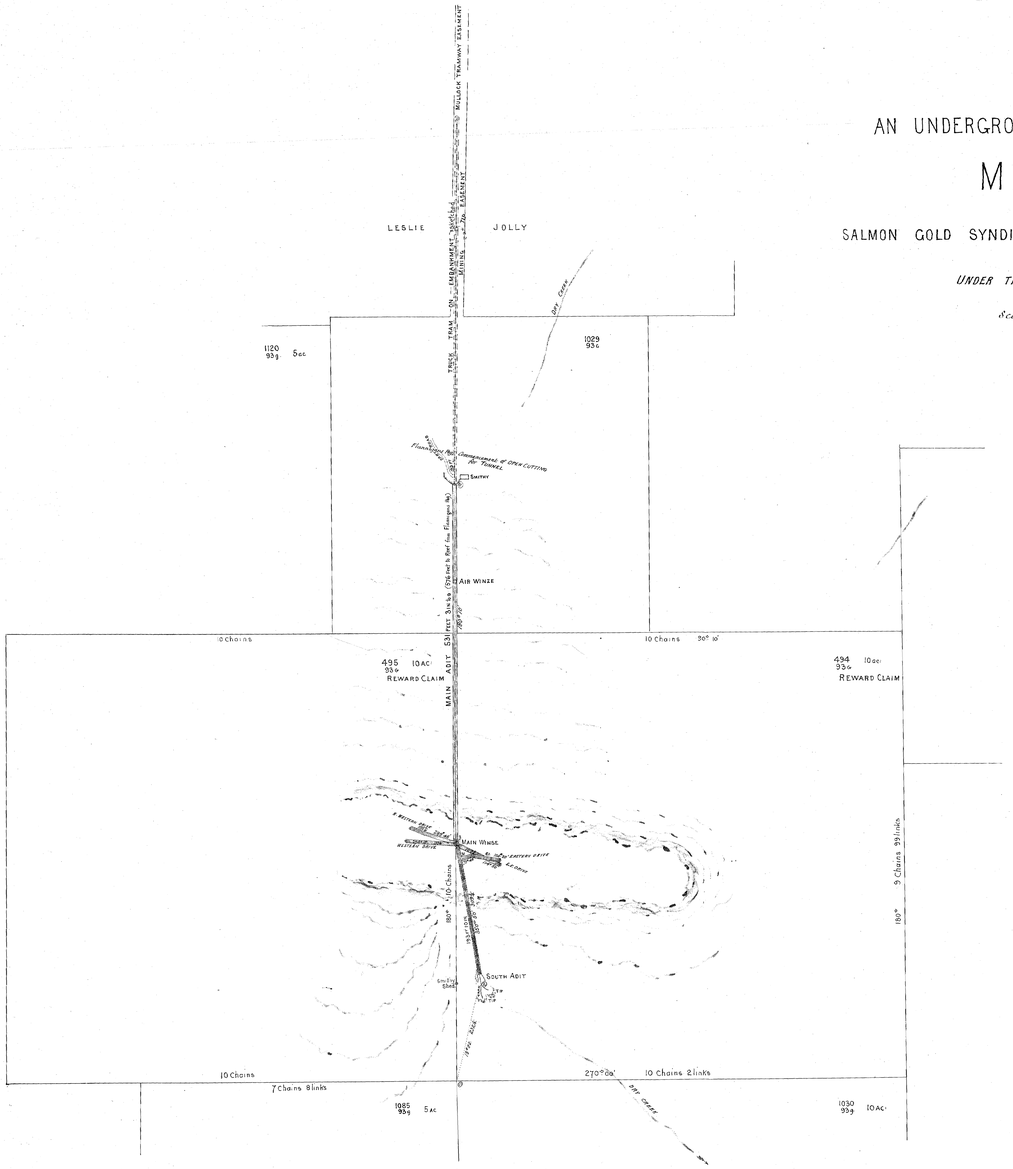

VERTICAL & CROSS SECTION (LOOKING SOUTH

MIAMI MINE - QUARTZ

PARISH OF EVERCREECH COUNTY OF CORNWALL. TASMANIA

Scale 20 feet to one inch

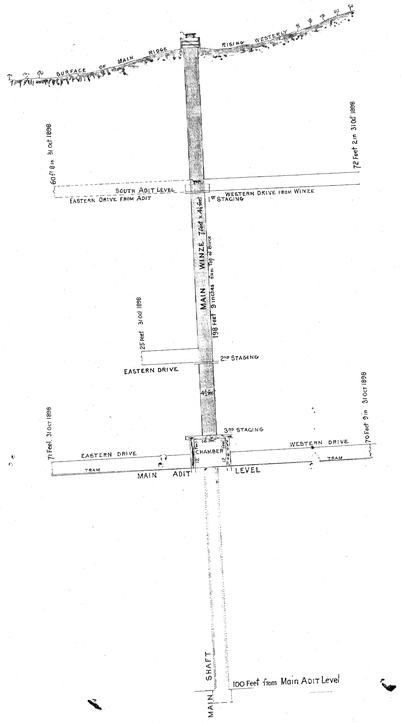

Geo. L. Lord
Chalwood Camp
Arcadia 1898

Survey effected in October 1898, Midsticks + Steel Band Chain