SALMON GOLD ESTATES

185-15

MIAMI MINE

Scale 25 feet to an inch

SEC. $\frac{1022}{23}$ G

SEC. $\frac{434}{23}$ G 10 AC.

Salmon Gold Syndicate of Tas: Lim:

M. L.

Mulloch Tip

MAIN ADIT

300 ft. Level

200 FEET LEVEL

Winze from this Level to 400 ft. Level

400 ft. Level

Winze from 400 ft. Level to 500 ft. Level

500 ft. Level

PLAN

SEC. $\frac{495}{23}$ G 10 AC.

Salmon Gold Syndicate of Tas: Lim.

SEC. $\frac{1120}{23}$ G 5 AC.

1 cm

VERTICAL AND CROSS SECTION

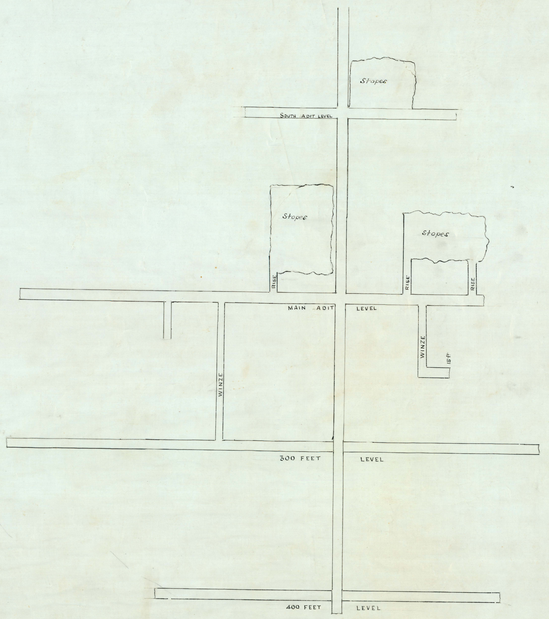

Campbell Smith
Authorised Surveyor
January 1907

INSPECTOR OF MINES
23 FEB 1914
TASMANIA