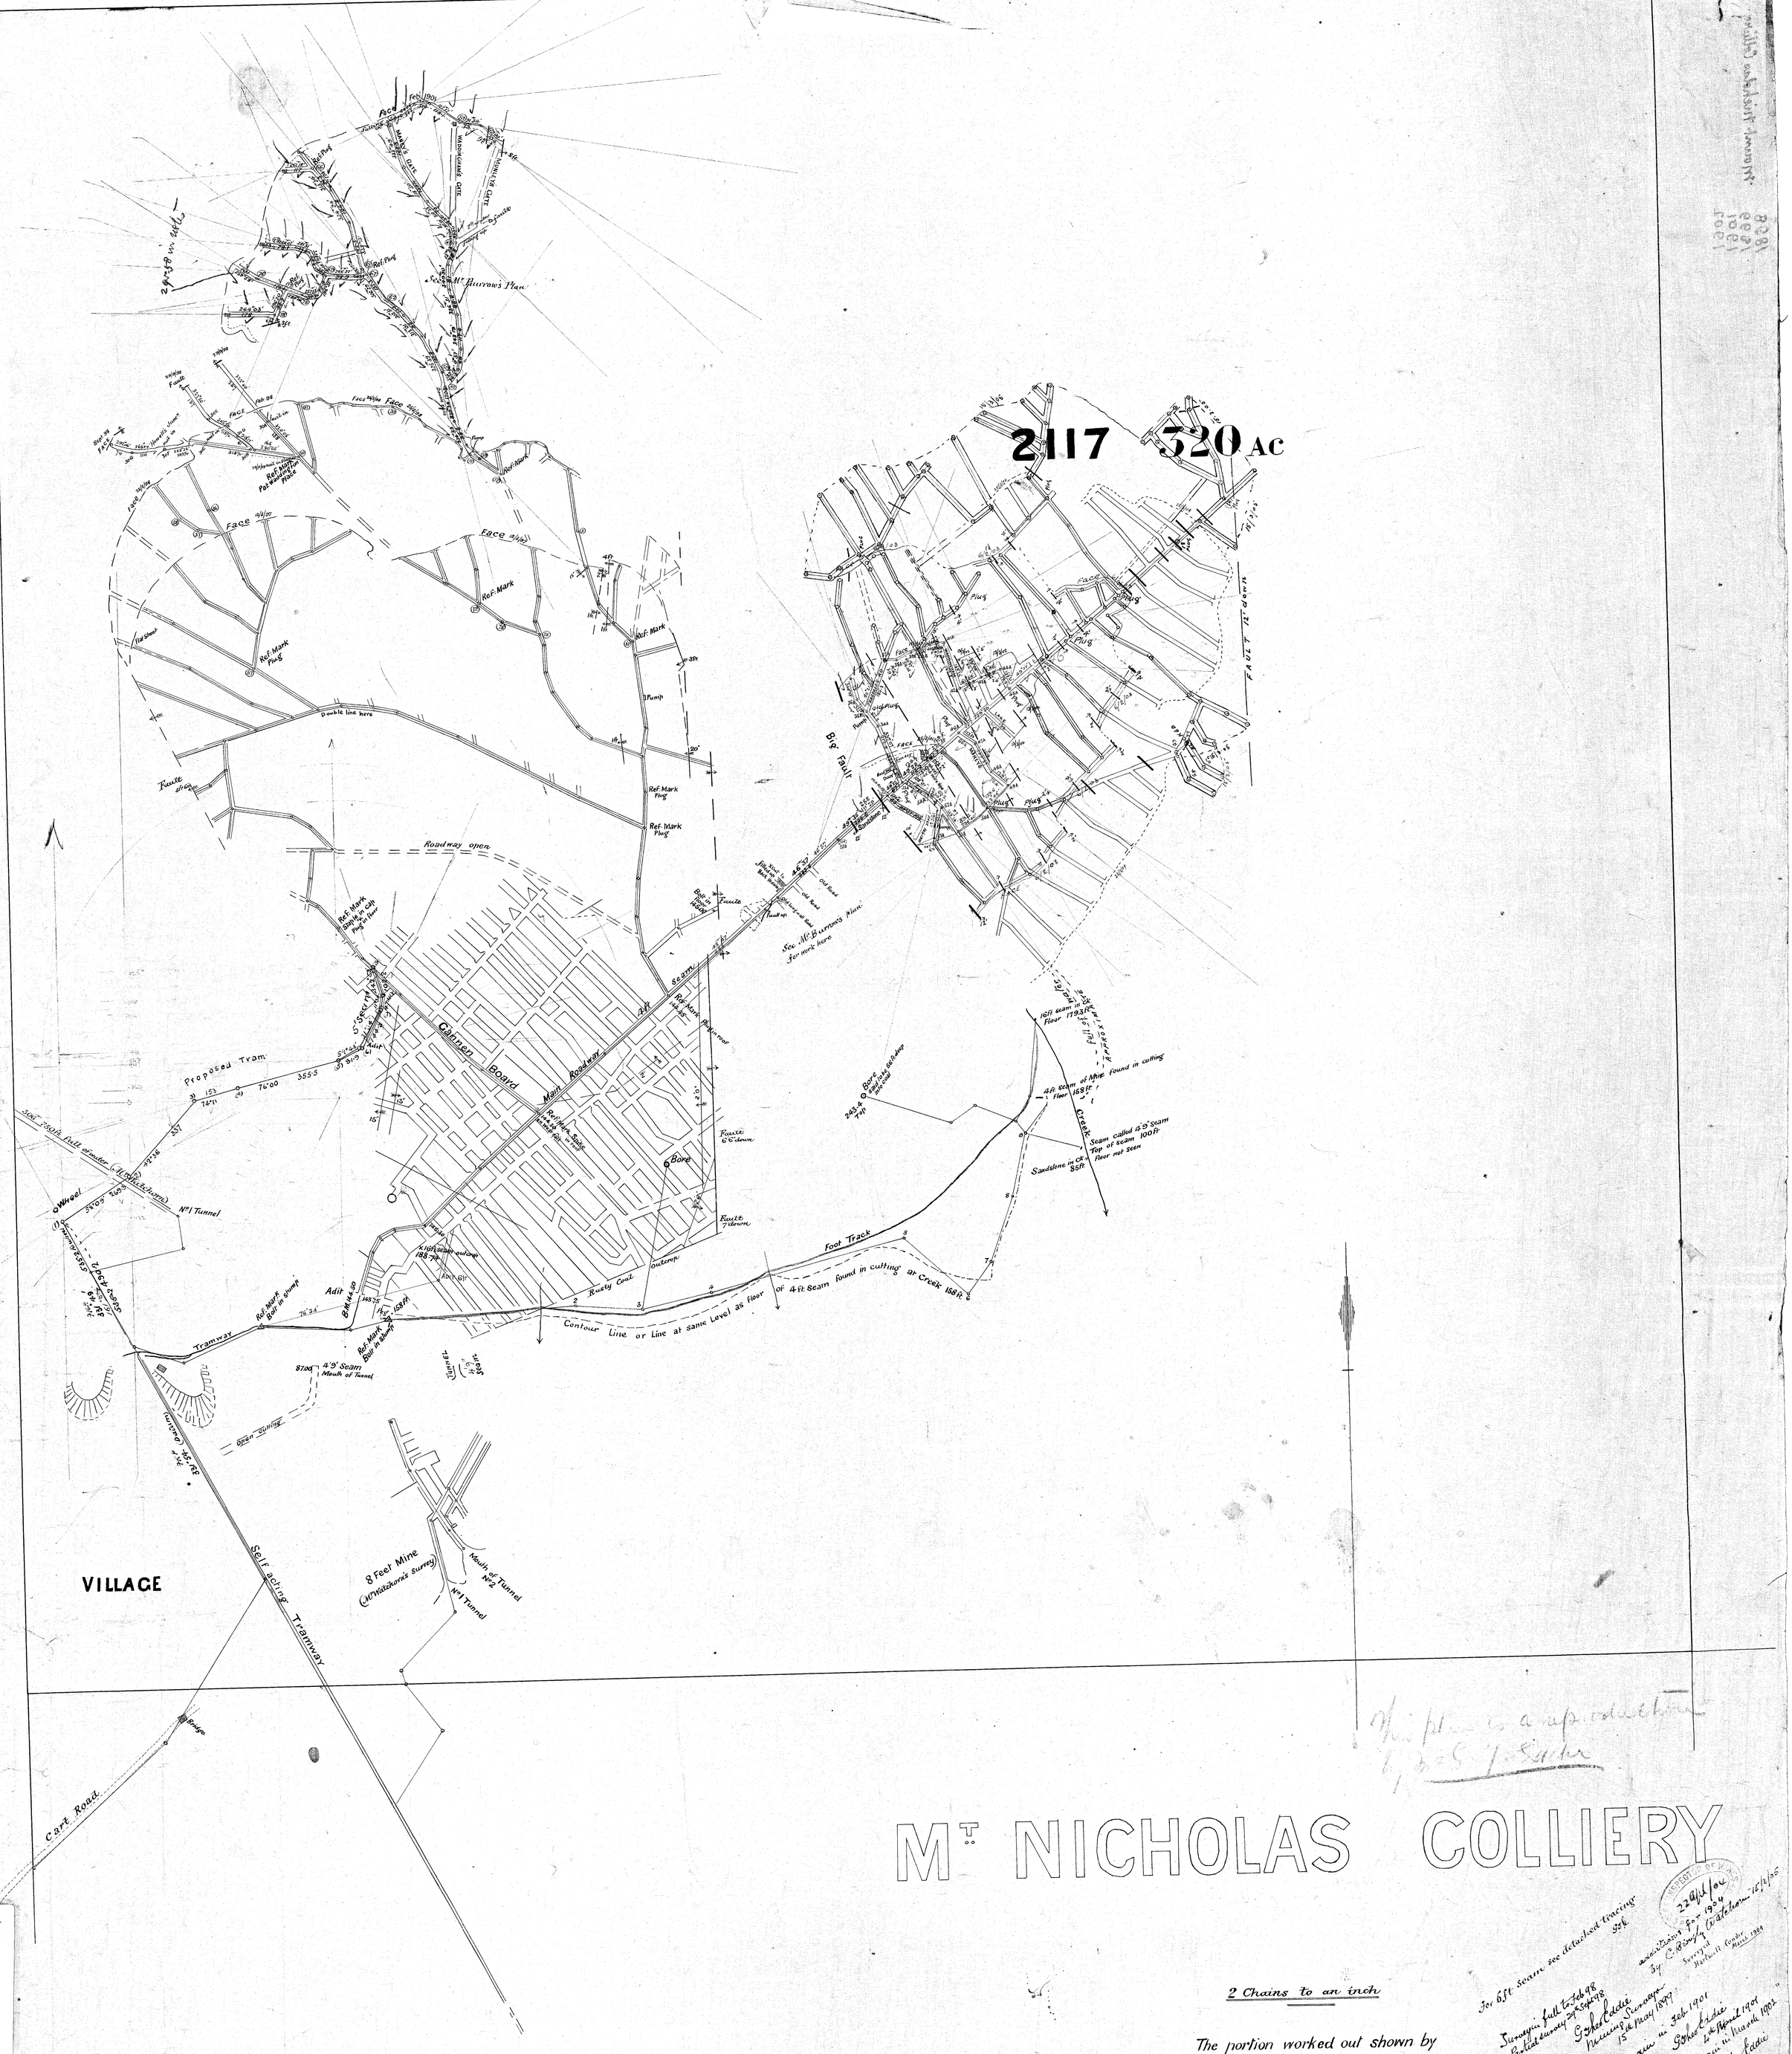

2 Chains to an inch

The portion worked out shown by red lines is from a survey by Mr Watchorn

Figures in blue denote heights above a common Datum

Some lengths & bearings are in blue

For 6ft Seam see detached tracing

Surveyed in February 03

Frank K. Pitt
Mining Surveyor
14/2/03

Surveyed in April 1902

Surveyed in March 1901

Surveyed in Feb 1901

Surveyed in May 1899

Surveyed in Feb 98

Surveyed in March 1884

CHIEF INSPECTOR OF MINES LAUNCESTON 10 SEP 1902

CHIEF INSPECTOR OF MINES LAUNCESTON 11 APR 1901

CHIEF INSPECTOR OF MINES 18 FEB 1903

CHIEF INSPECTOR OF MINES 22 SEP 1904

This plan is a reproduction
[illegible]

86-981