186-12

186-12

5 cm

Mt. Nicholas Coal Mine

Scale 1 inch = 2 chains

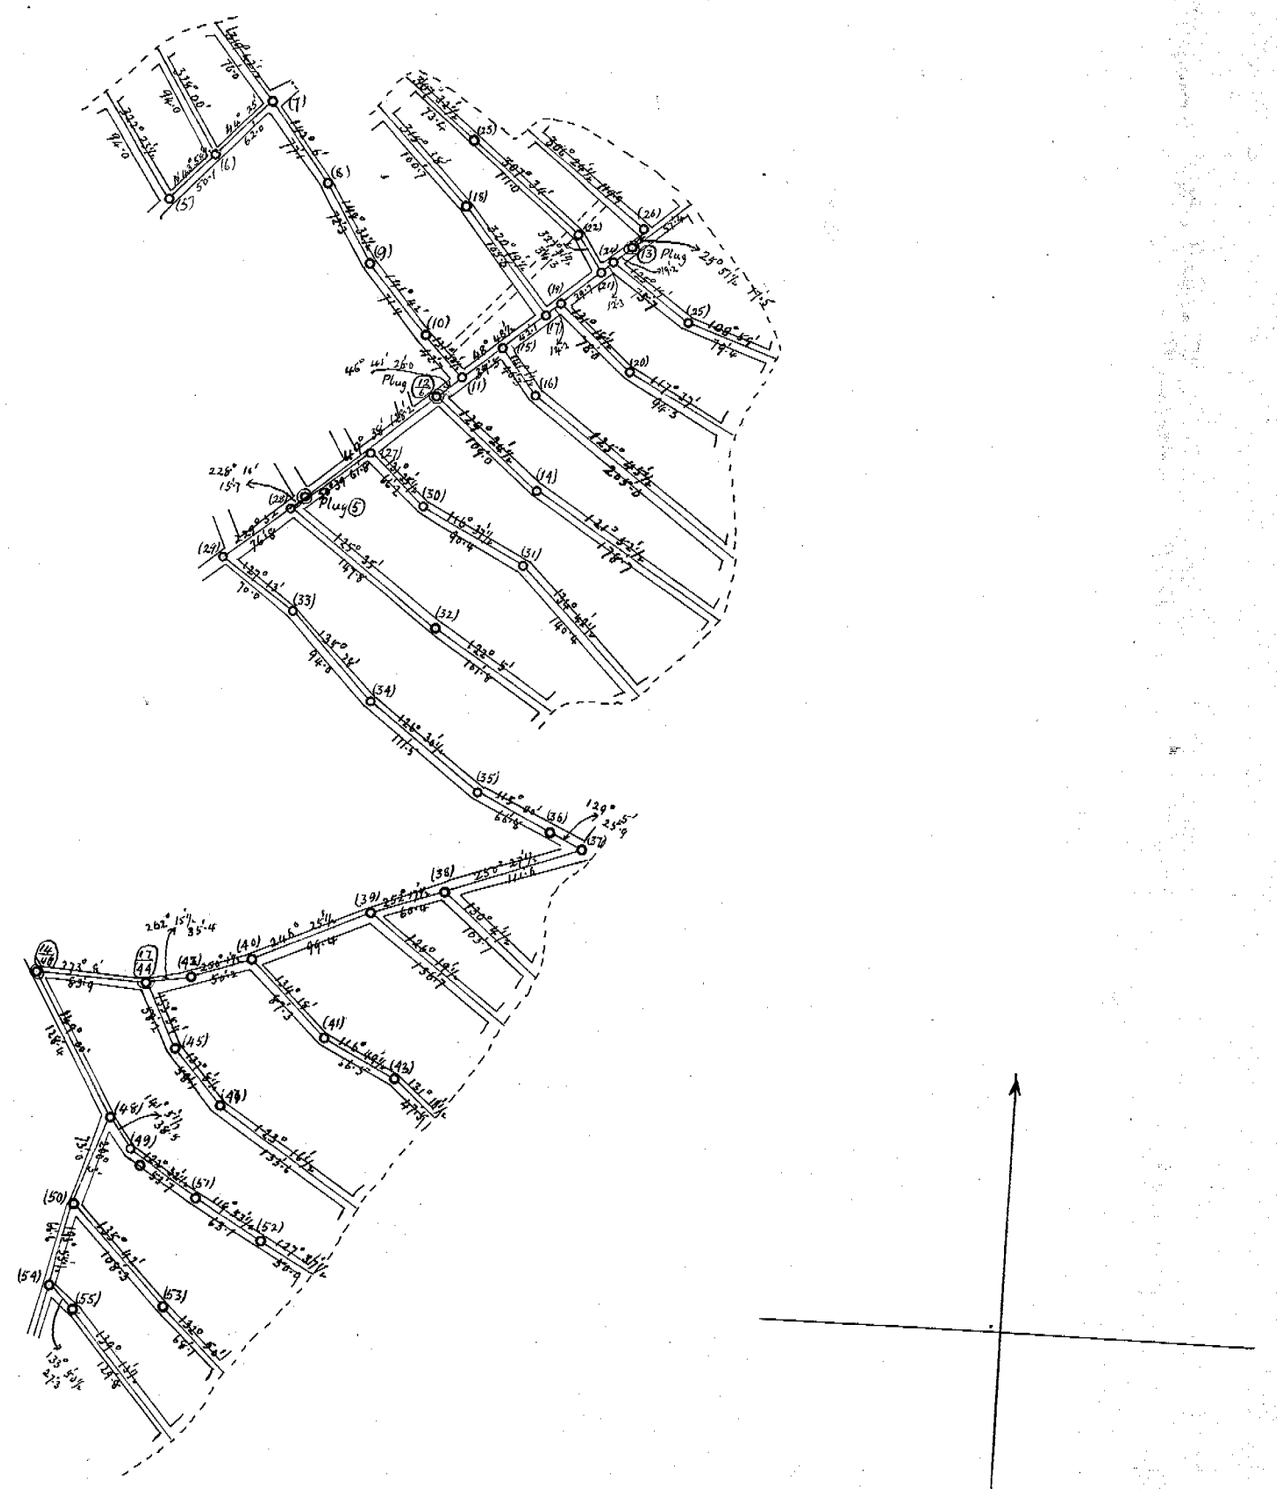

Hartwell Conder.
April. 1904

224pl./04

ARCHIVIST

108