Mt. NICHOLAS COLLIERY

Scale 40 ft. to 1 inch.

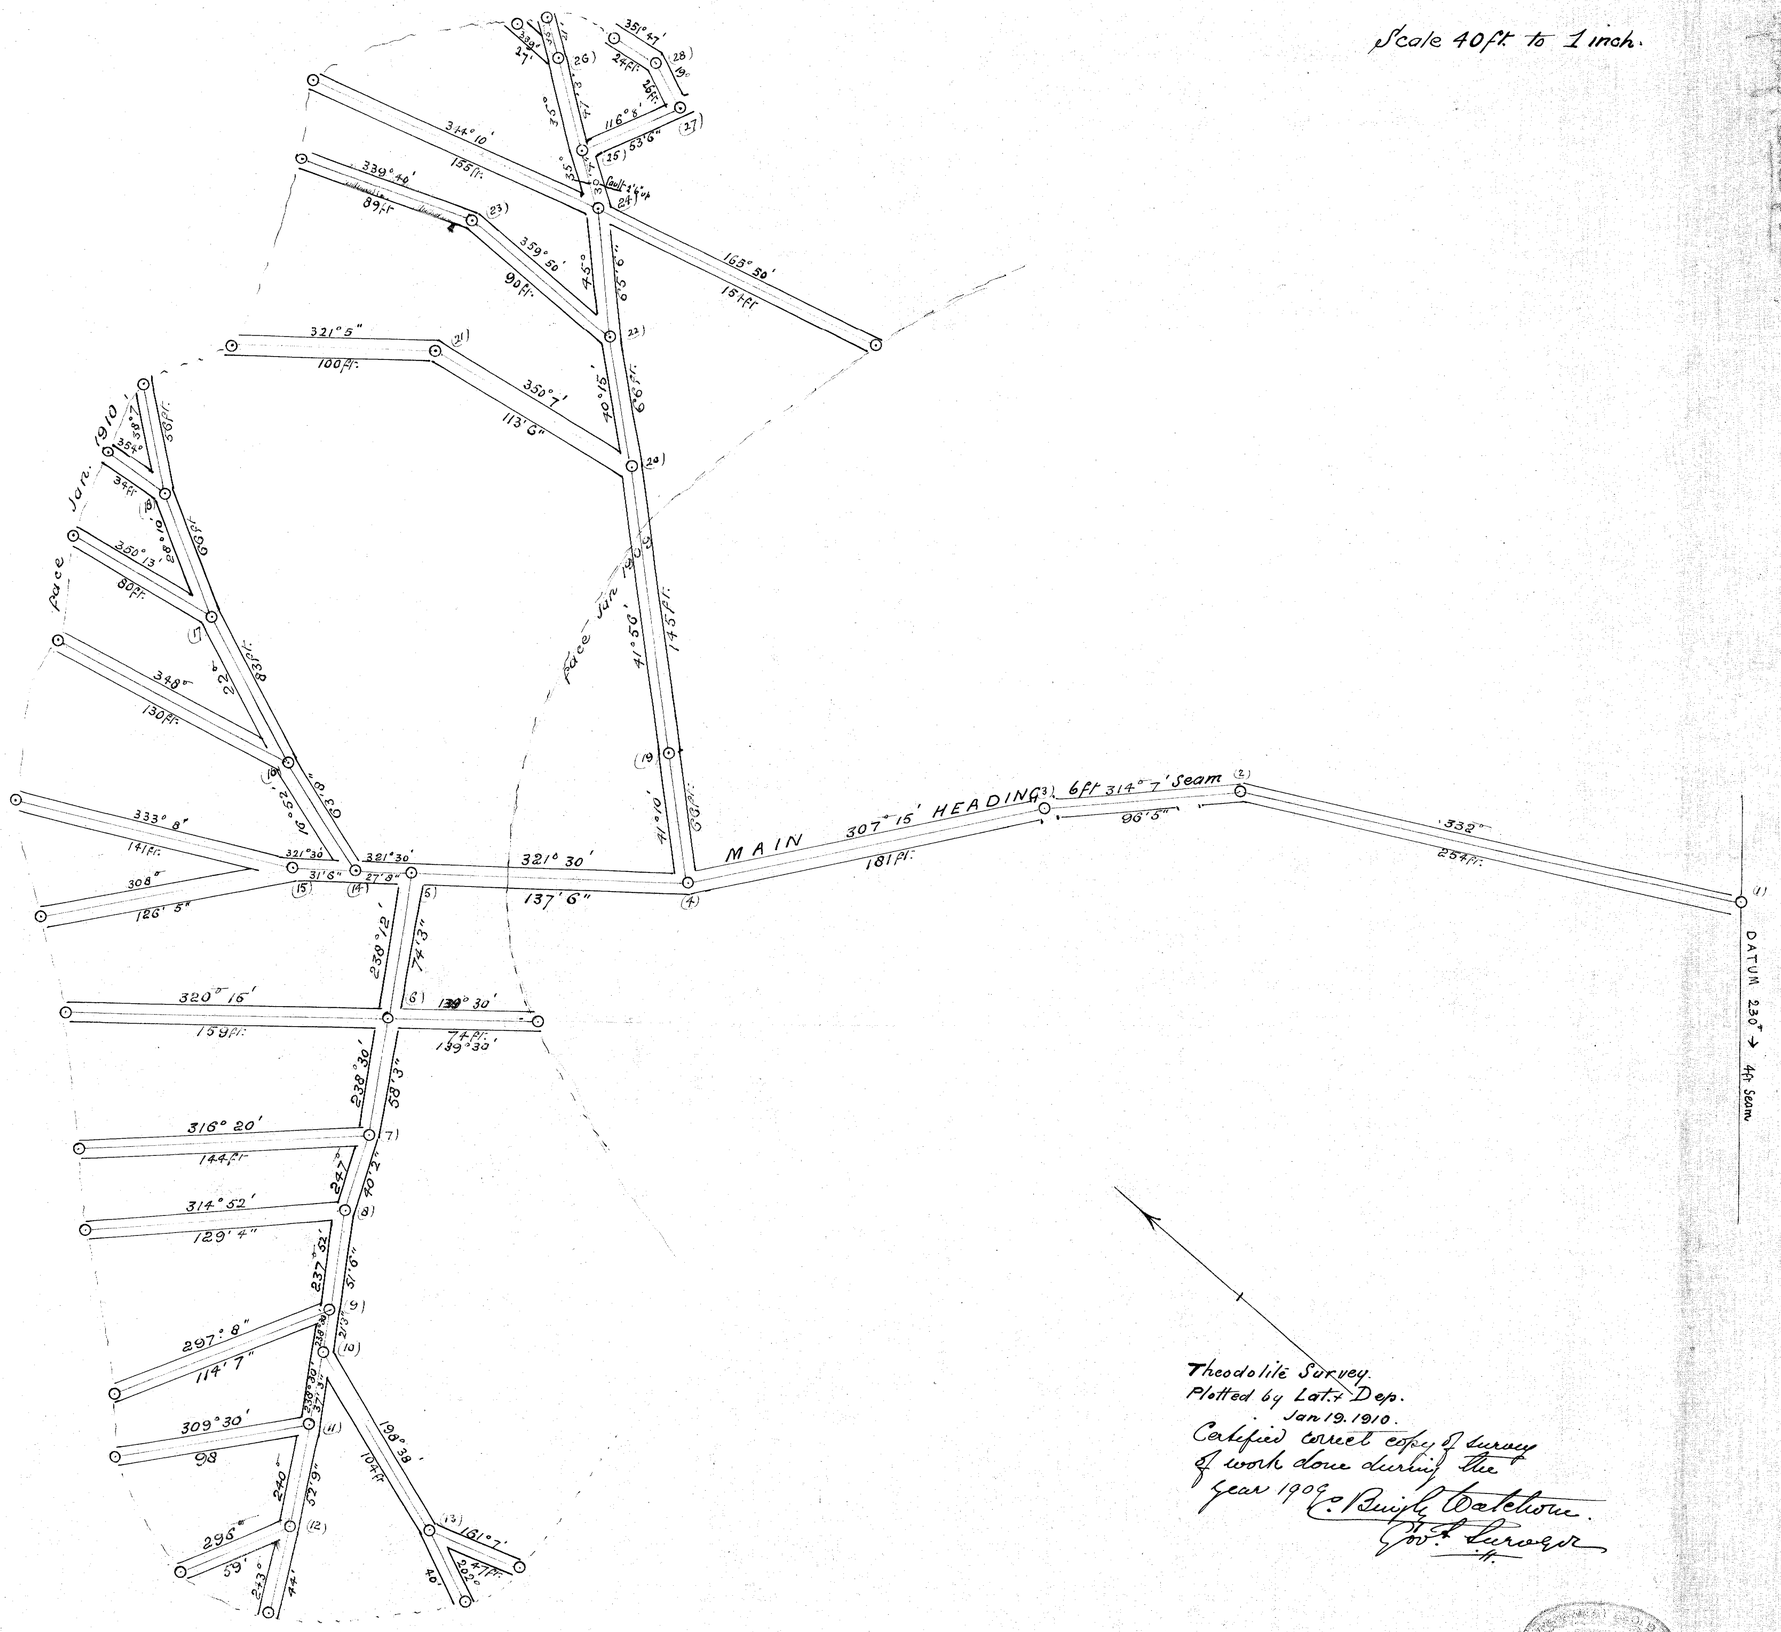

186-17

186-17

5 cm