


186-19

5 cm

MOUNT NICHOLAS COLLIERY.

Plan of extension of workings for Year 1912.

Scale = 2 chains to one inch.

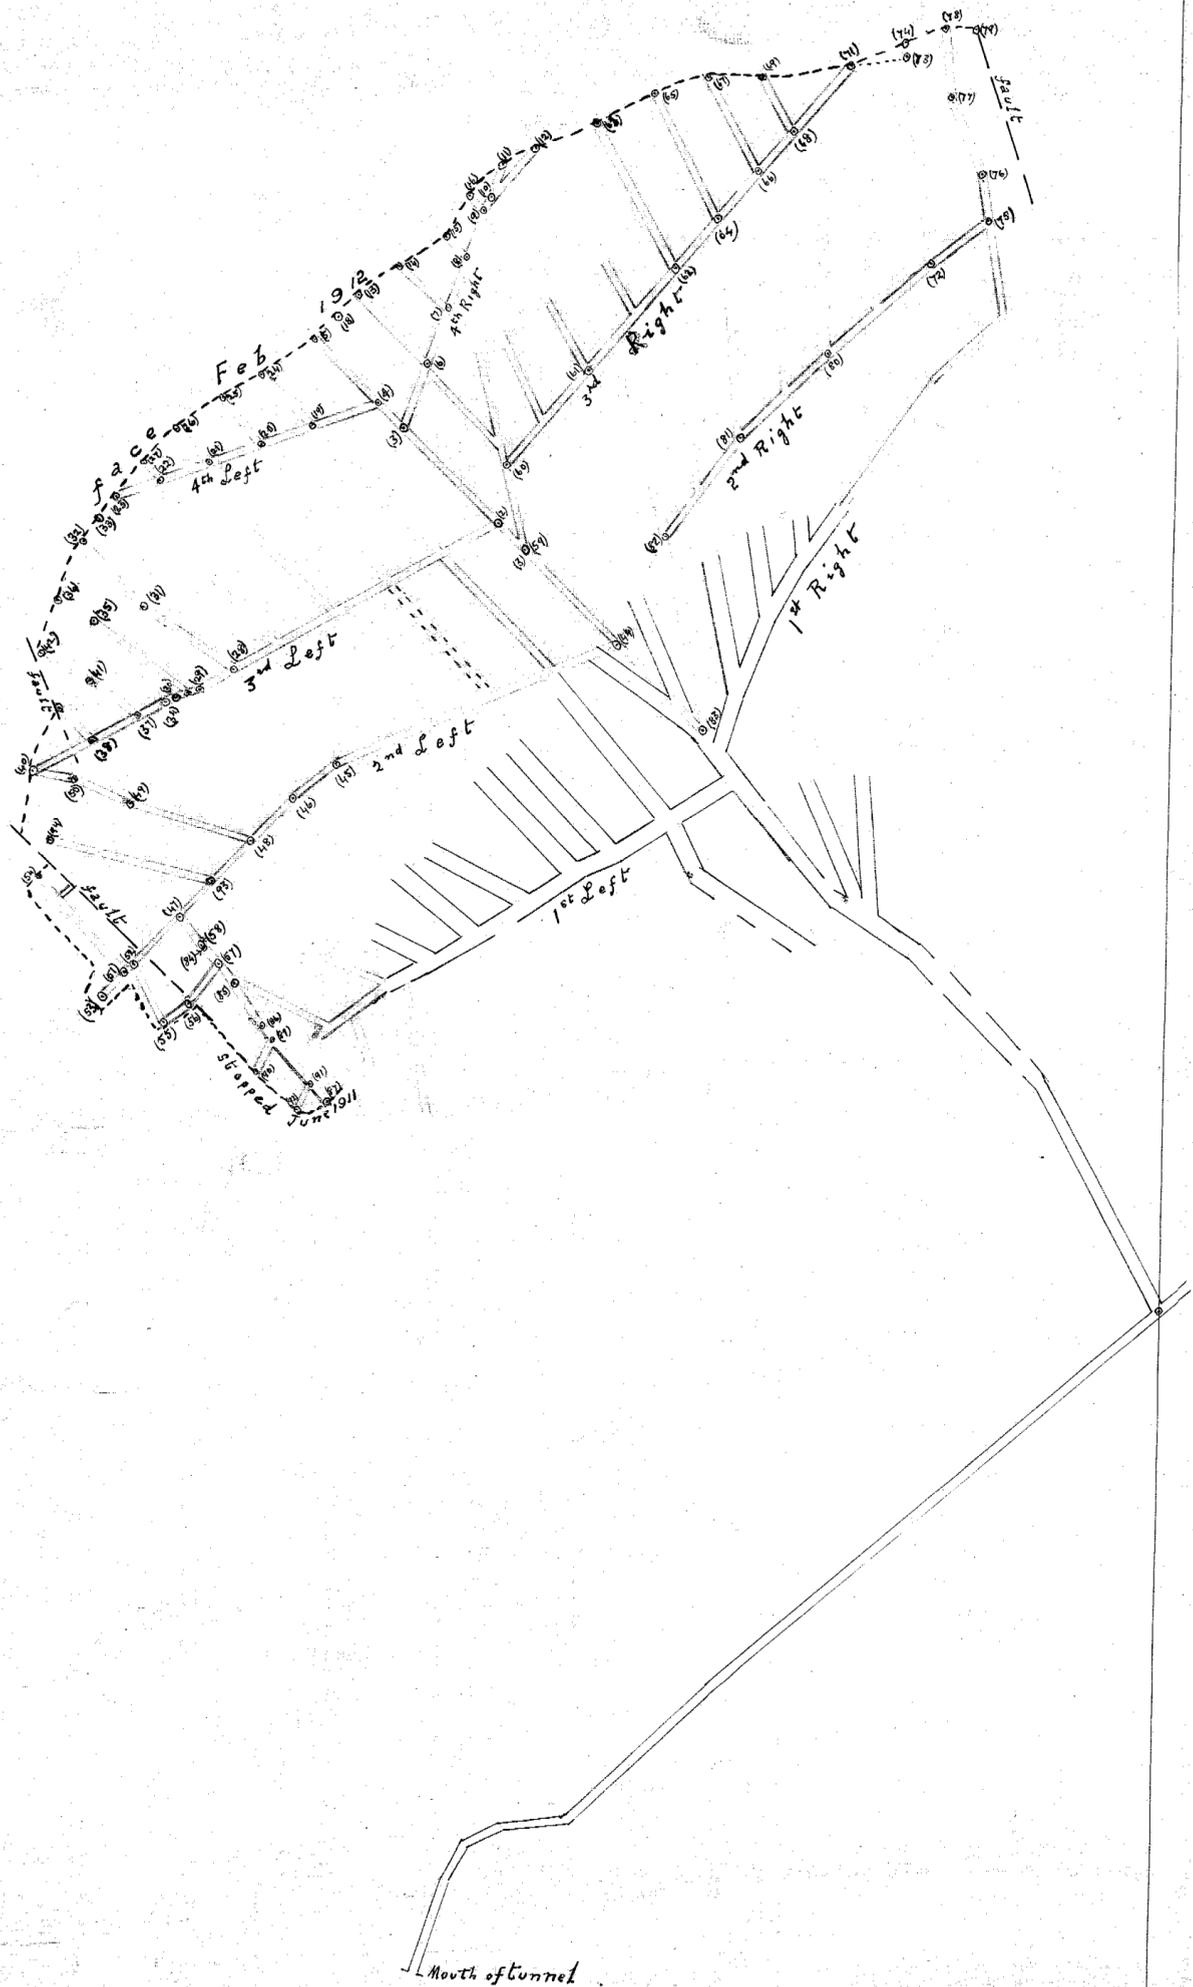

Wm Ledger  
March 14, 1912

158

158