

186-22


186-22

5 cm

CORNWALL COAL COMPANY - No. 111

LEASE 1190 M

LEASE 5688 M

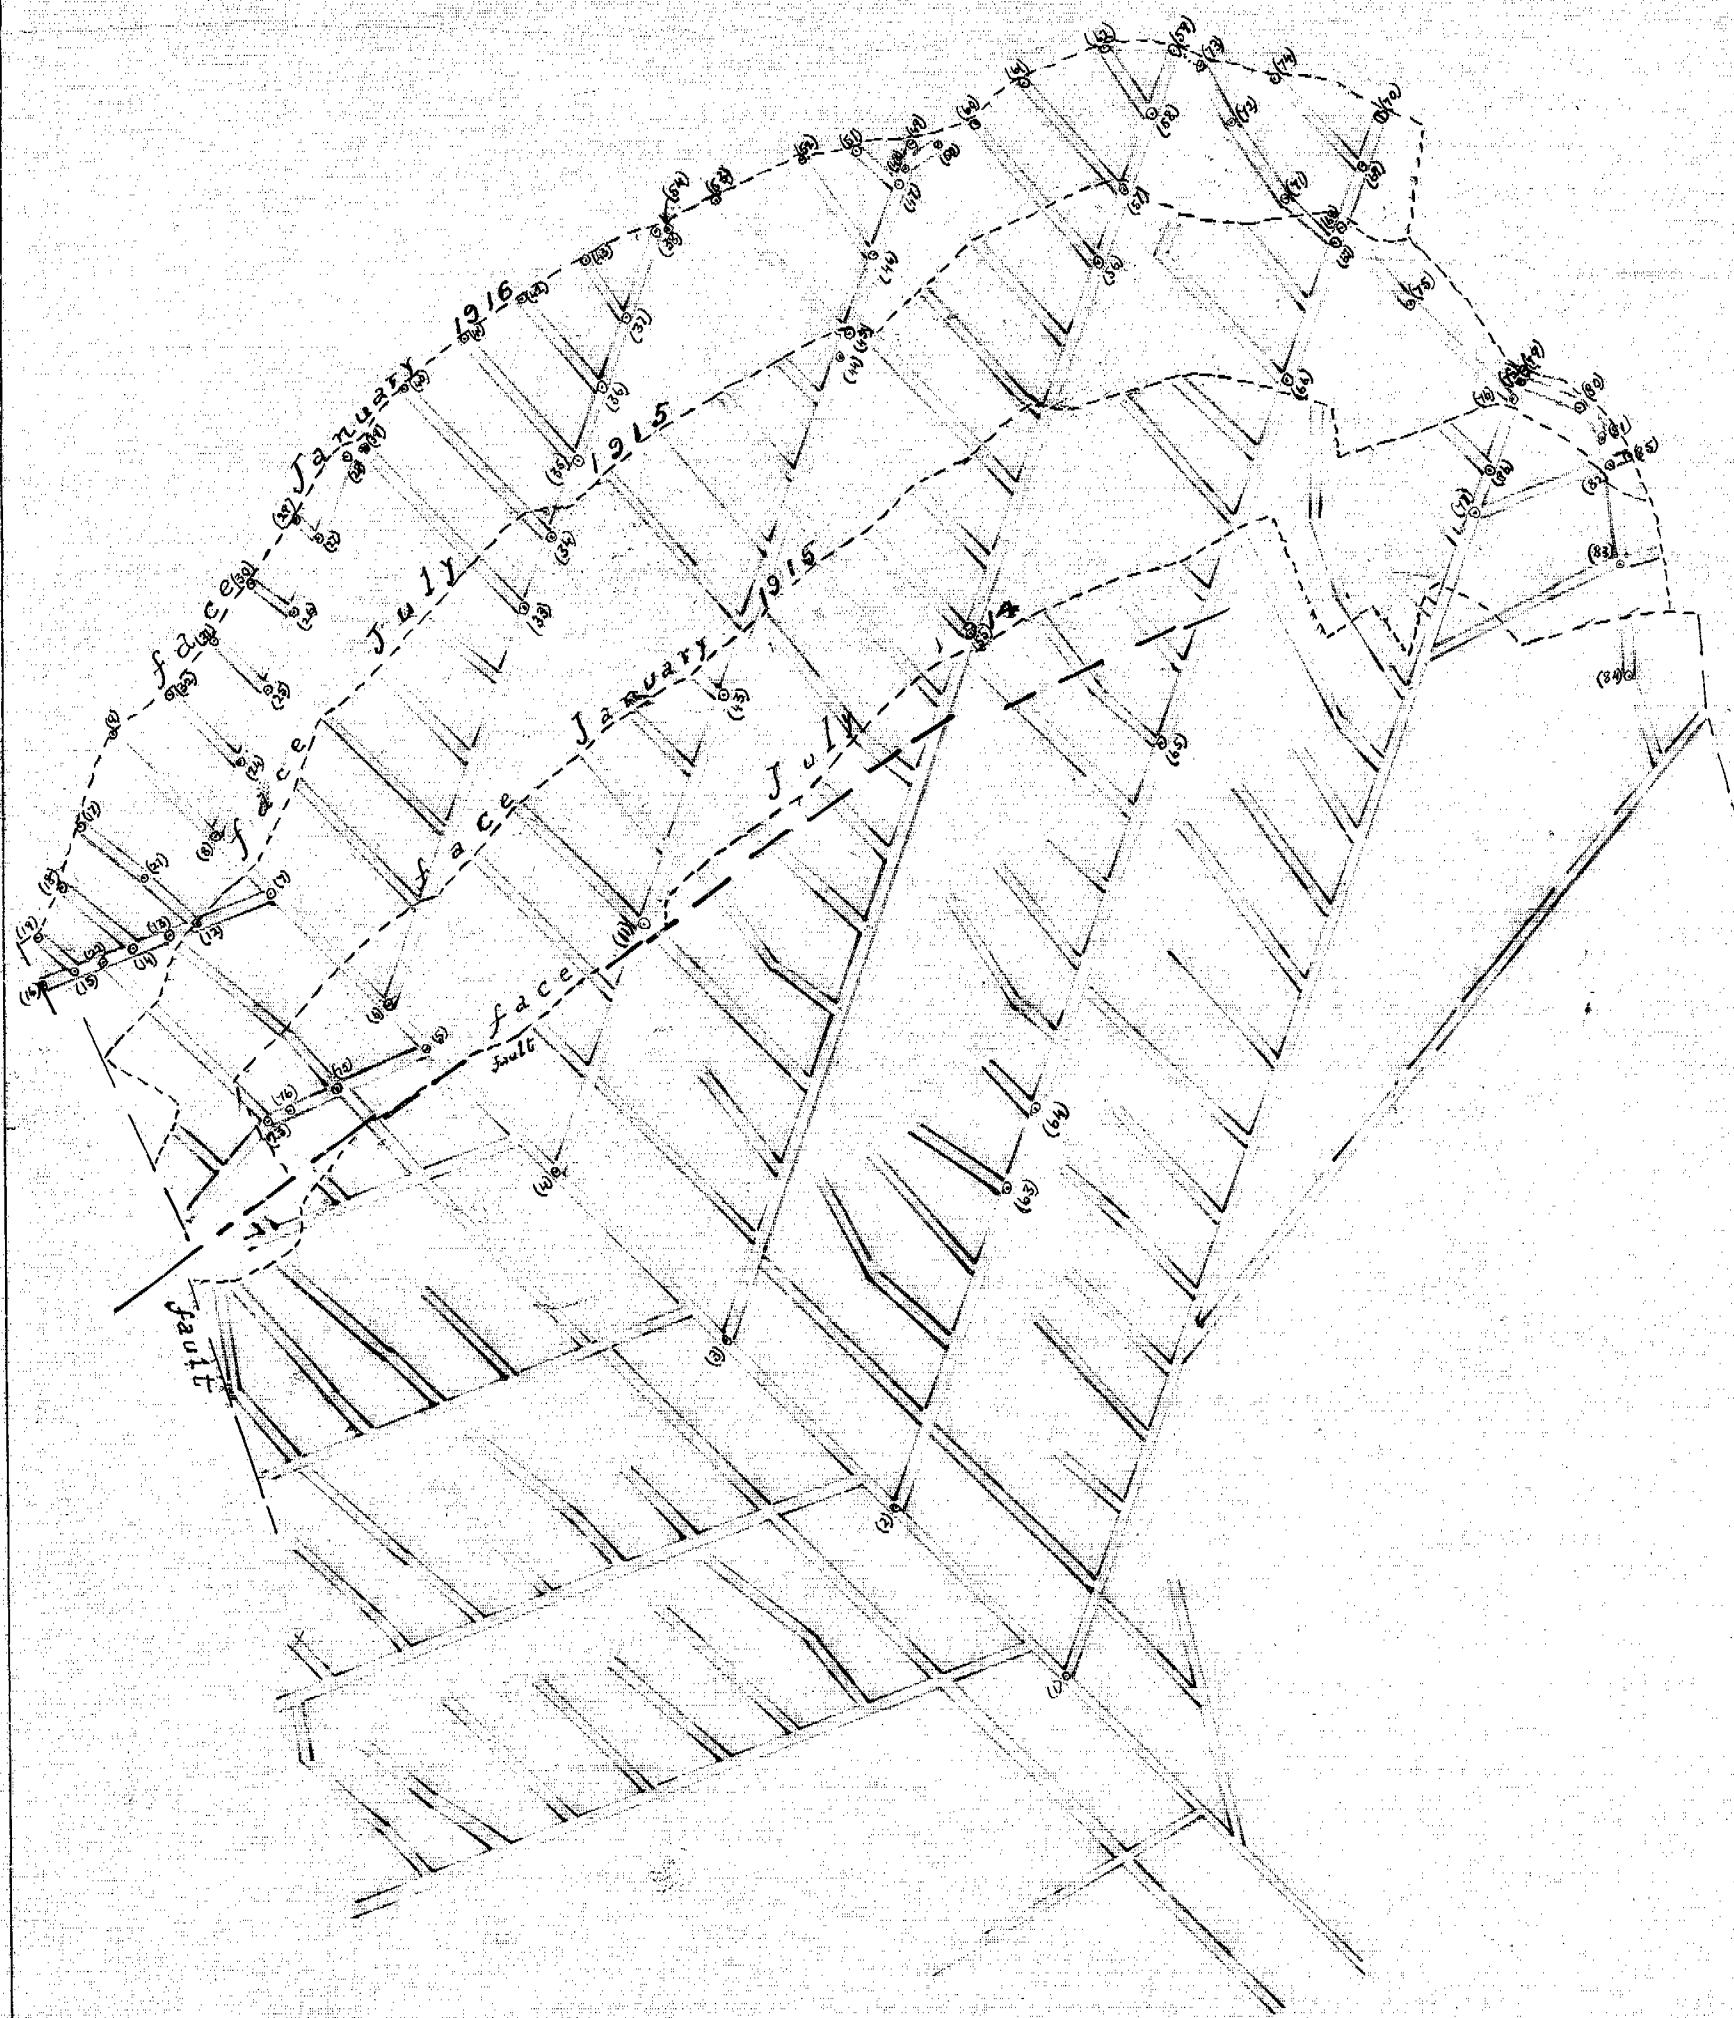

LEASE 2116

LEASE 2117

MOUNT NICHOLAS COAL COMPANY, LIMITED.

Scale = 2 chains to one inch

1915