

186

186-28


MOUNT NICHOLAS COAL COY

MOUNT NICHOLAS COAL COY

6663  
M

CORNWALL COAL COY

5688  
M

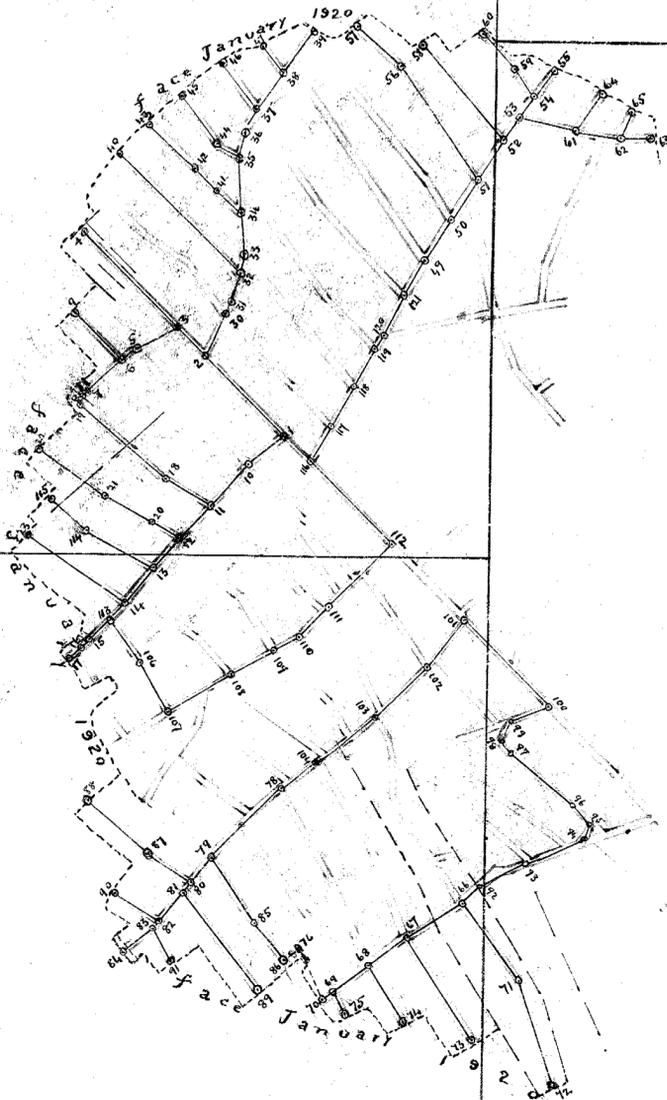

LEASE 2116

LEASE 2117

MOUNT NICHOLA COLLIERY

PLAN

Shewing Extension of Workings for Year 1919

Scale = 2 chains to one inch

