


5cm

186-32

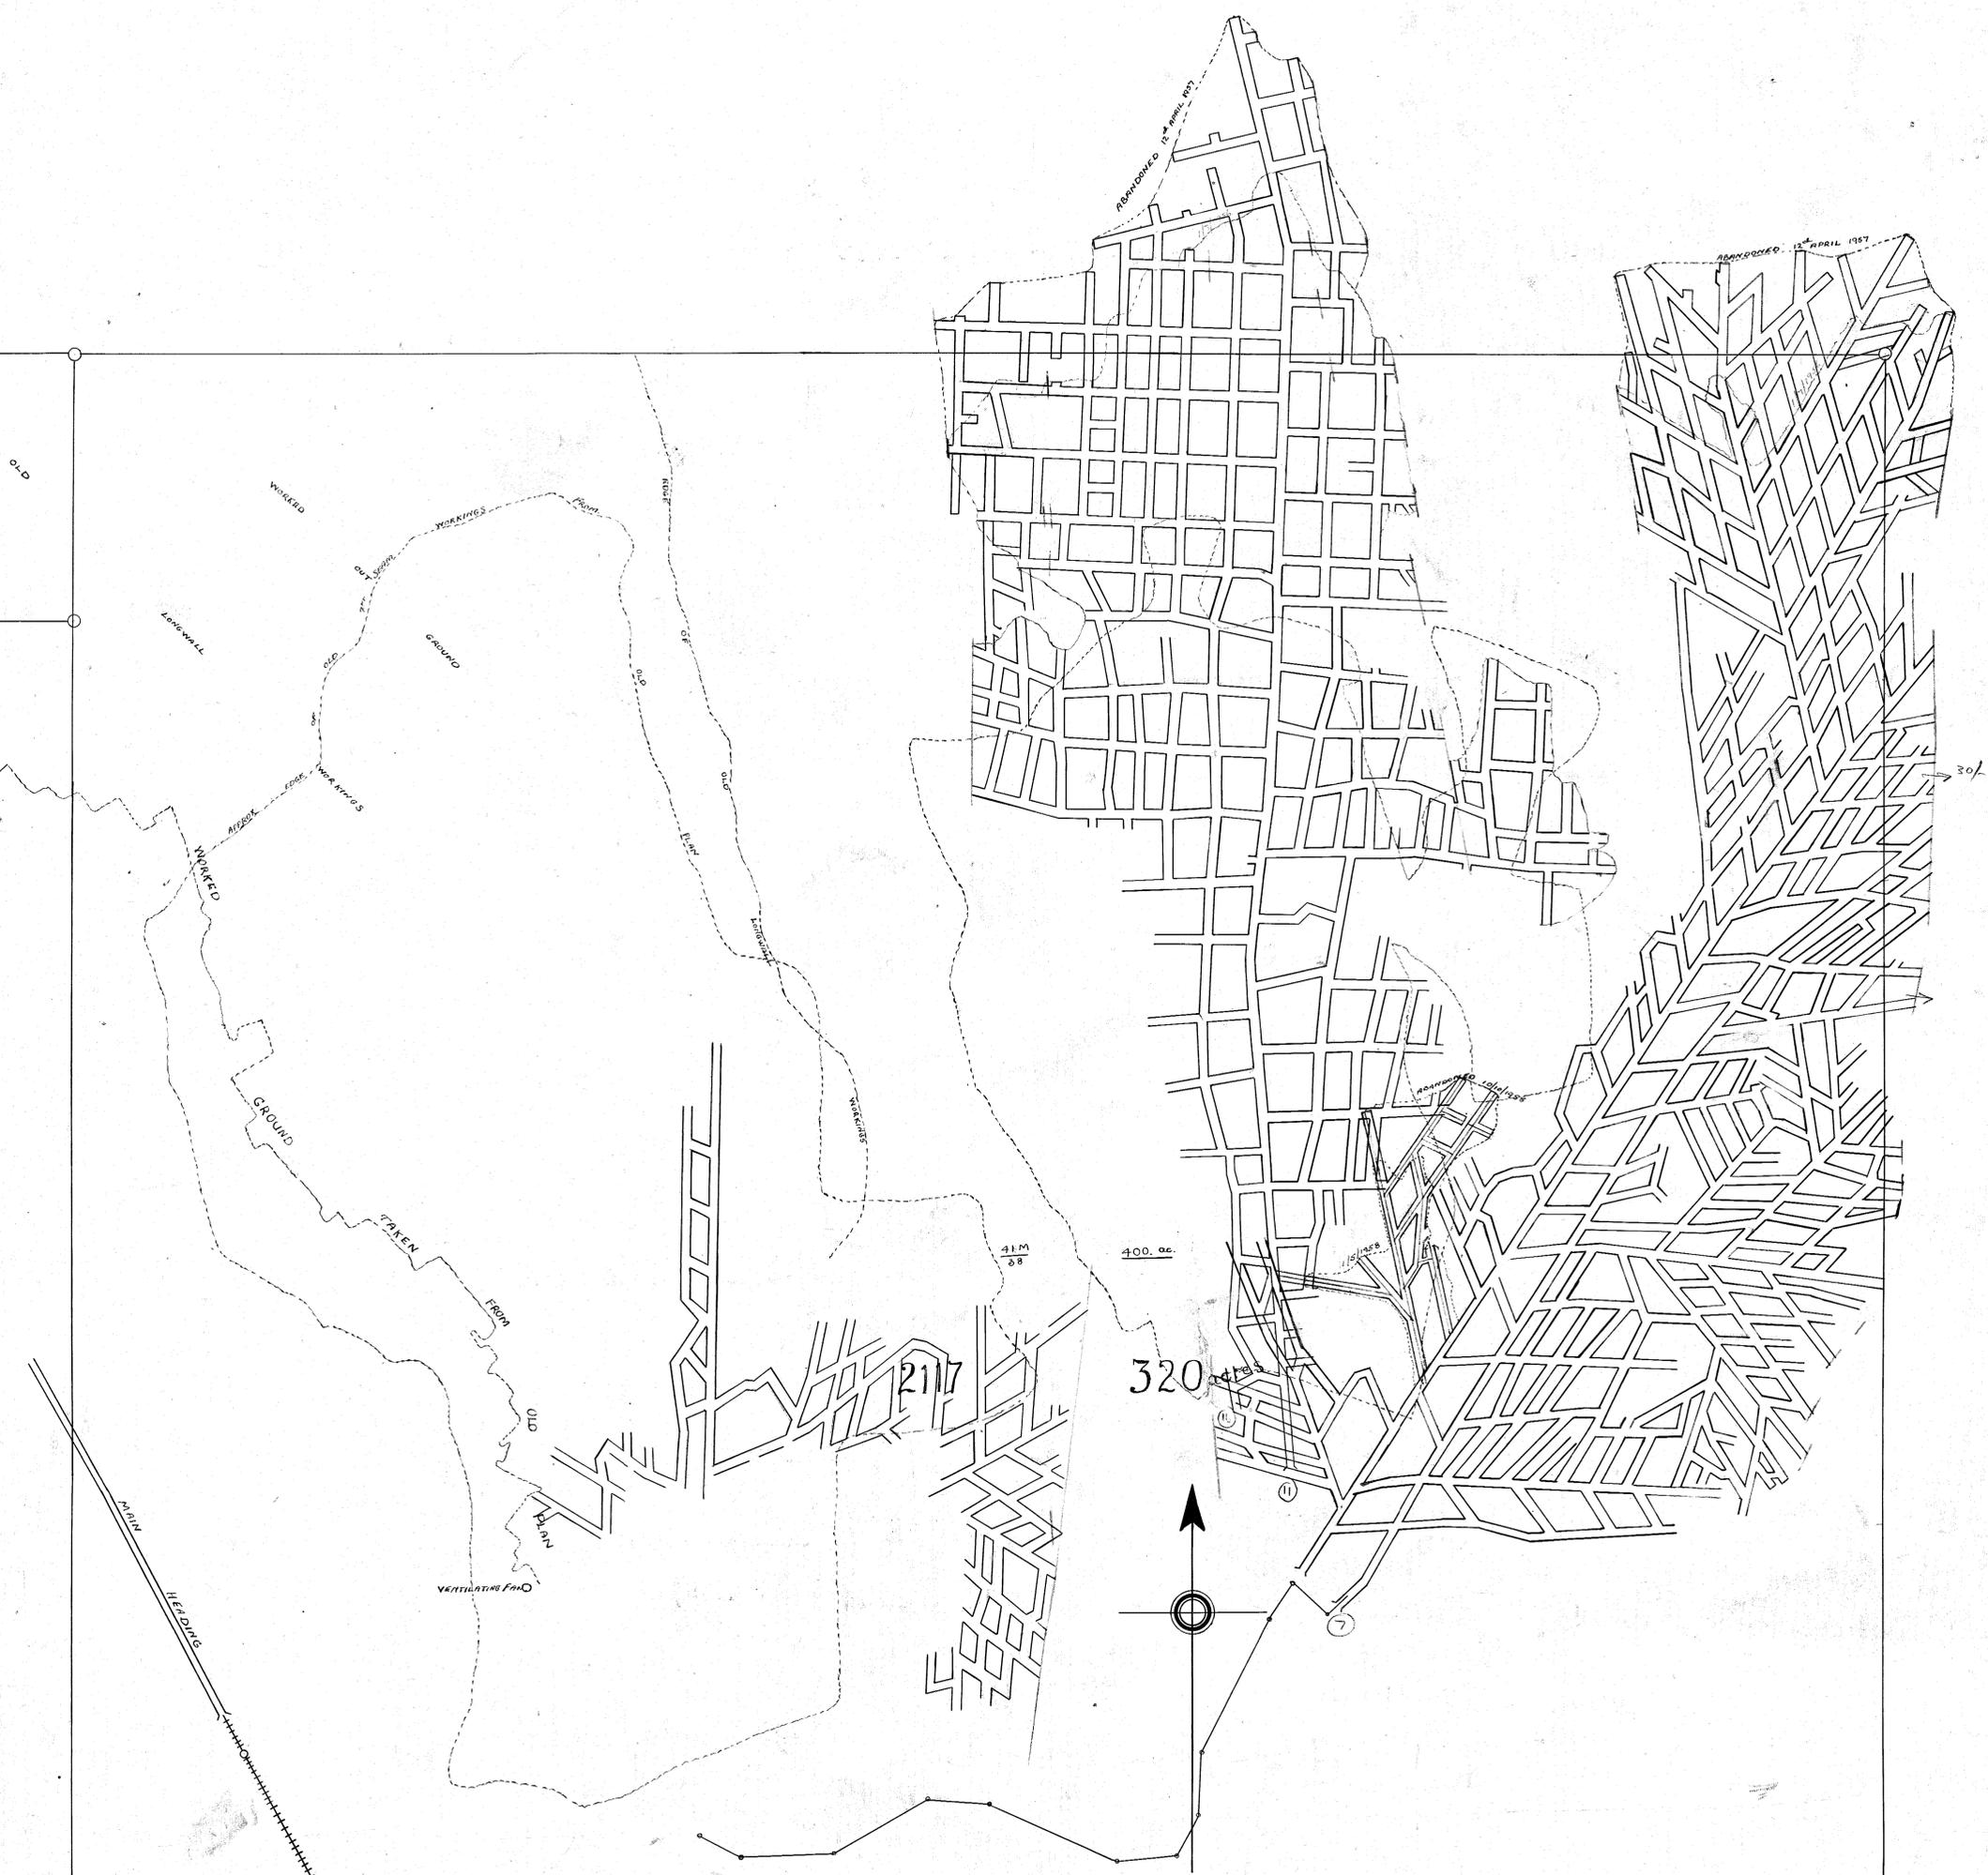

Scale 2 Chains to an Inch