


5888t pencil drawing

187-02

187-02

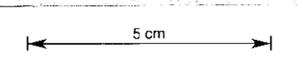

CORNWALL COAL MINE

Fragmentary

Plan.

*Showing the extensions of workings
effected during the 6 months ending*

July 31. 1893.

*Thos. Atiles
Mine. Supt.*

101

101