187-11

5 cm

187-11

CORNWALL COLLIERY

UPPER WORKINGS

SCALE 1 CHAIN TO 1 INCH

DOTTED LINES SHOW LOWER WORKINGS

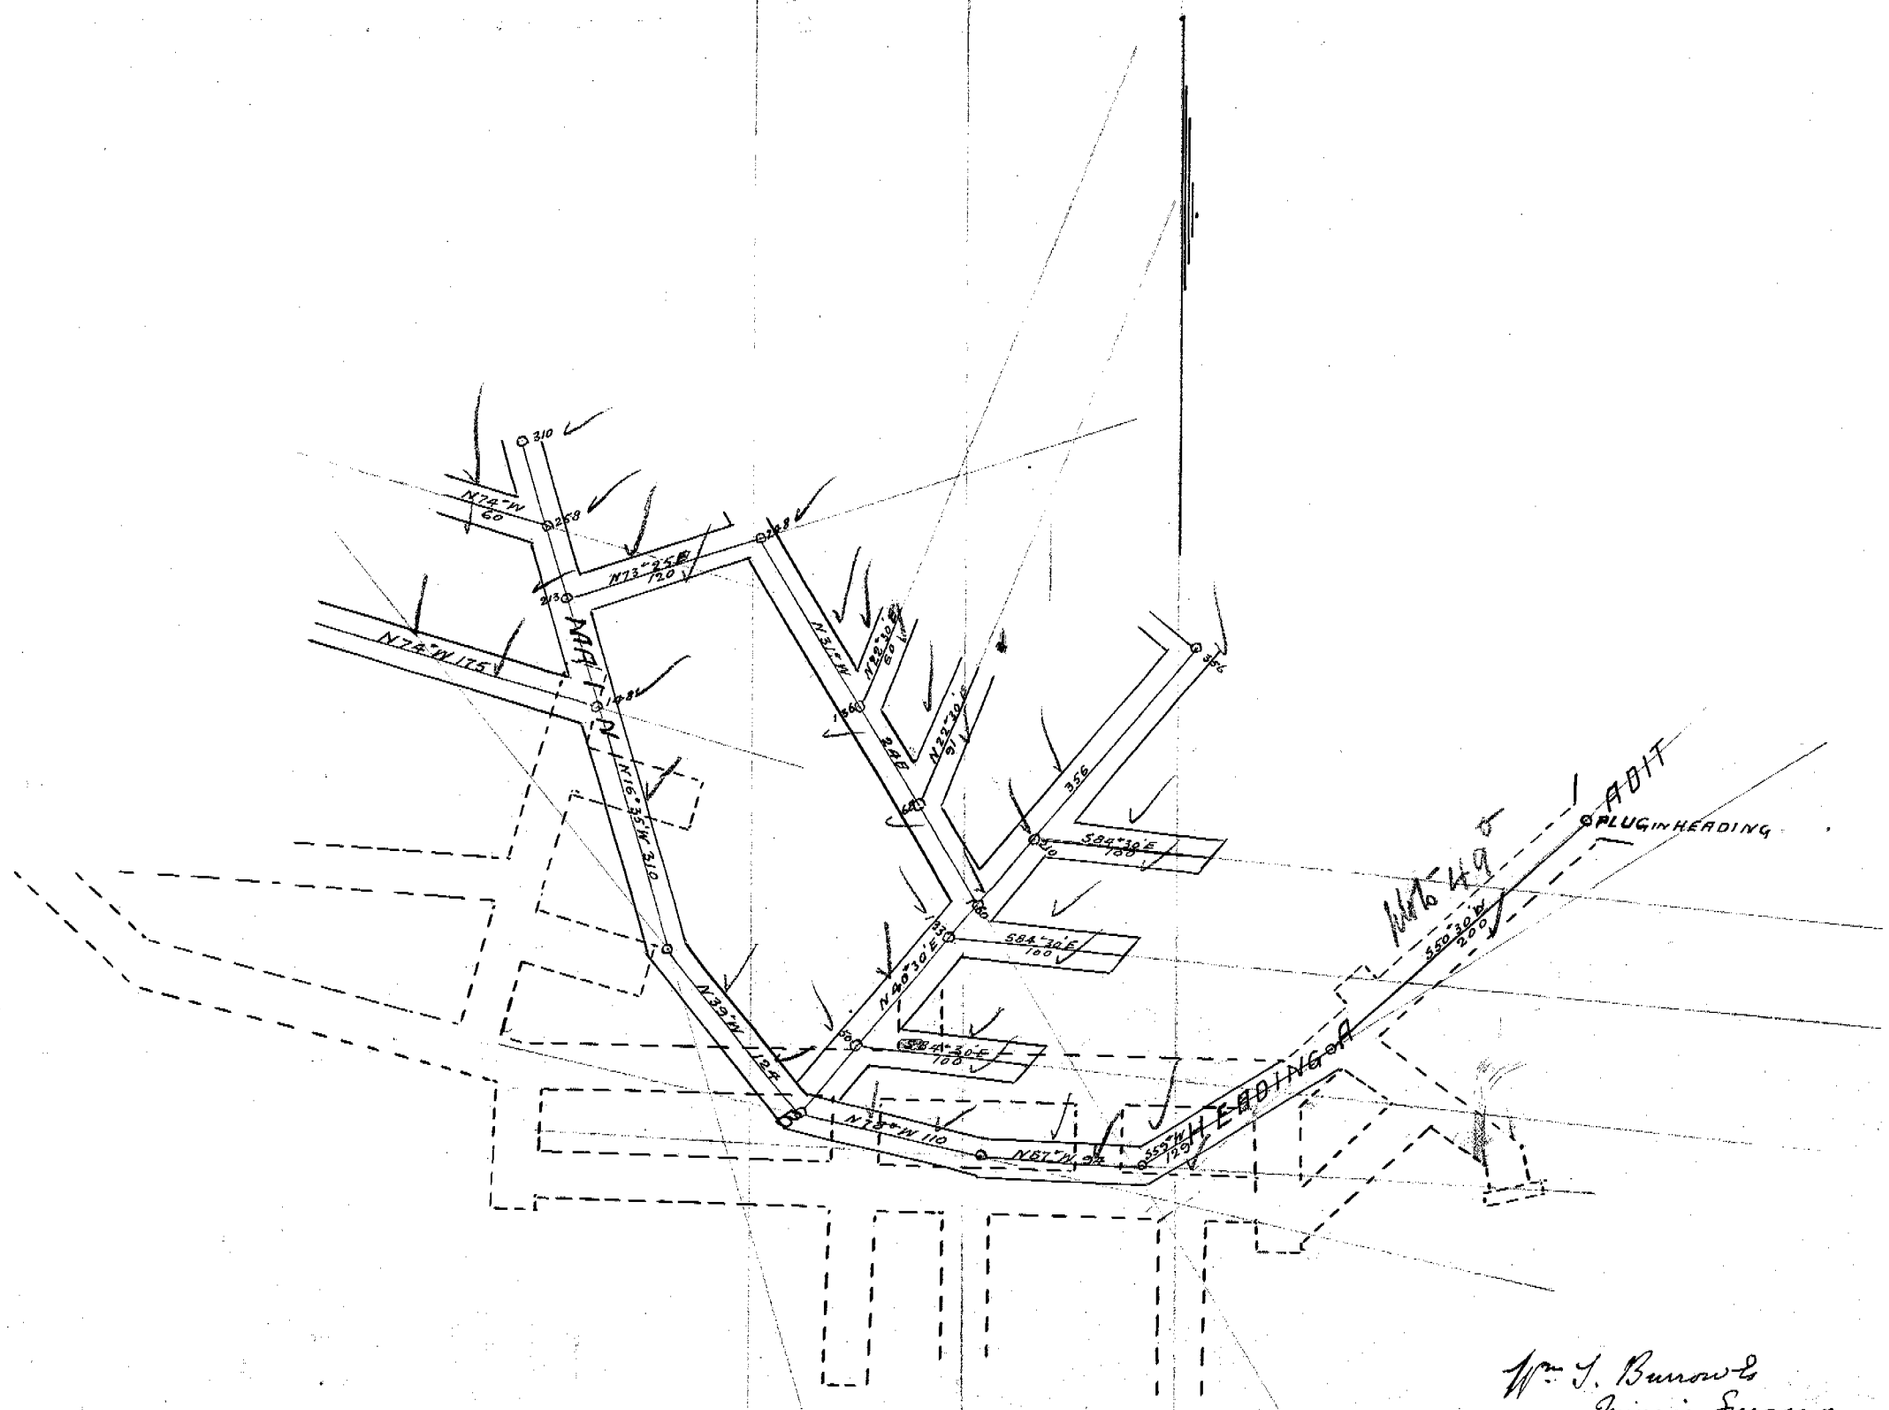

Wm. J. Burrowes
Mining Surveyor
21st. Feby 1900

Theodolite used
W.J.B.