CORNWALL COLLIERY

Scale 1ch to 1inch
Correct copy of
Work done during 1907.
Survey with theodolite
C. Brigly Watchorn
24. 1. 08

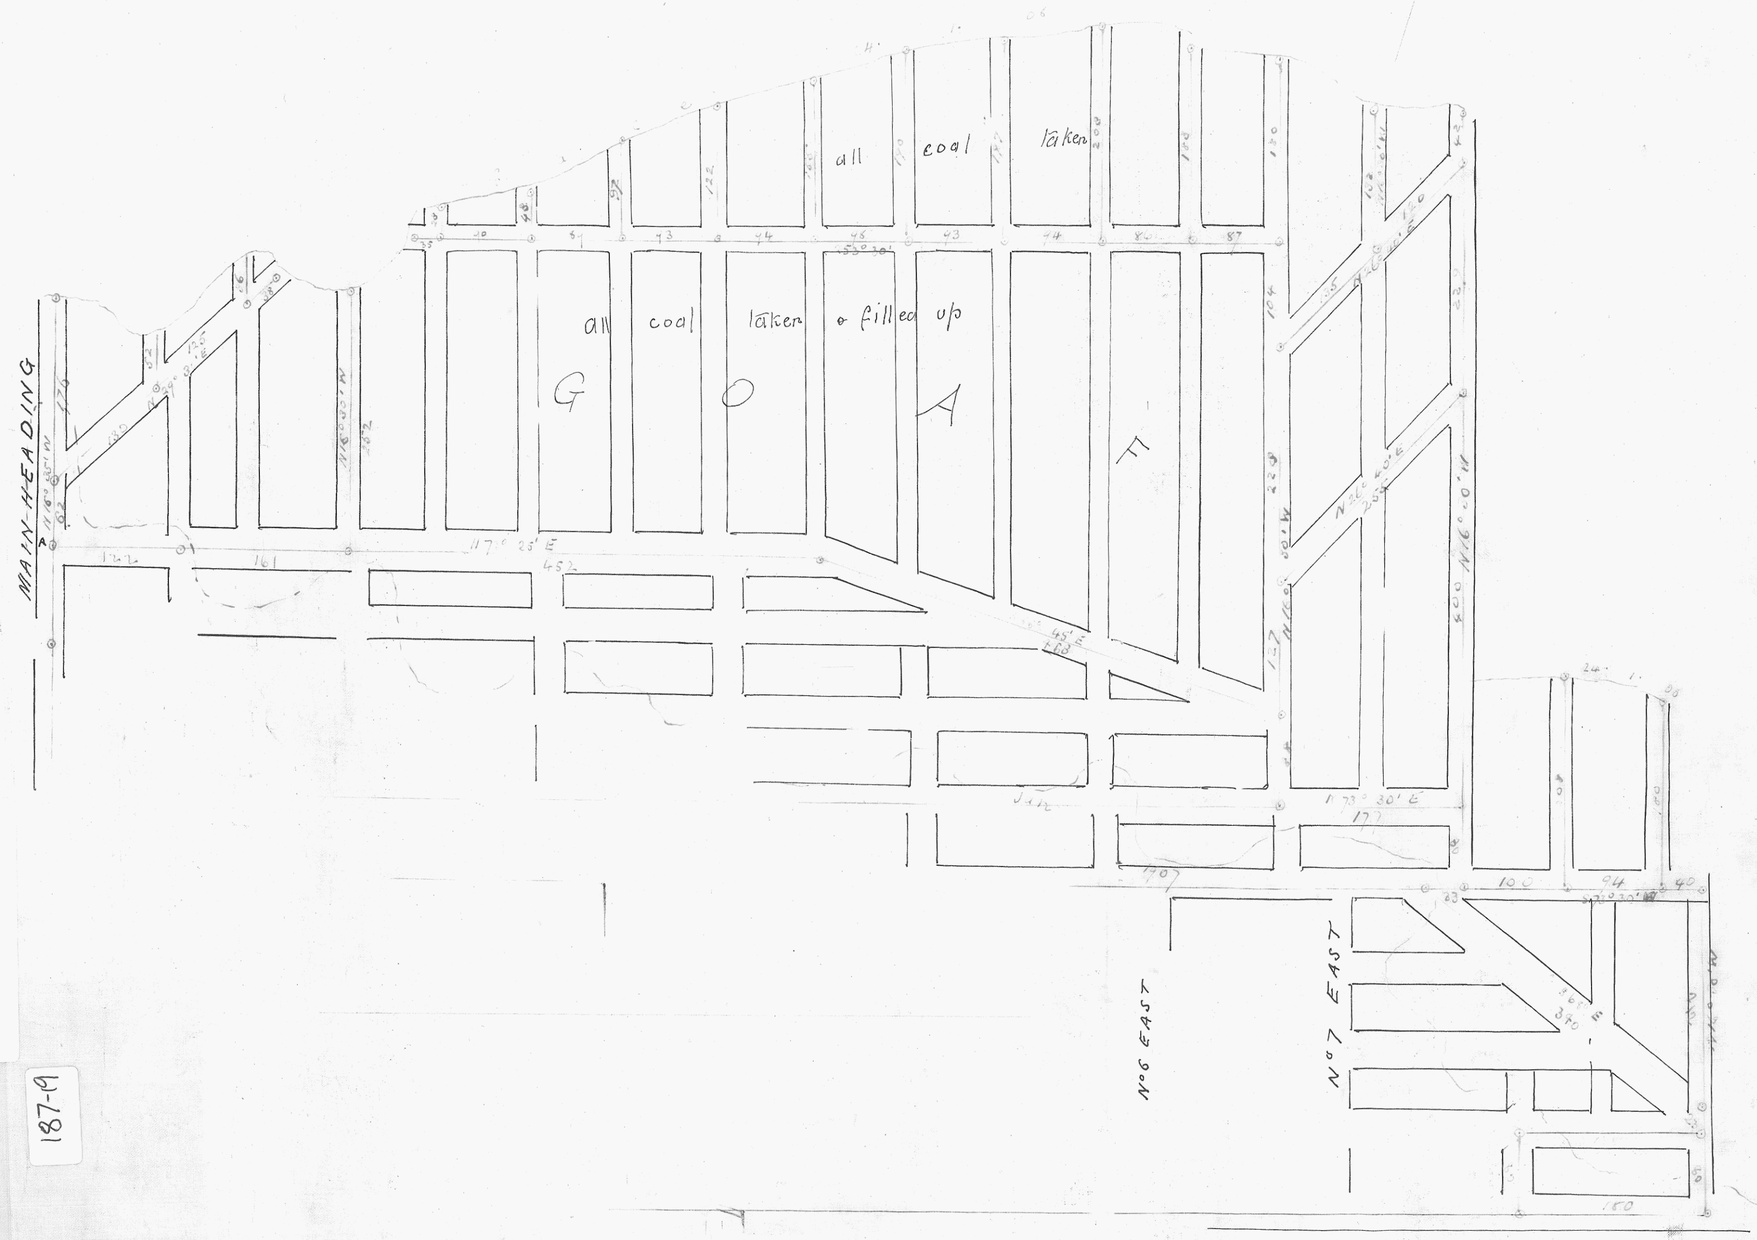

187-19
187-19
Inspector of Mines
Mar 1908