# CORNWALL COLLIERY

Scale 1 ch. to 1 inch

Plotted by Lat + Dep. Surveyed with Theodolite where practicable + compass in low drives.

Certified correct copy of work done during year 1909.

C. Bingley Batchelor.
Gov't Surveyor
28.1.10

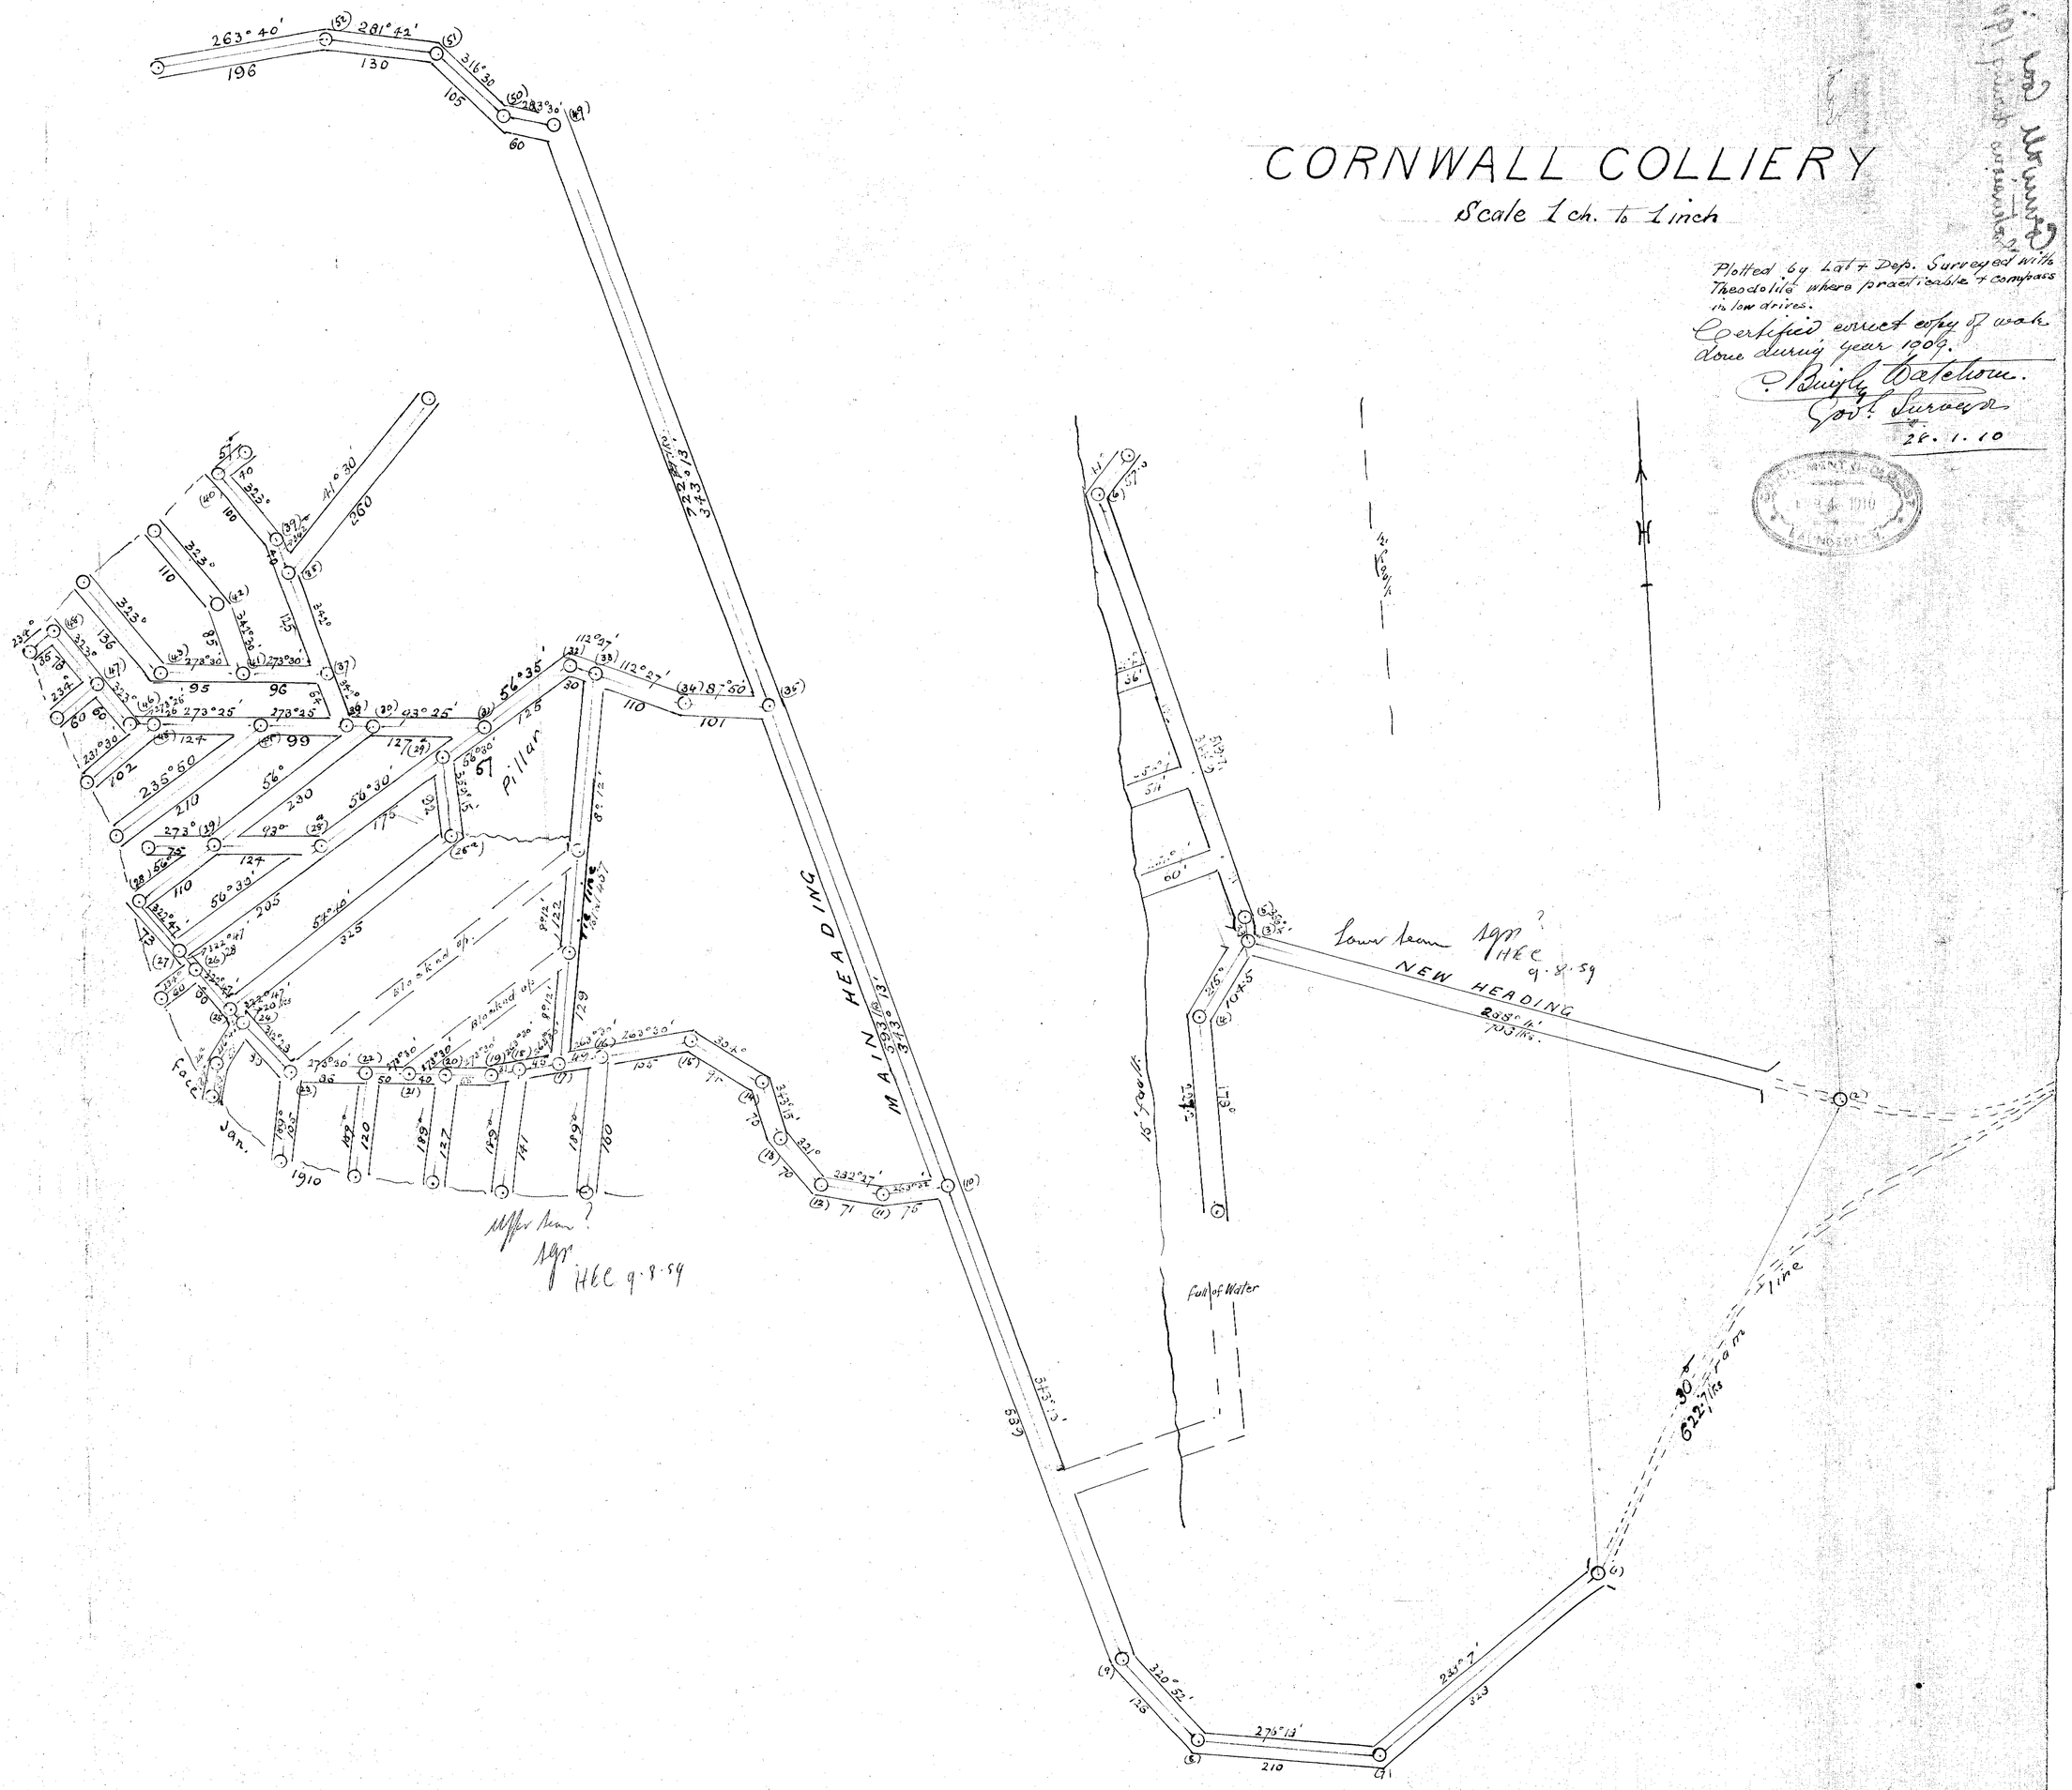


187-22

187-22