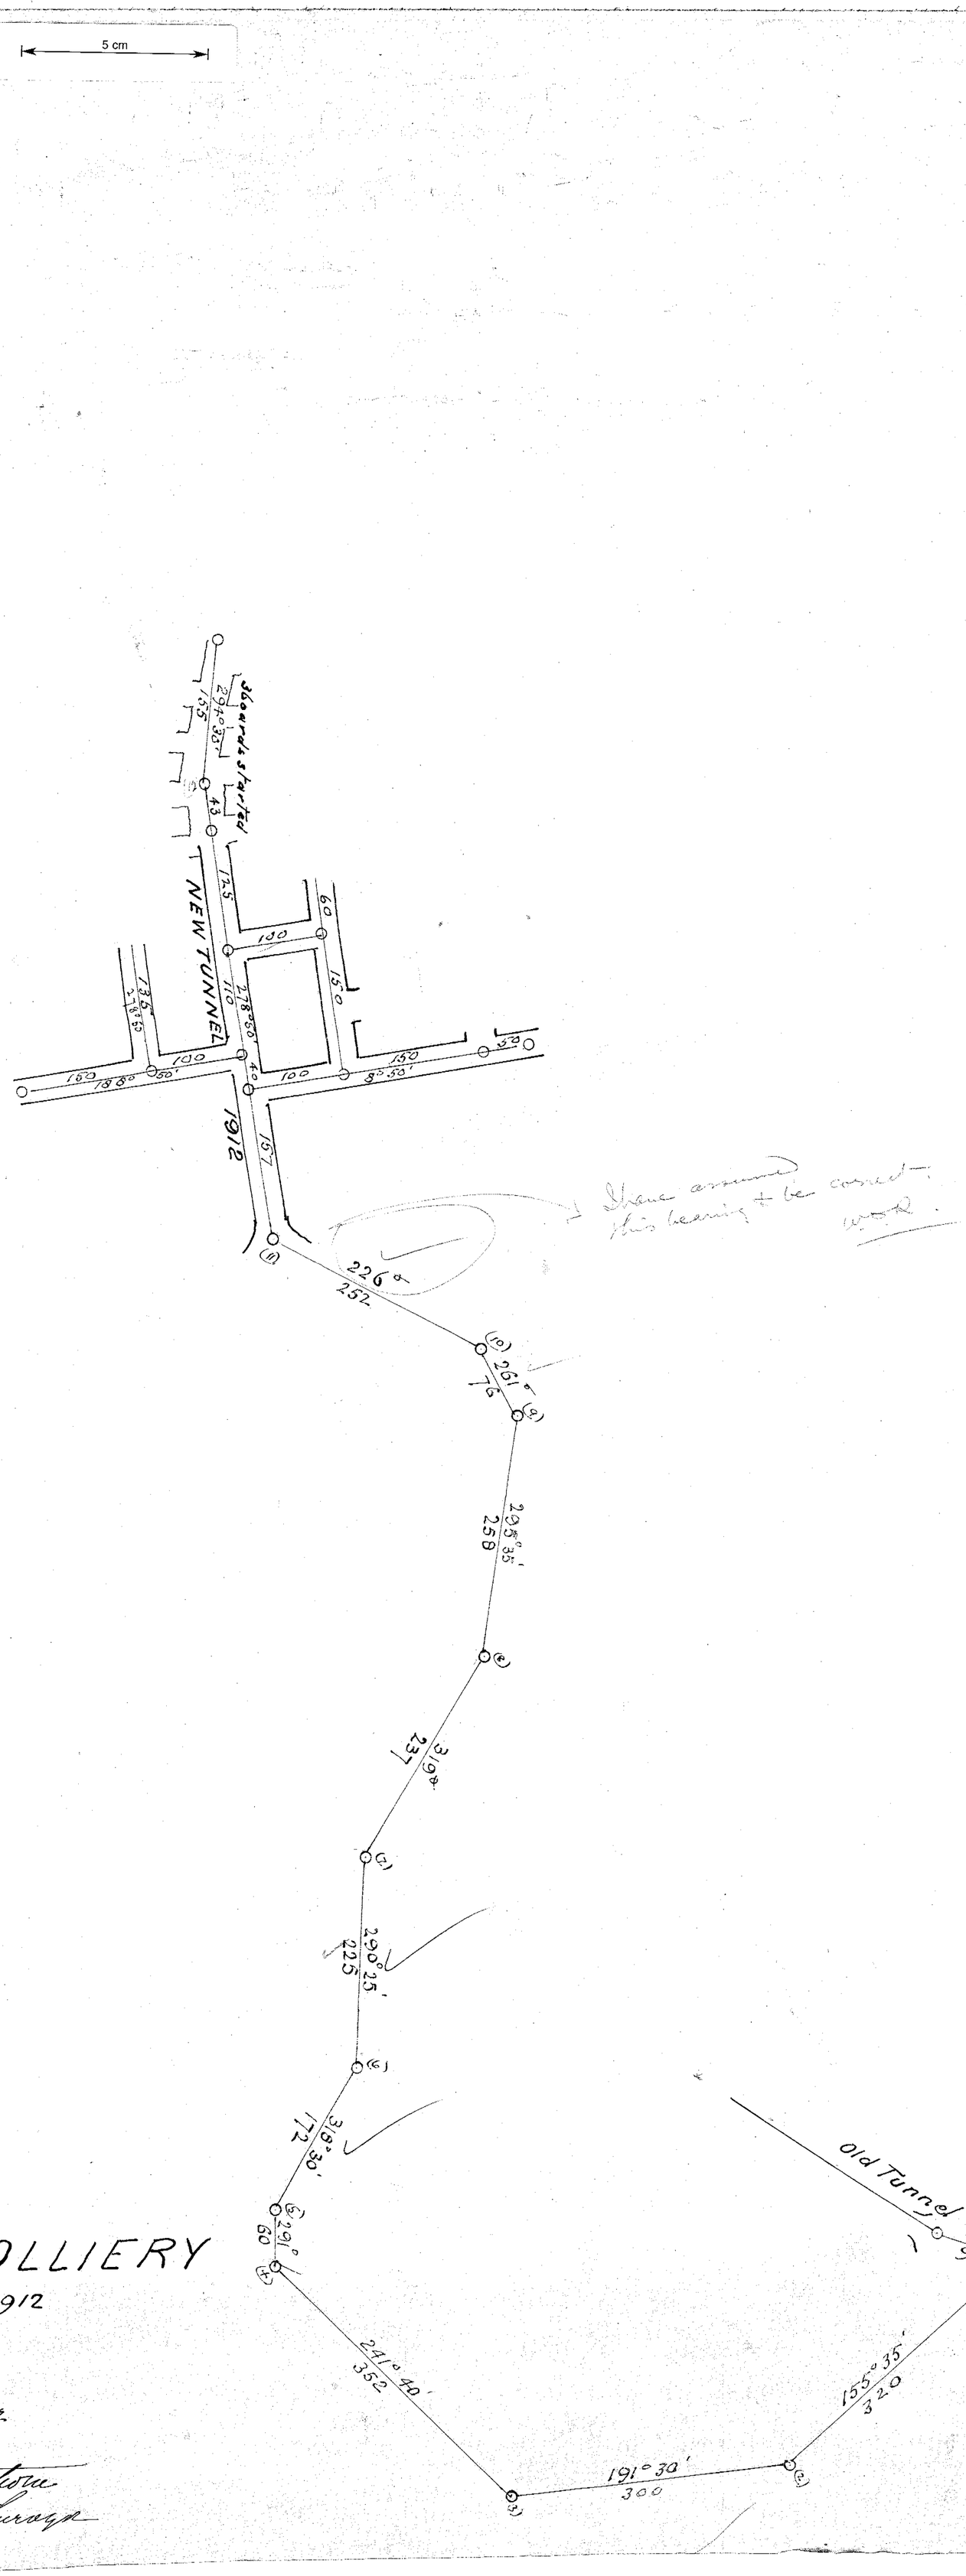

CORNWALL COLLIERY

NEW TUNNEL 1912

Scale 1ch to 1in

Work done to March 1912.
Theodolite Survey.
C. Rigby Batchelor
Govt. Surveyor