187/39

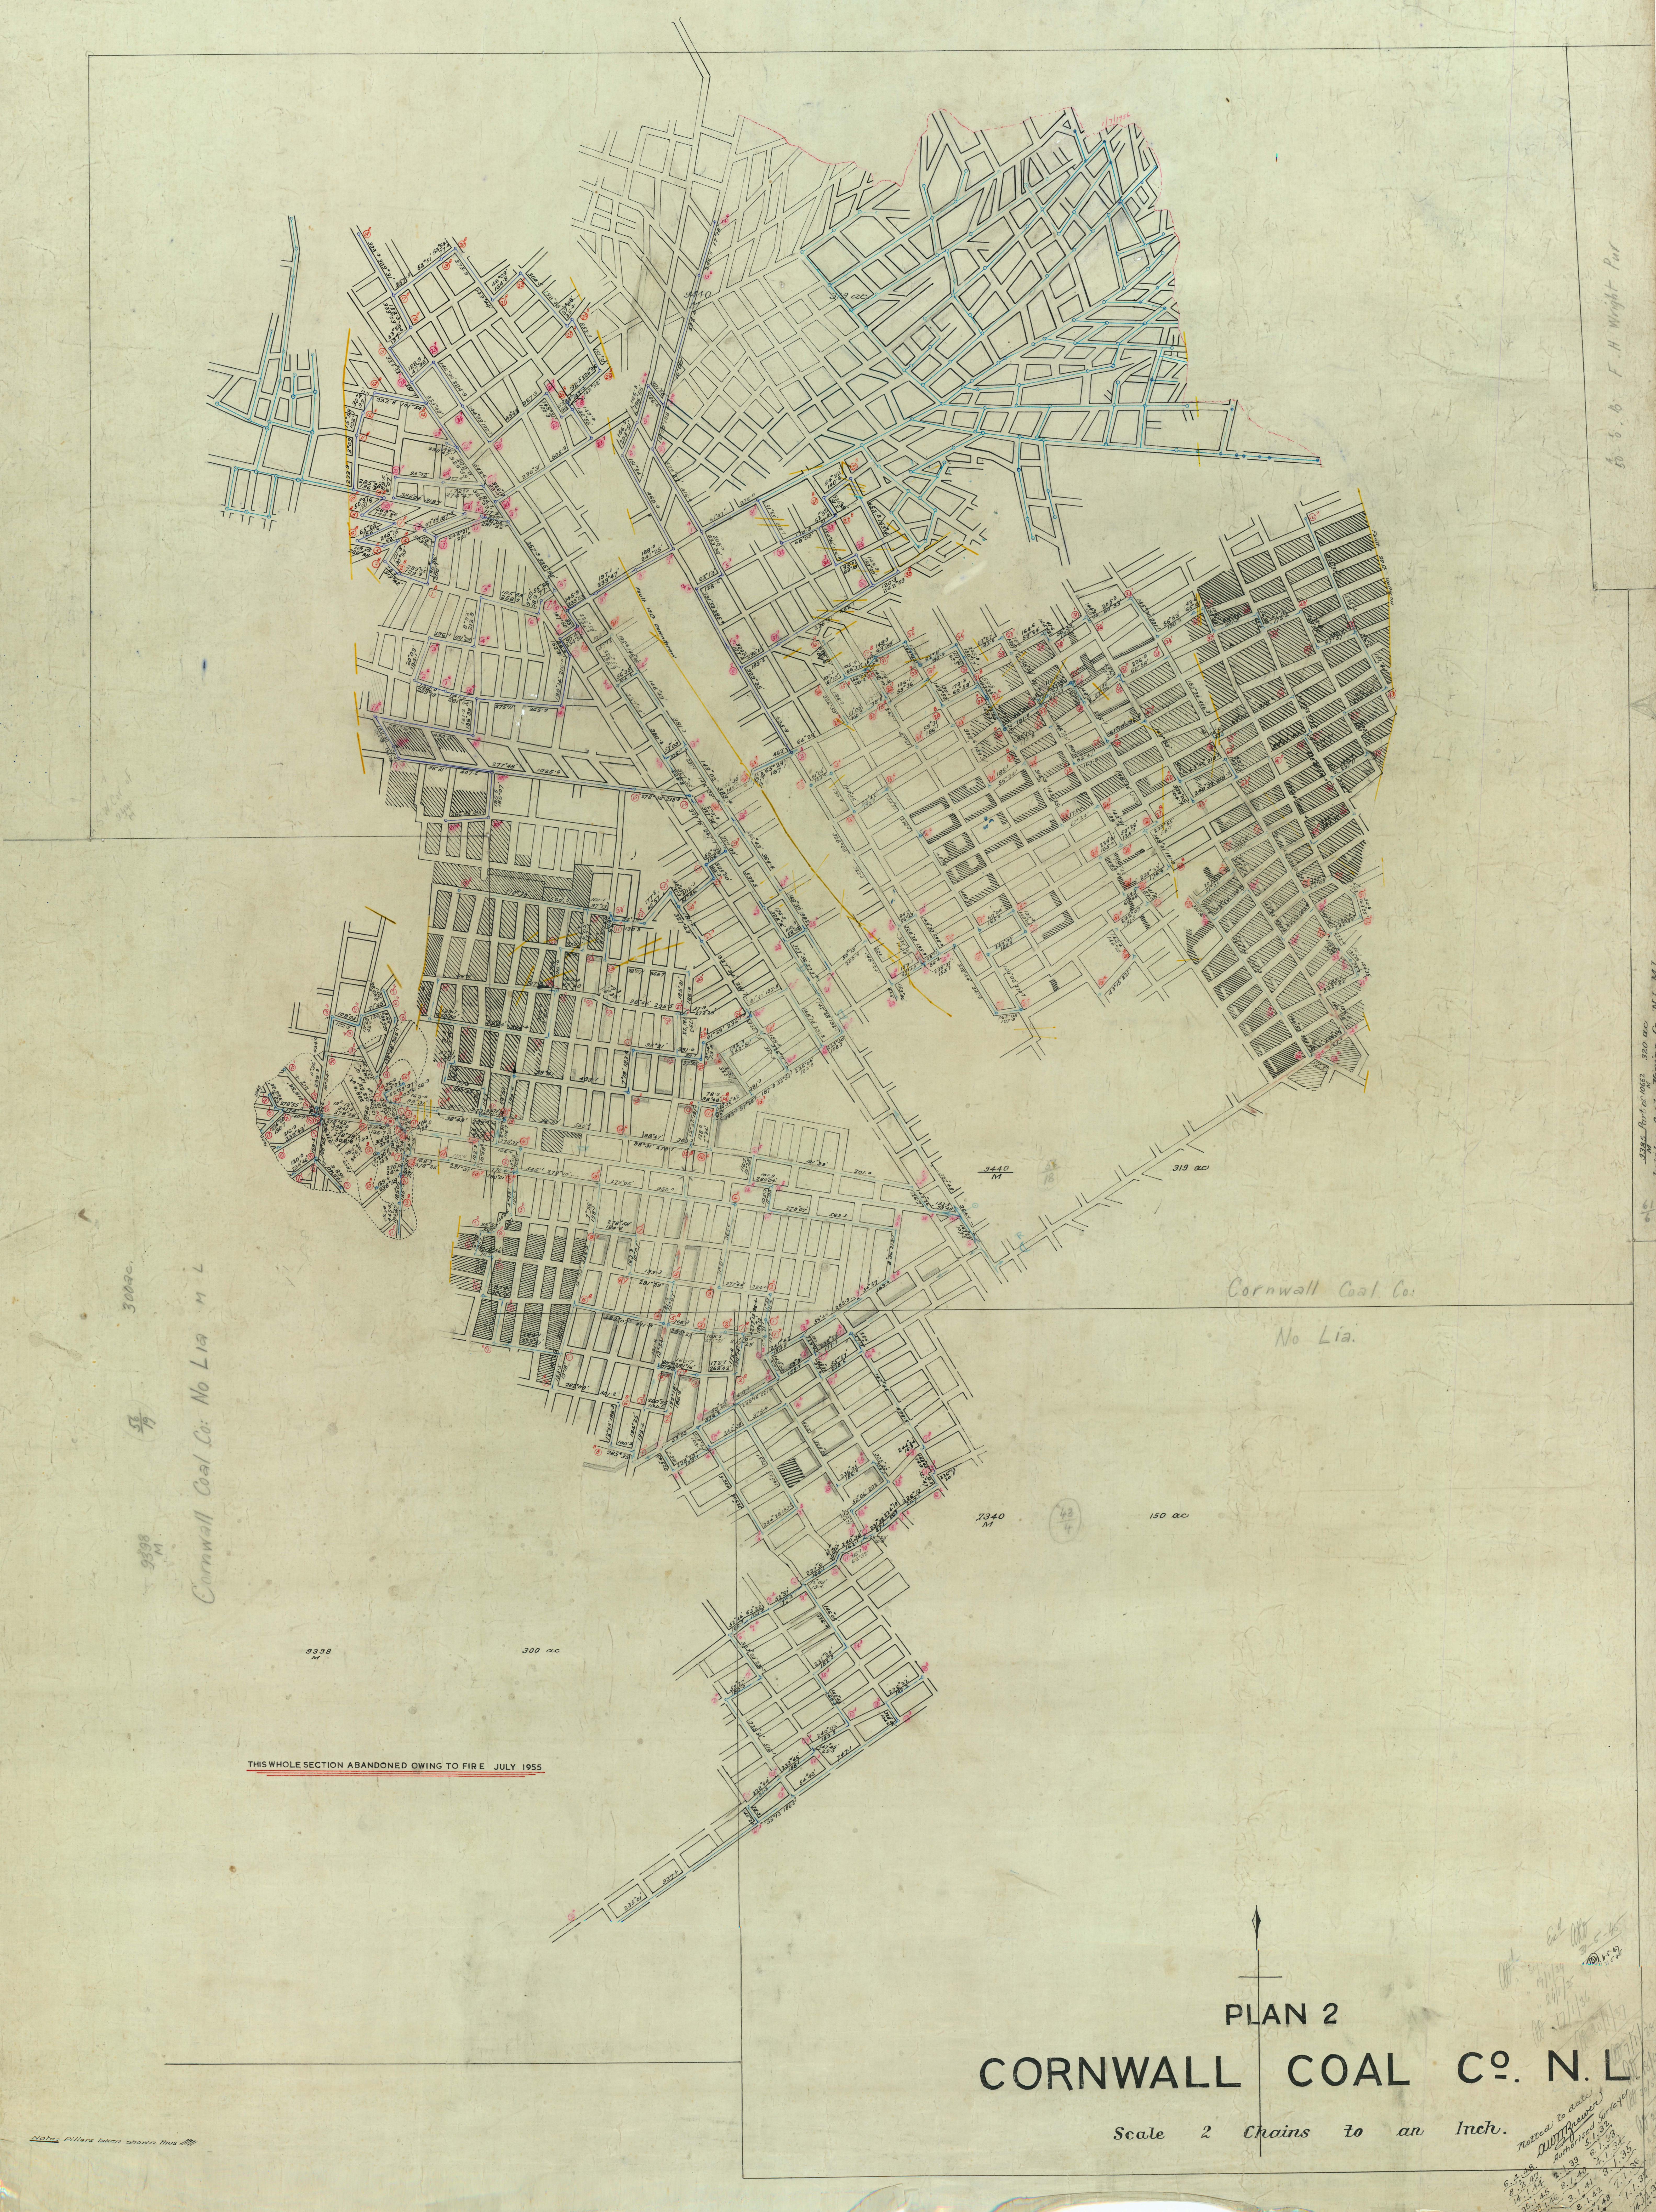
F. H. Wright Pur
3385 Part of 10662 320 ac
M
Jubilee Coal Mining Co N.L. M.L.
9440
M
319 ac
Cornwall Coal Co.
No Lia.
7340
M
150 ac
300 ac.
Cornwall Coal Co: No Lia M L
9398
M
9398
M
300 ac
THIS WHOLE SECTION ABANDONED OWING TO FIRE JULY 1955
Note: Pillars taken shown thus
PLAN 2
CORNWALL COAL Co. N. L
Scale 2 Chains to an Inch.
Plotted to date
Authorised Surveyor