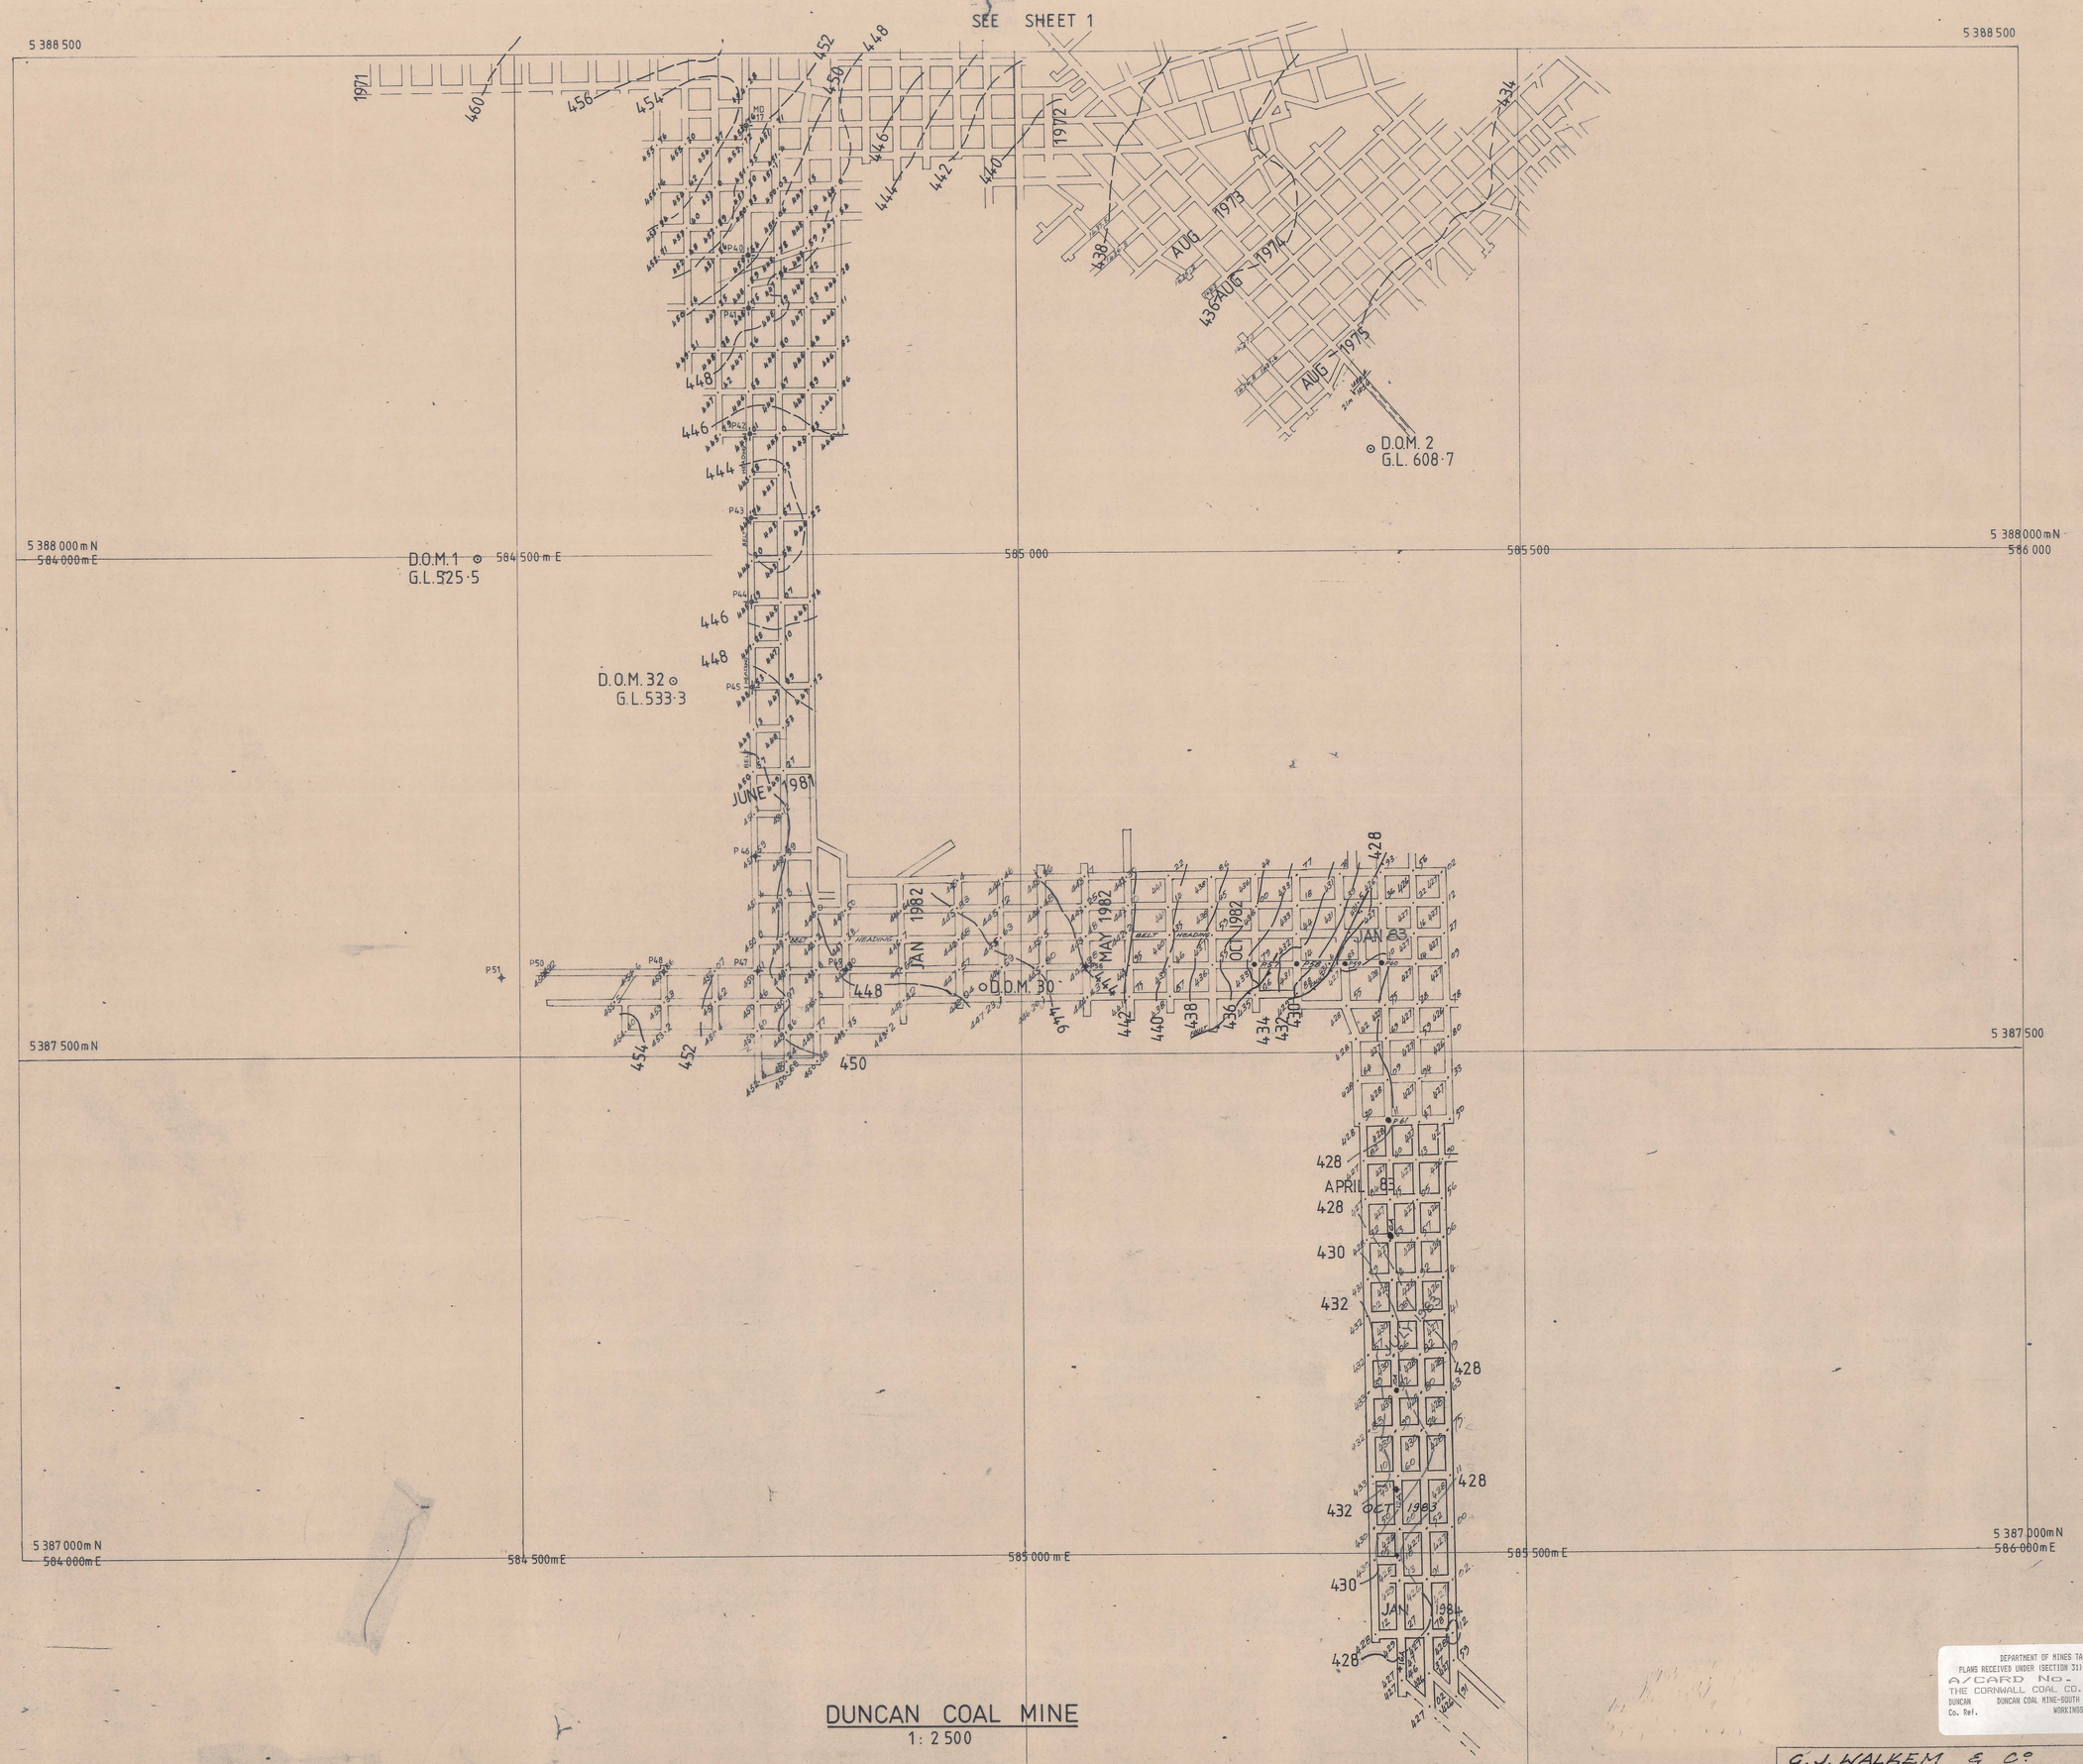


# DUNCAN COAL MINE

1: 2 500

5 cm

DEPARTMENT OF MINES TASMANIA
PLANS RECEIVED UNDER (SECTION 31) MINES INSPECTION ACT
A/CARD No.- 84169
THE CORNWALL COAL CO. NO LIABILITY
DUNCAN DUNCAN COAL MINE-SOUTH HEADING
Co. Ref. WORKINGS AT 02/84

G. J. WALKEM & Co 312428
22 ELIZABETH STREET LAUNCESTON P.O. BOX 472.
SURVEYORS & PLANNERS.

| | | |
|---|---|---|
| DUNCAN COAL MINE. | DRAWN G.J.W./D.J. | REGISTERED SURVEYOR |
| | DATE 25·10·1982. | |
| | SCALE 1:2500 | No 2058 |

7/80
SHEET 2

150 - 7810