189-03

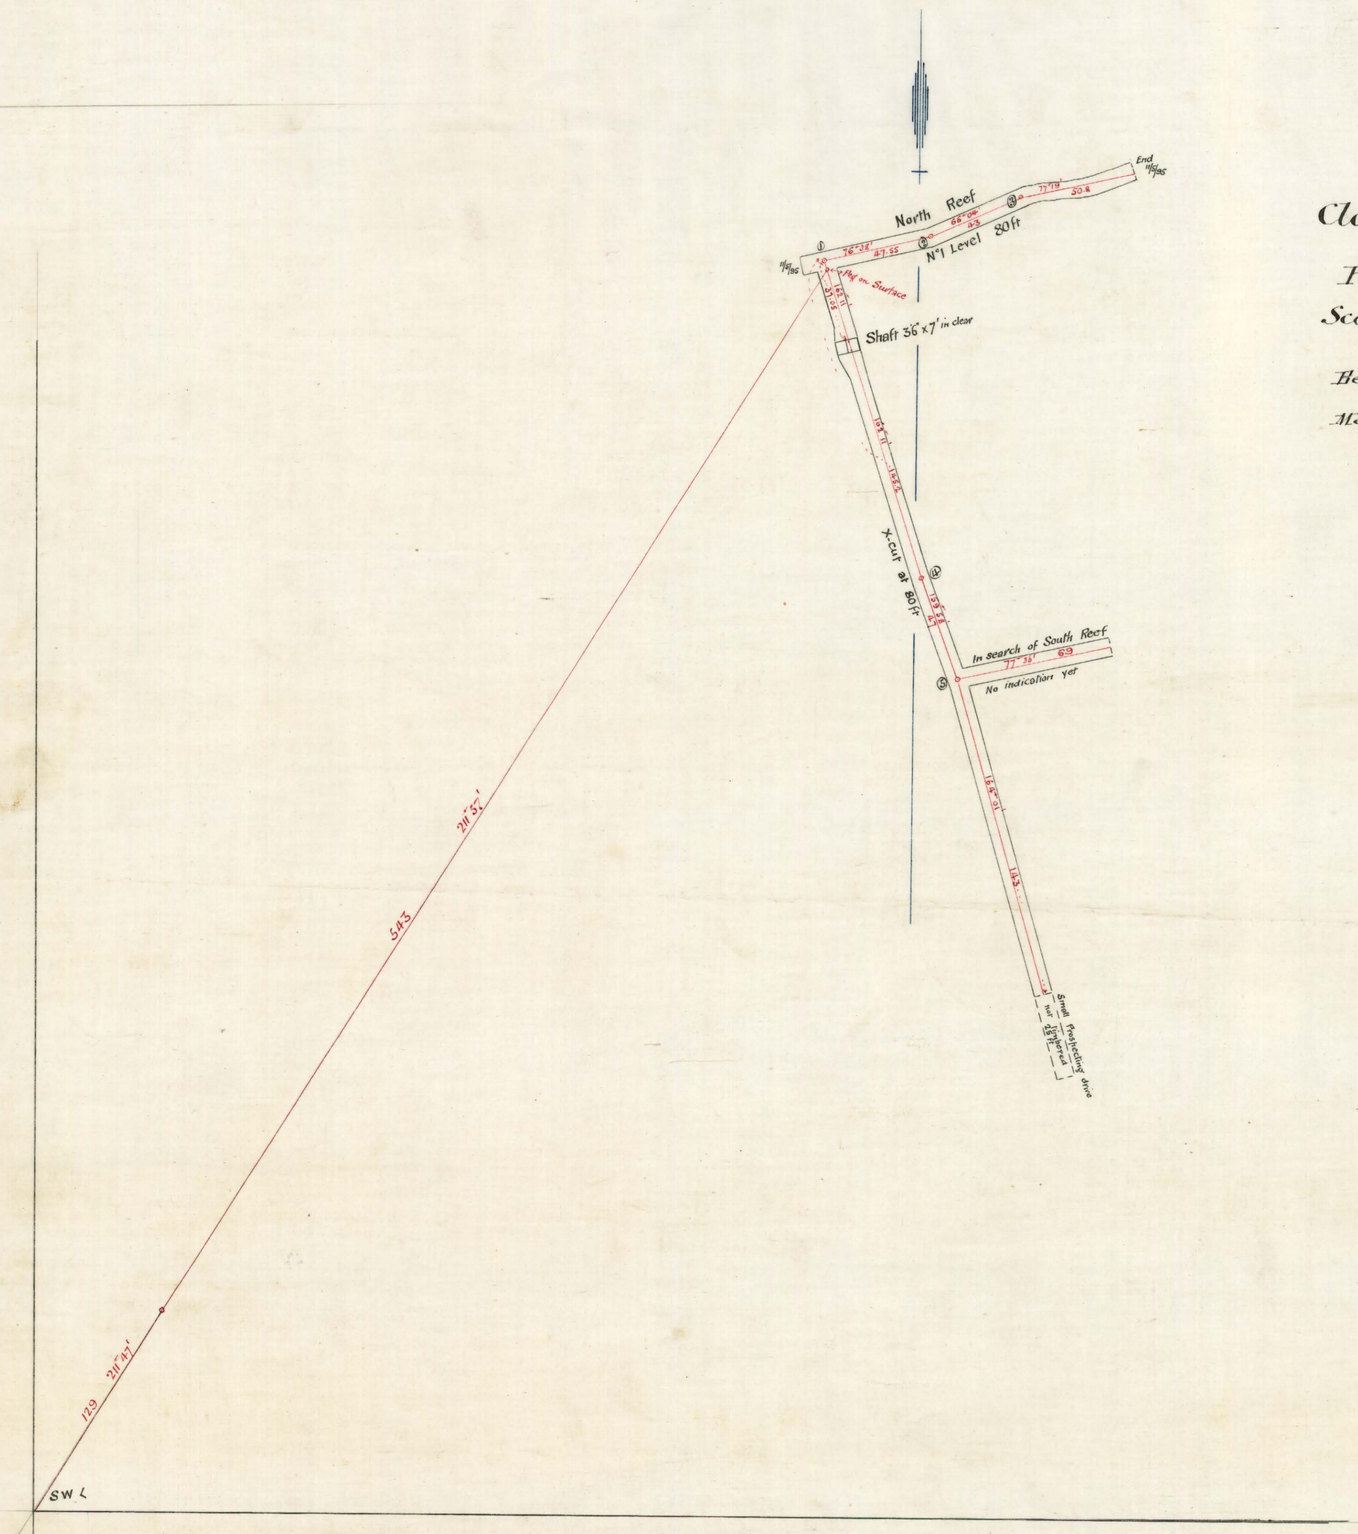

Clarence G.M. Co.
Lefroy
Plan of Drives

Scale - 25ft to an inch

Bearings reduced to Trigs

Measurements shown in links

Geo Eddie
District Surveyor
11th May 1896

INSPECTOR OF MINES OFFICE
17th May 1895.
LAUNCESTON