


189-05

04


04

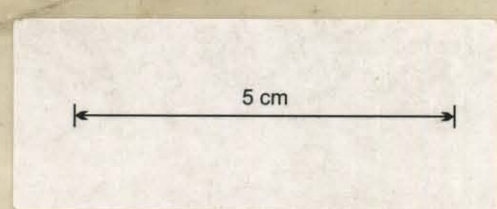

189-05



SCALE . 25 FT. = 1 INCH

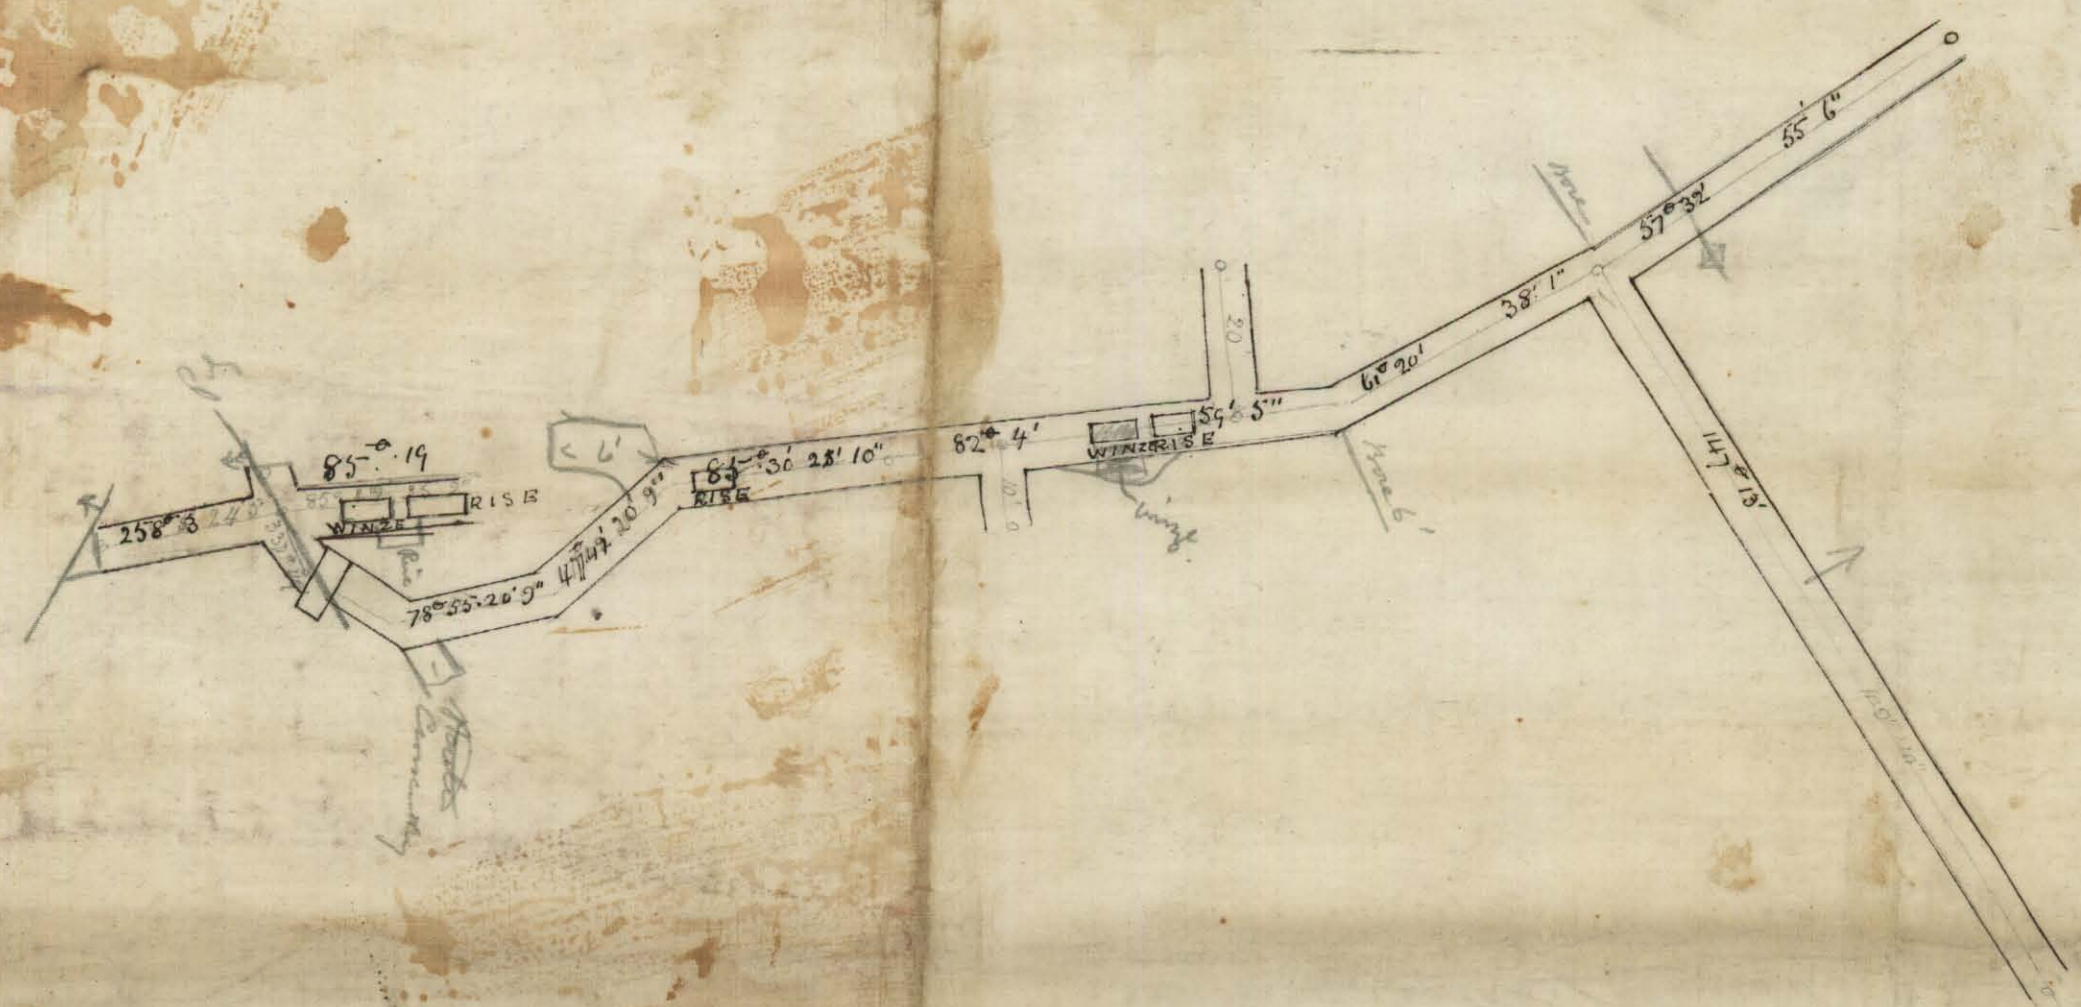

Wm. J. ...
of ...

04

04