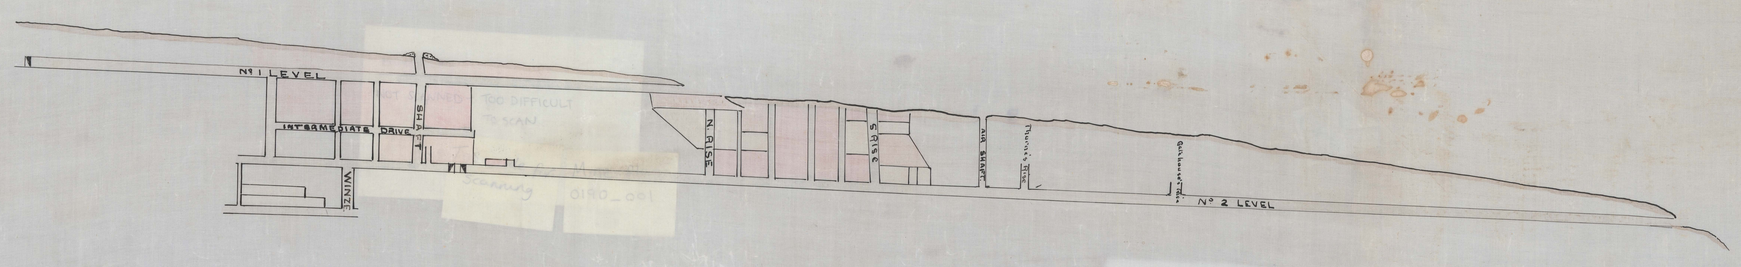

Longitudinal Section along M-N.

Reference.

Stoped prior to 1906

do during 1906

do during 1907.

195

289

—TASMANIAN SMELTING COMPANY, Ld.—

—LONG TUNNEL MINE.—

—SCALE .—

REFERENCE.

SURFACE TRAVERSES SHOWN

No 1 LEVEL "

No 2 DO. "