


5 cm

199-02

New City of Melbourne Gold Mining Co.

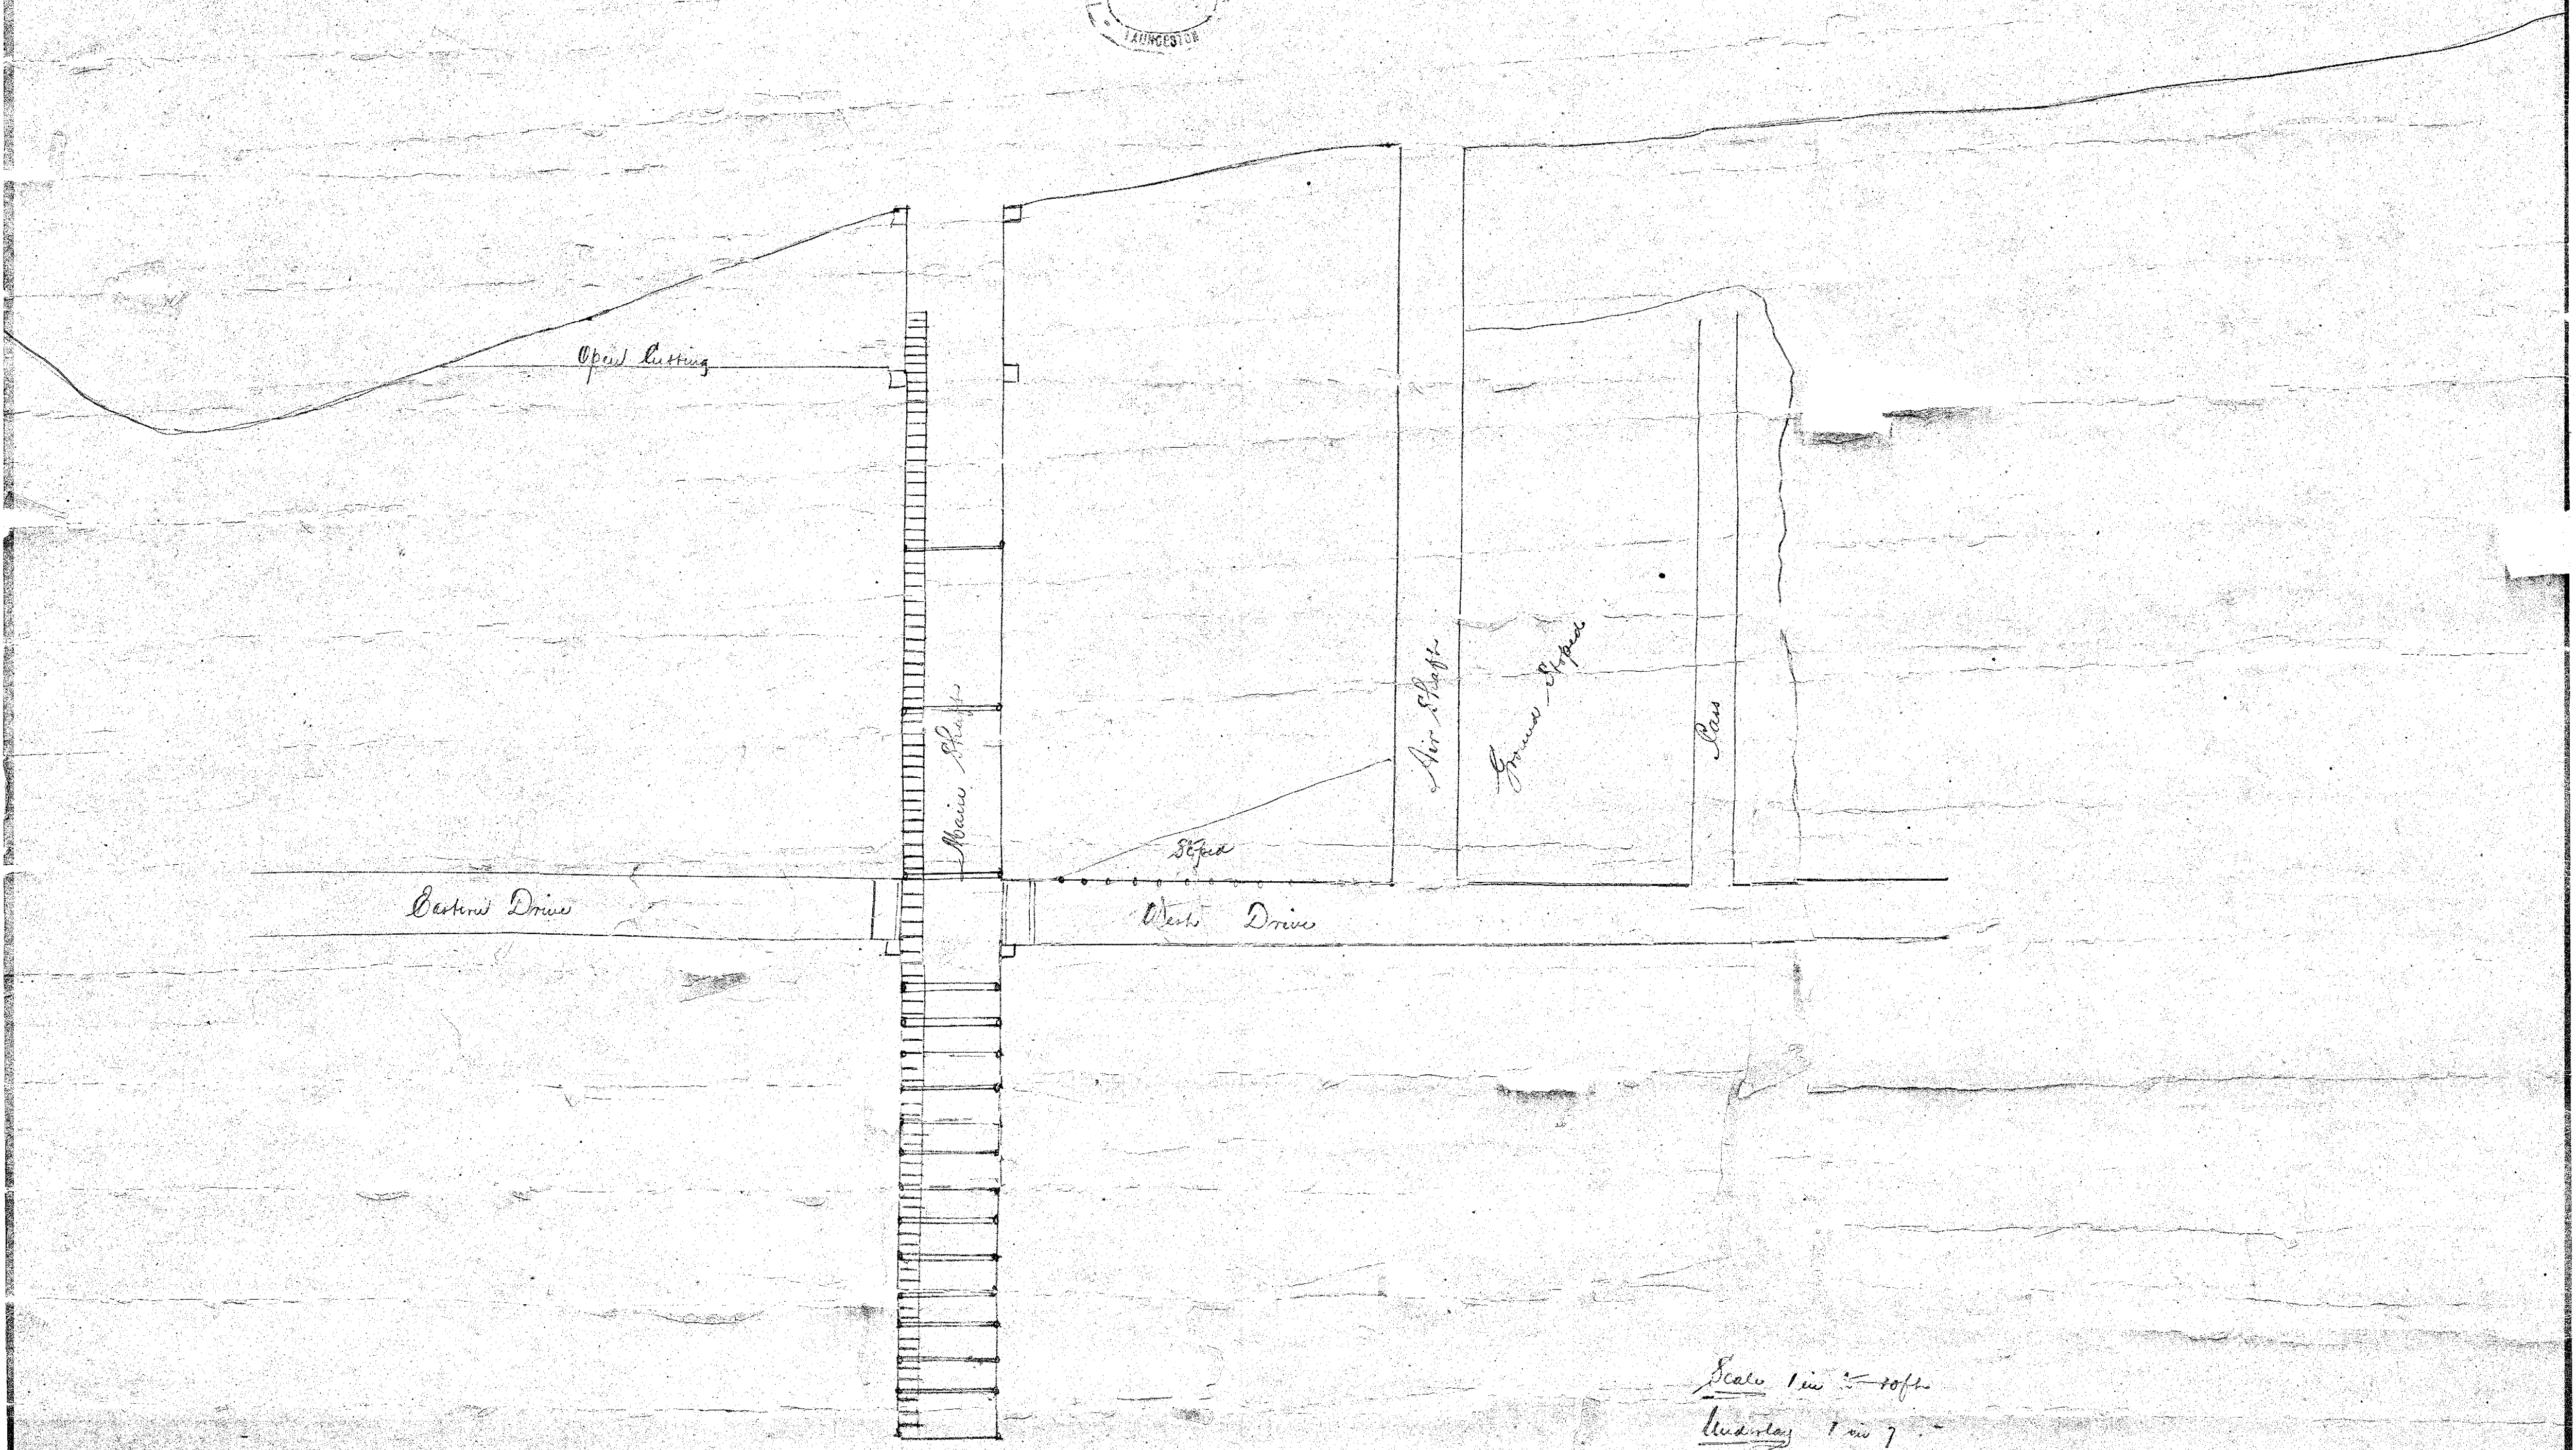



Cours & Road - Banks & Wells

Launceston 24th April
L. H. Ritchie - Manager