


CENTRAL RINGAROOM
MINE WORKINGS
COUNTY OF DORSET
PARISH OF ALBERTON
SCALE

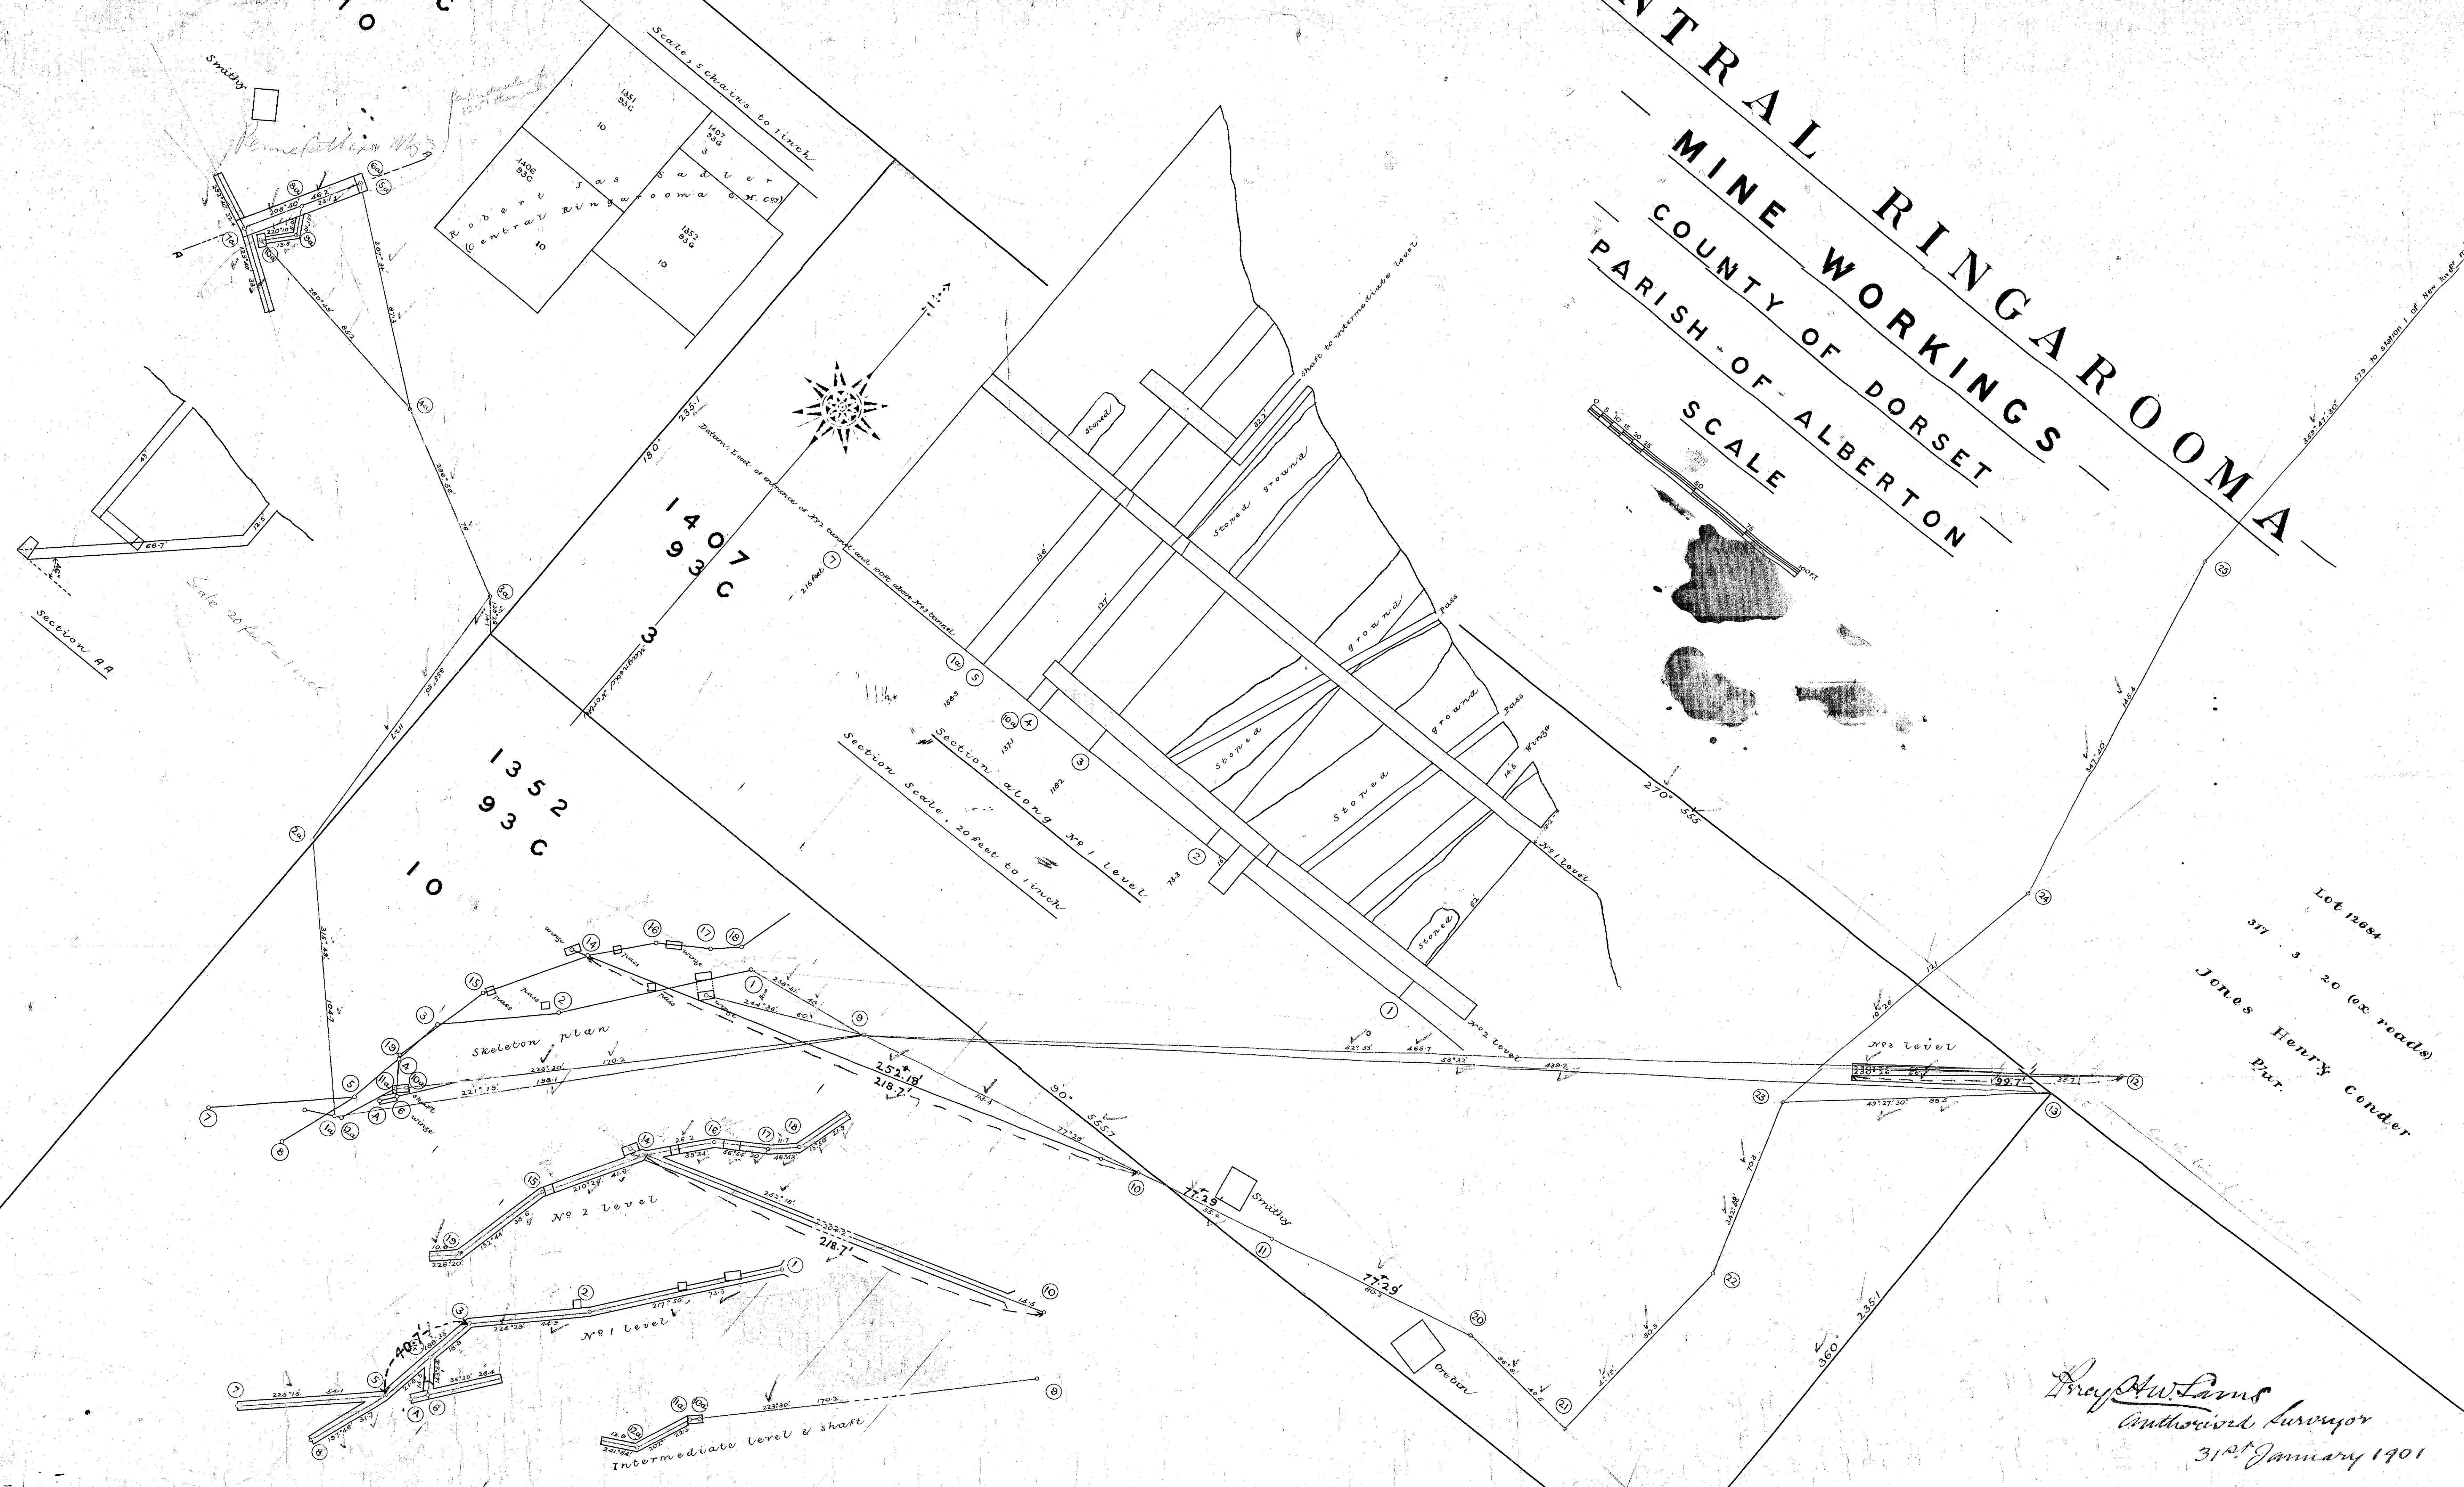

Thos. H. Lums
Authorized Surveyor
31st January 1901

