THE GOLDEN STAIRS GOLD MINING CO. MATHINNA

scale one inch = twenty five feet

Survey made with a 5 inch dial made by Cooke and Son. Derby England measurements made with a steel tape of standard length. Links being reduced to feet. Red lines are underground workings. Black lines on surface

J.M. Potter C.P.M.

To date of suspension of operation Sept 1893

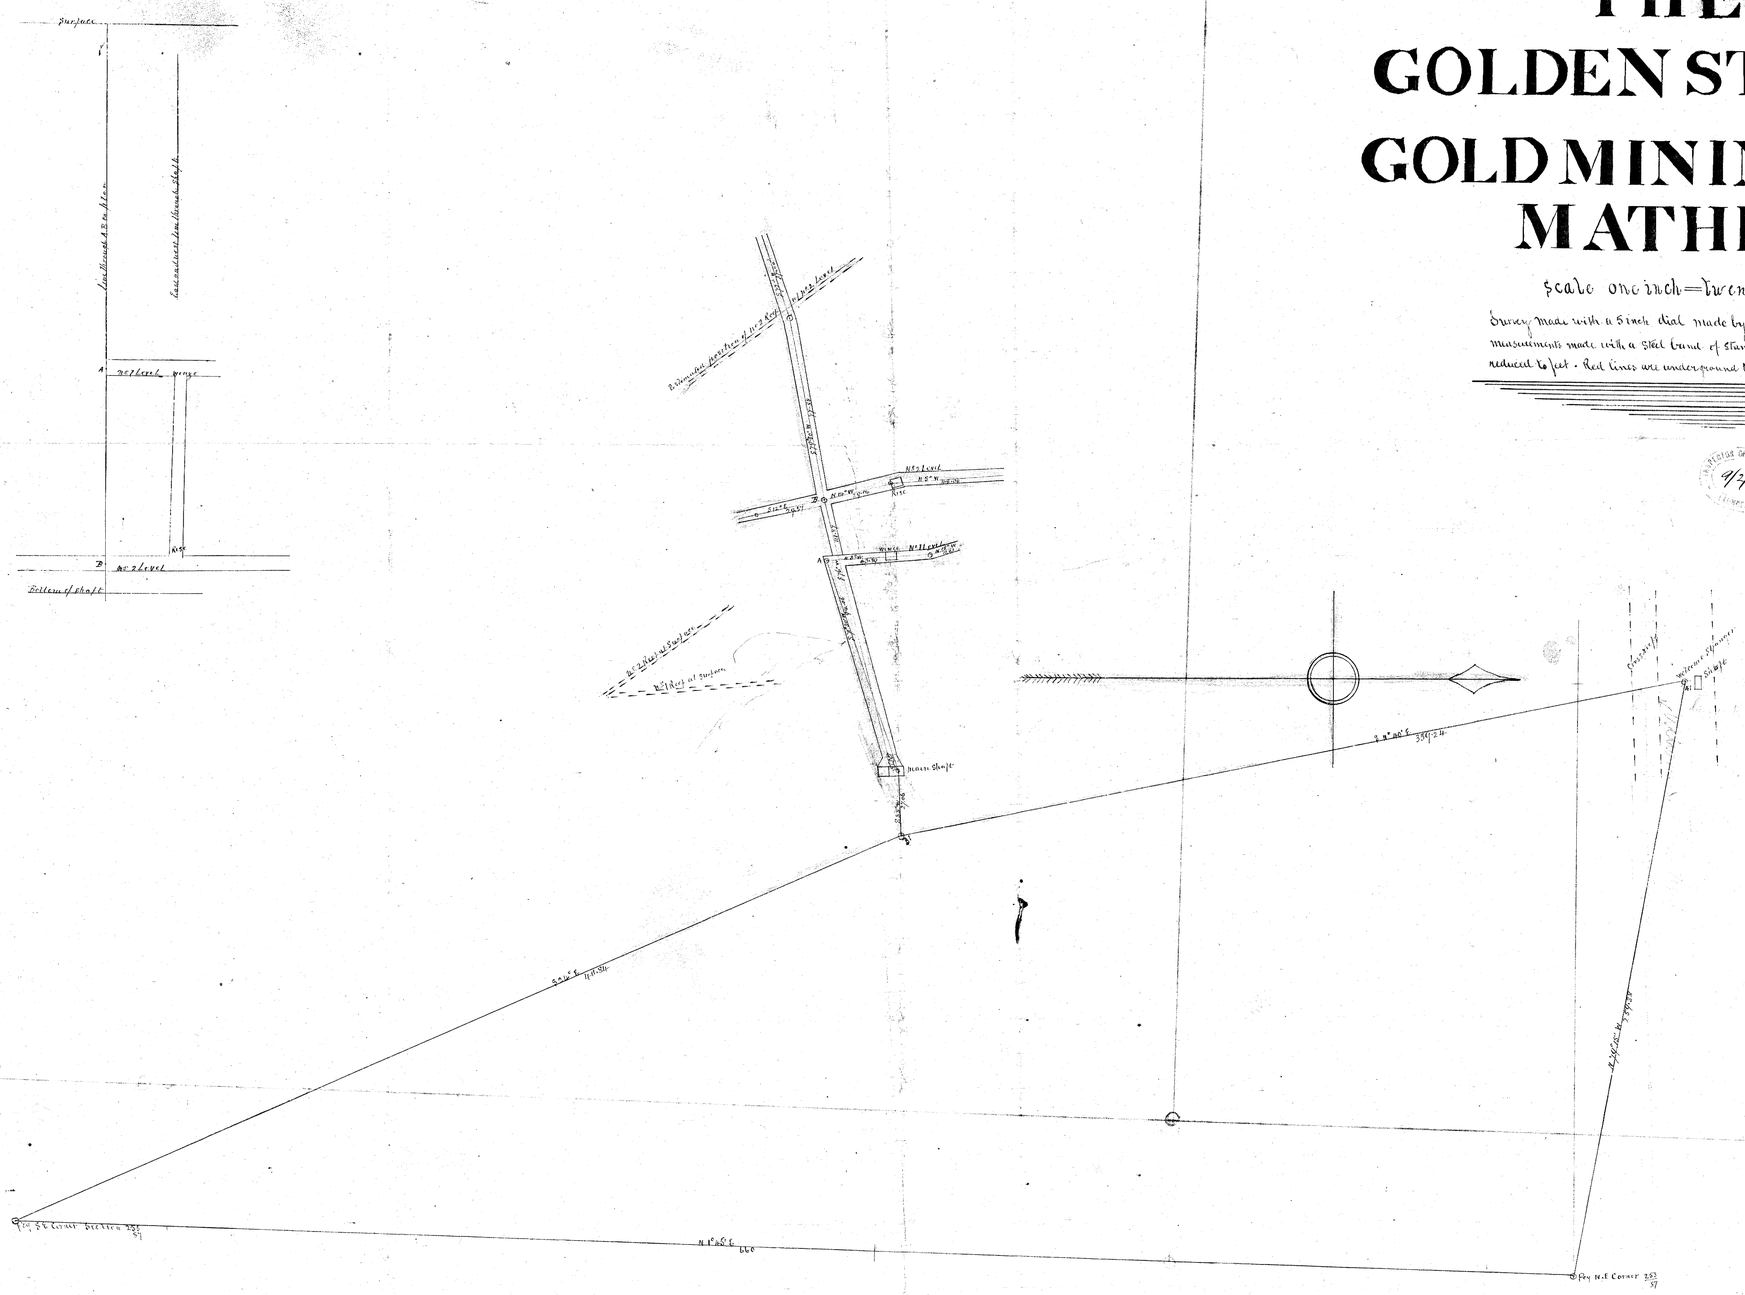

204-01

204-01

9/7/14