Plan
of the
Princess Gold Mine

Scale 25 feet to an inch
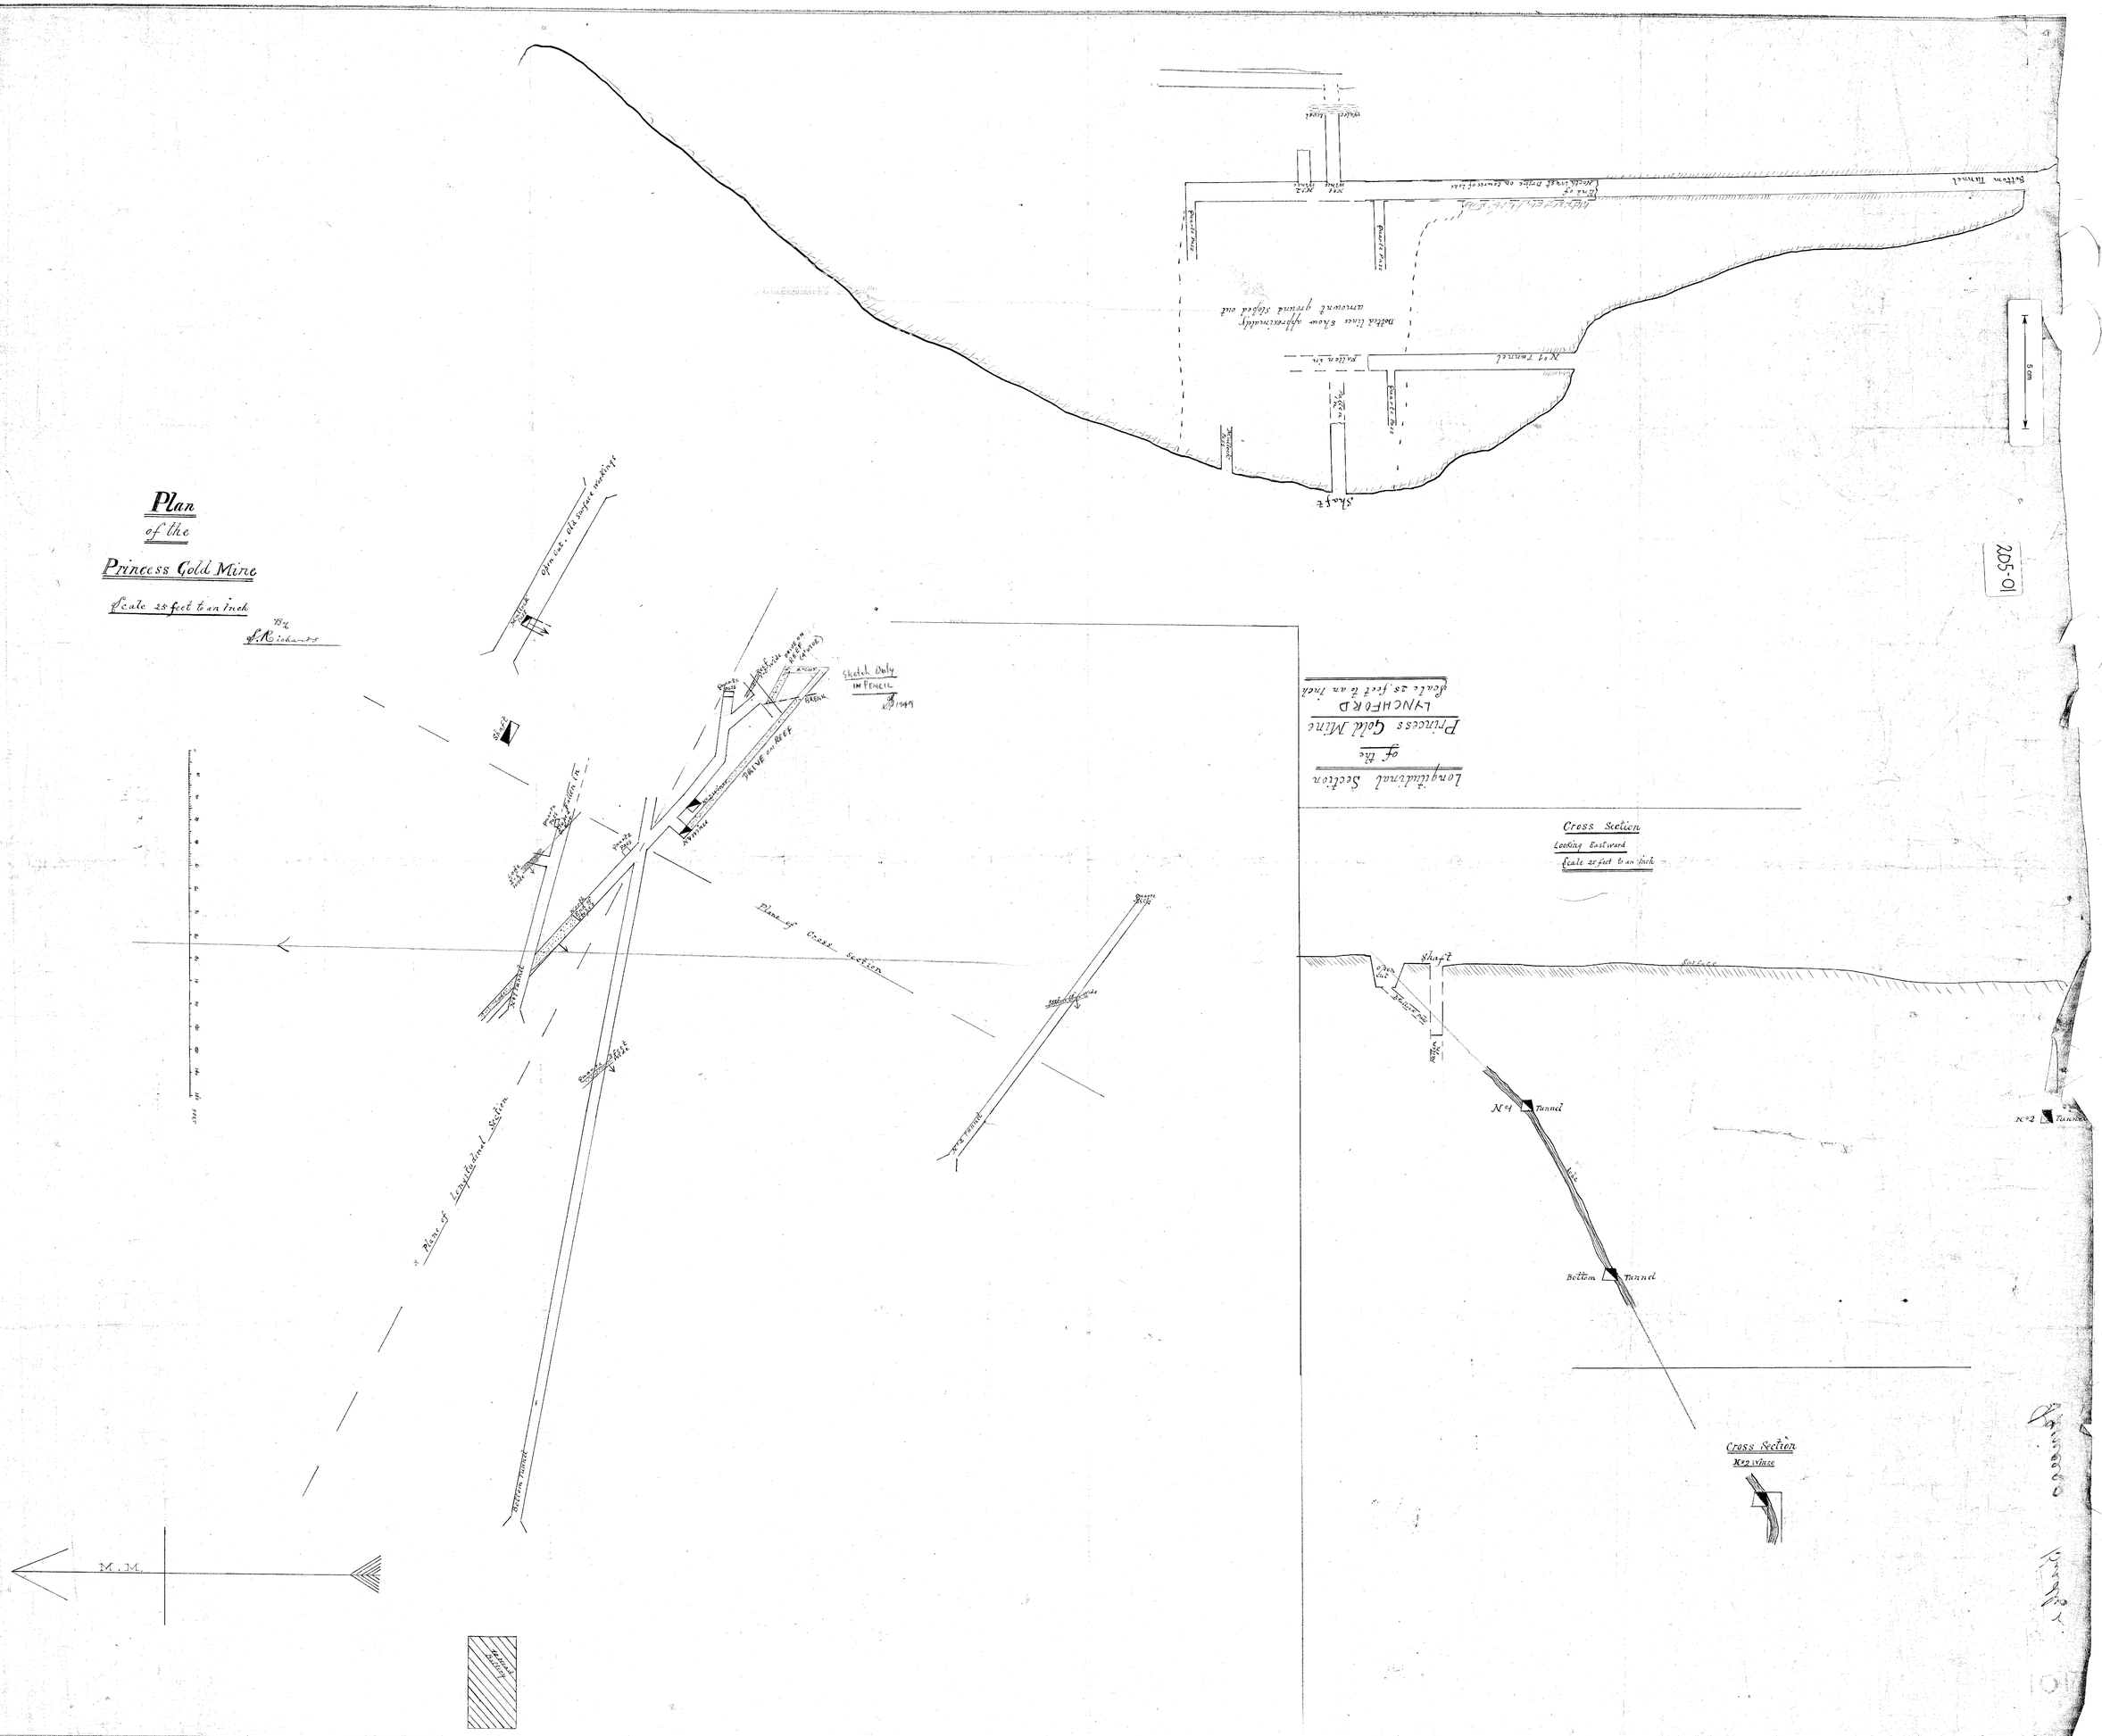
By
A. R. Richards