208-03
5 cm
208-03
GOVERNMENT MINERALOGIST
9 - JUL 1917
LAUNCESTON, TASMANIA

THE GOLDEN CREST GOLD MINING C.N.L.

PLAN

SCALE 40 FEET TO AN INCH

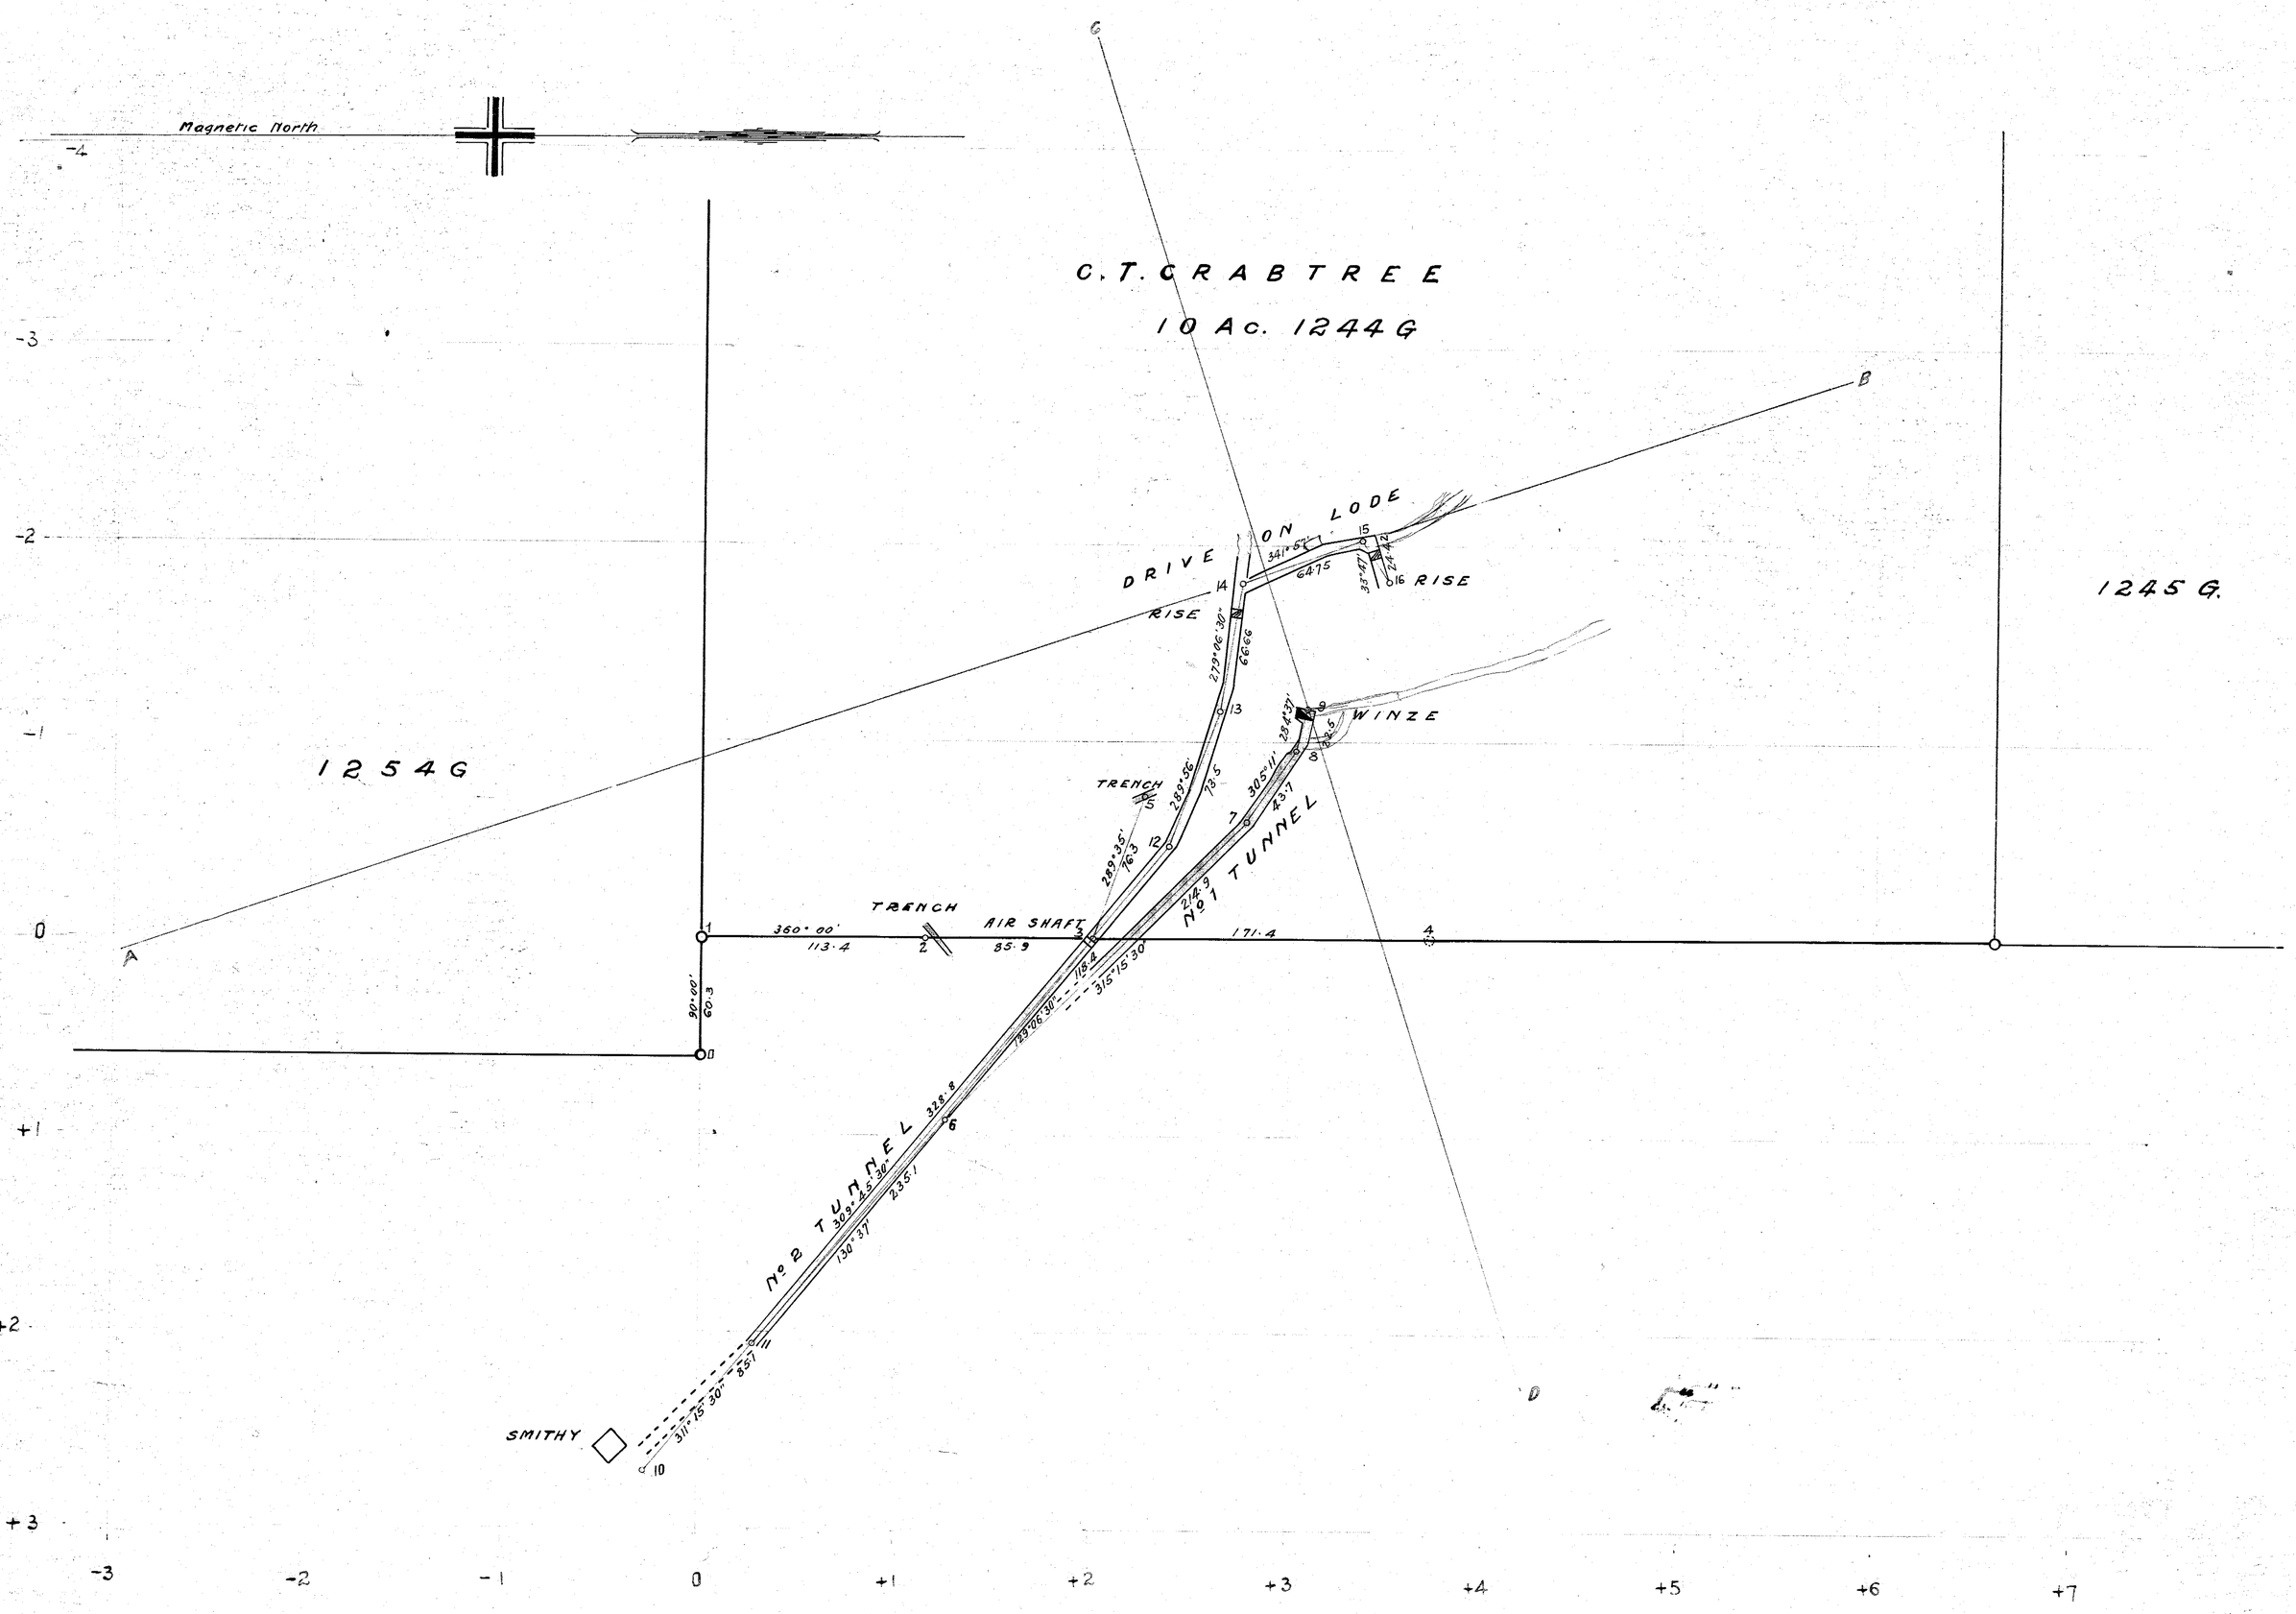

LONGITUDINAL SECTION

PROJECTION ON AB

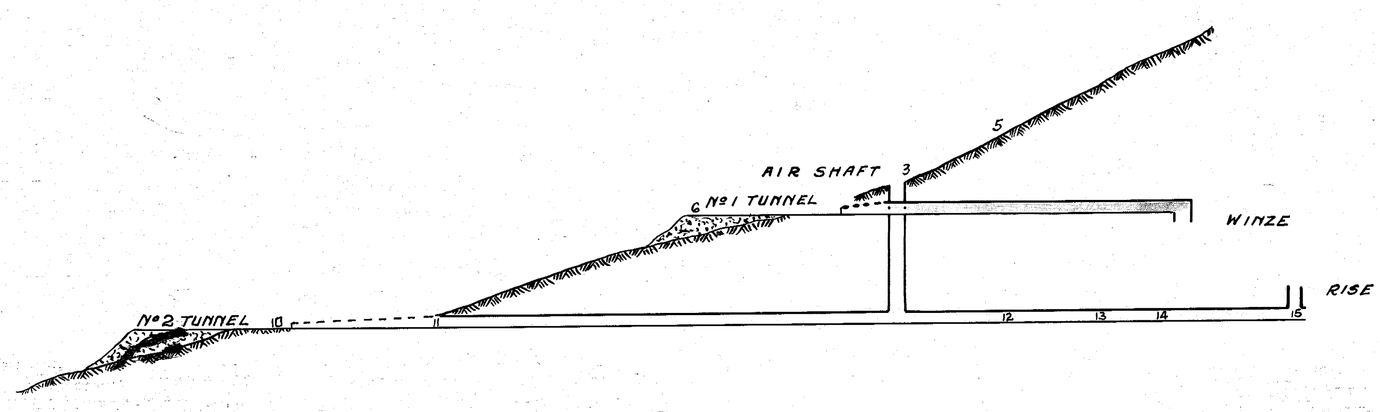

TRANSVERSE SECTION

PROJECTION ON CD

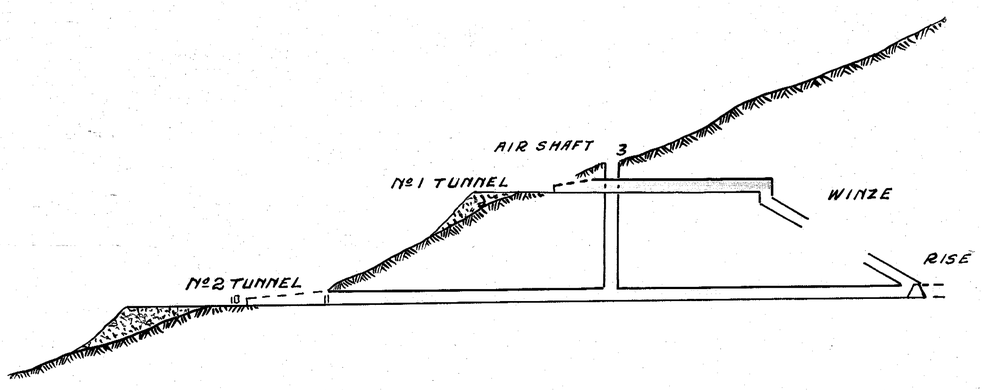

All c. Intosh Red, Surveyor
30 June 1917
Inst. 5" Zeiss Theodolite