


CROSS SECTION

Scale — 25 Feet to one inch

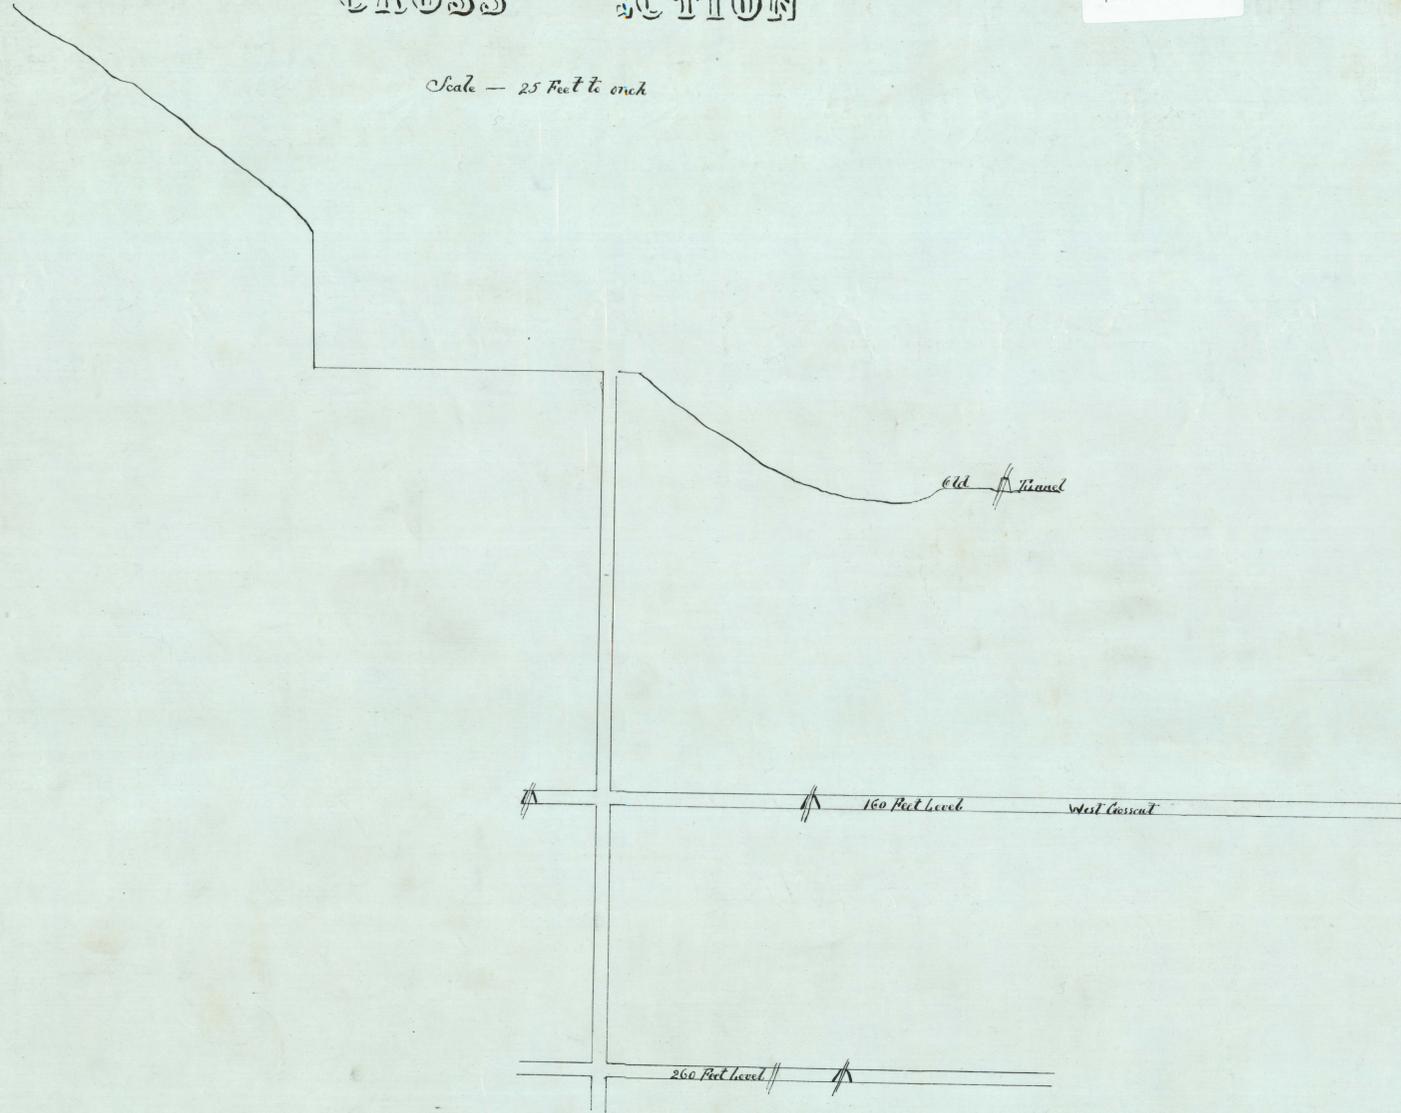

LONGITUDINAL SECTION

Scale — 25 Feet to one inch

