

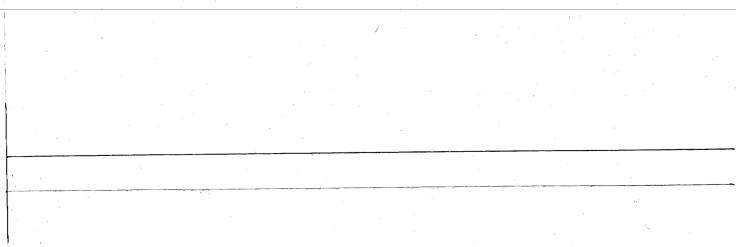


# HATHERTON SECTION

LONGITUDINAL SECTION

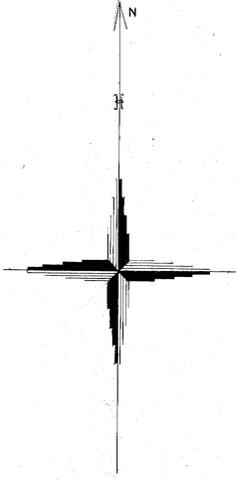

PLAN

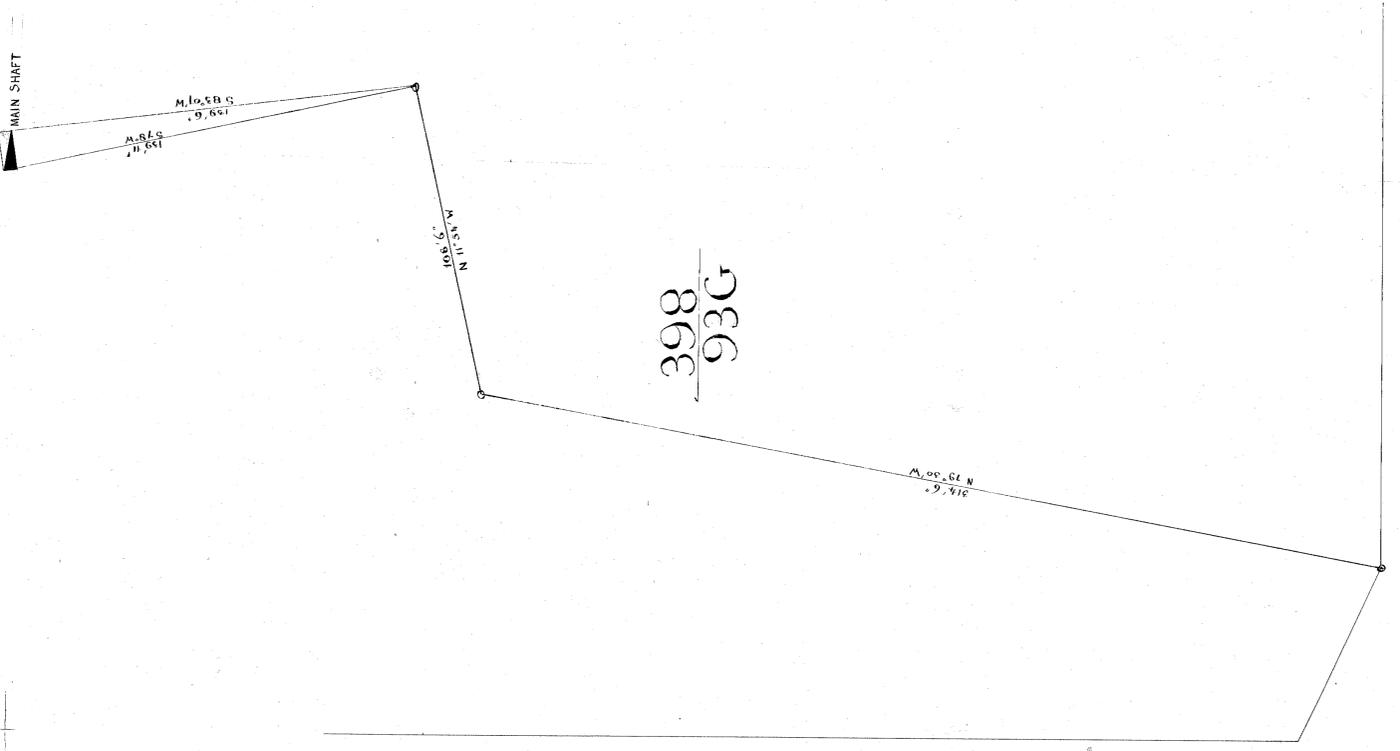

Surveyed and drawn by  
A. Dickinson A.R.S.M. and G.R. Jones  
Instrument used Theodolite

505  
93G

210-02

210-02

5 cm

0 10 20 30 40 50 60 70 80 90 100 FEET

1/1/47