MT. CLEVELAND TIN MINING CO. N.L.

PLAN

SHOWING POSITION OF WORKINGS

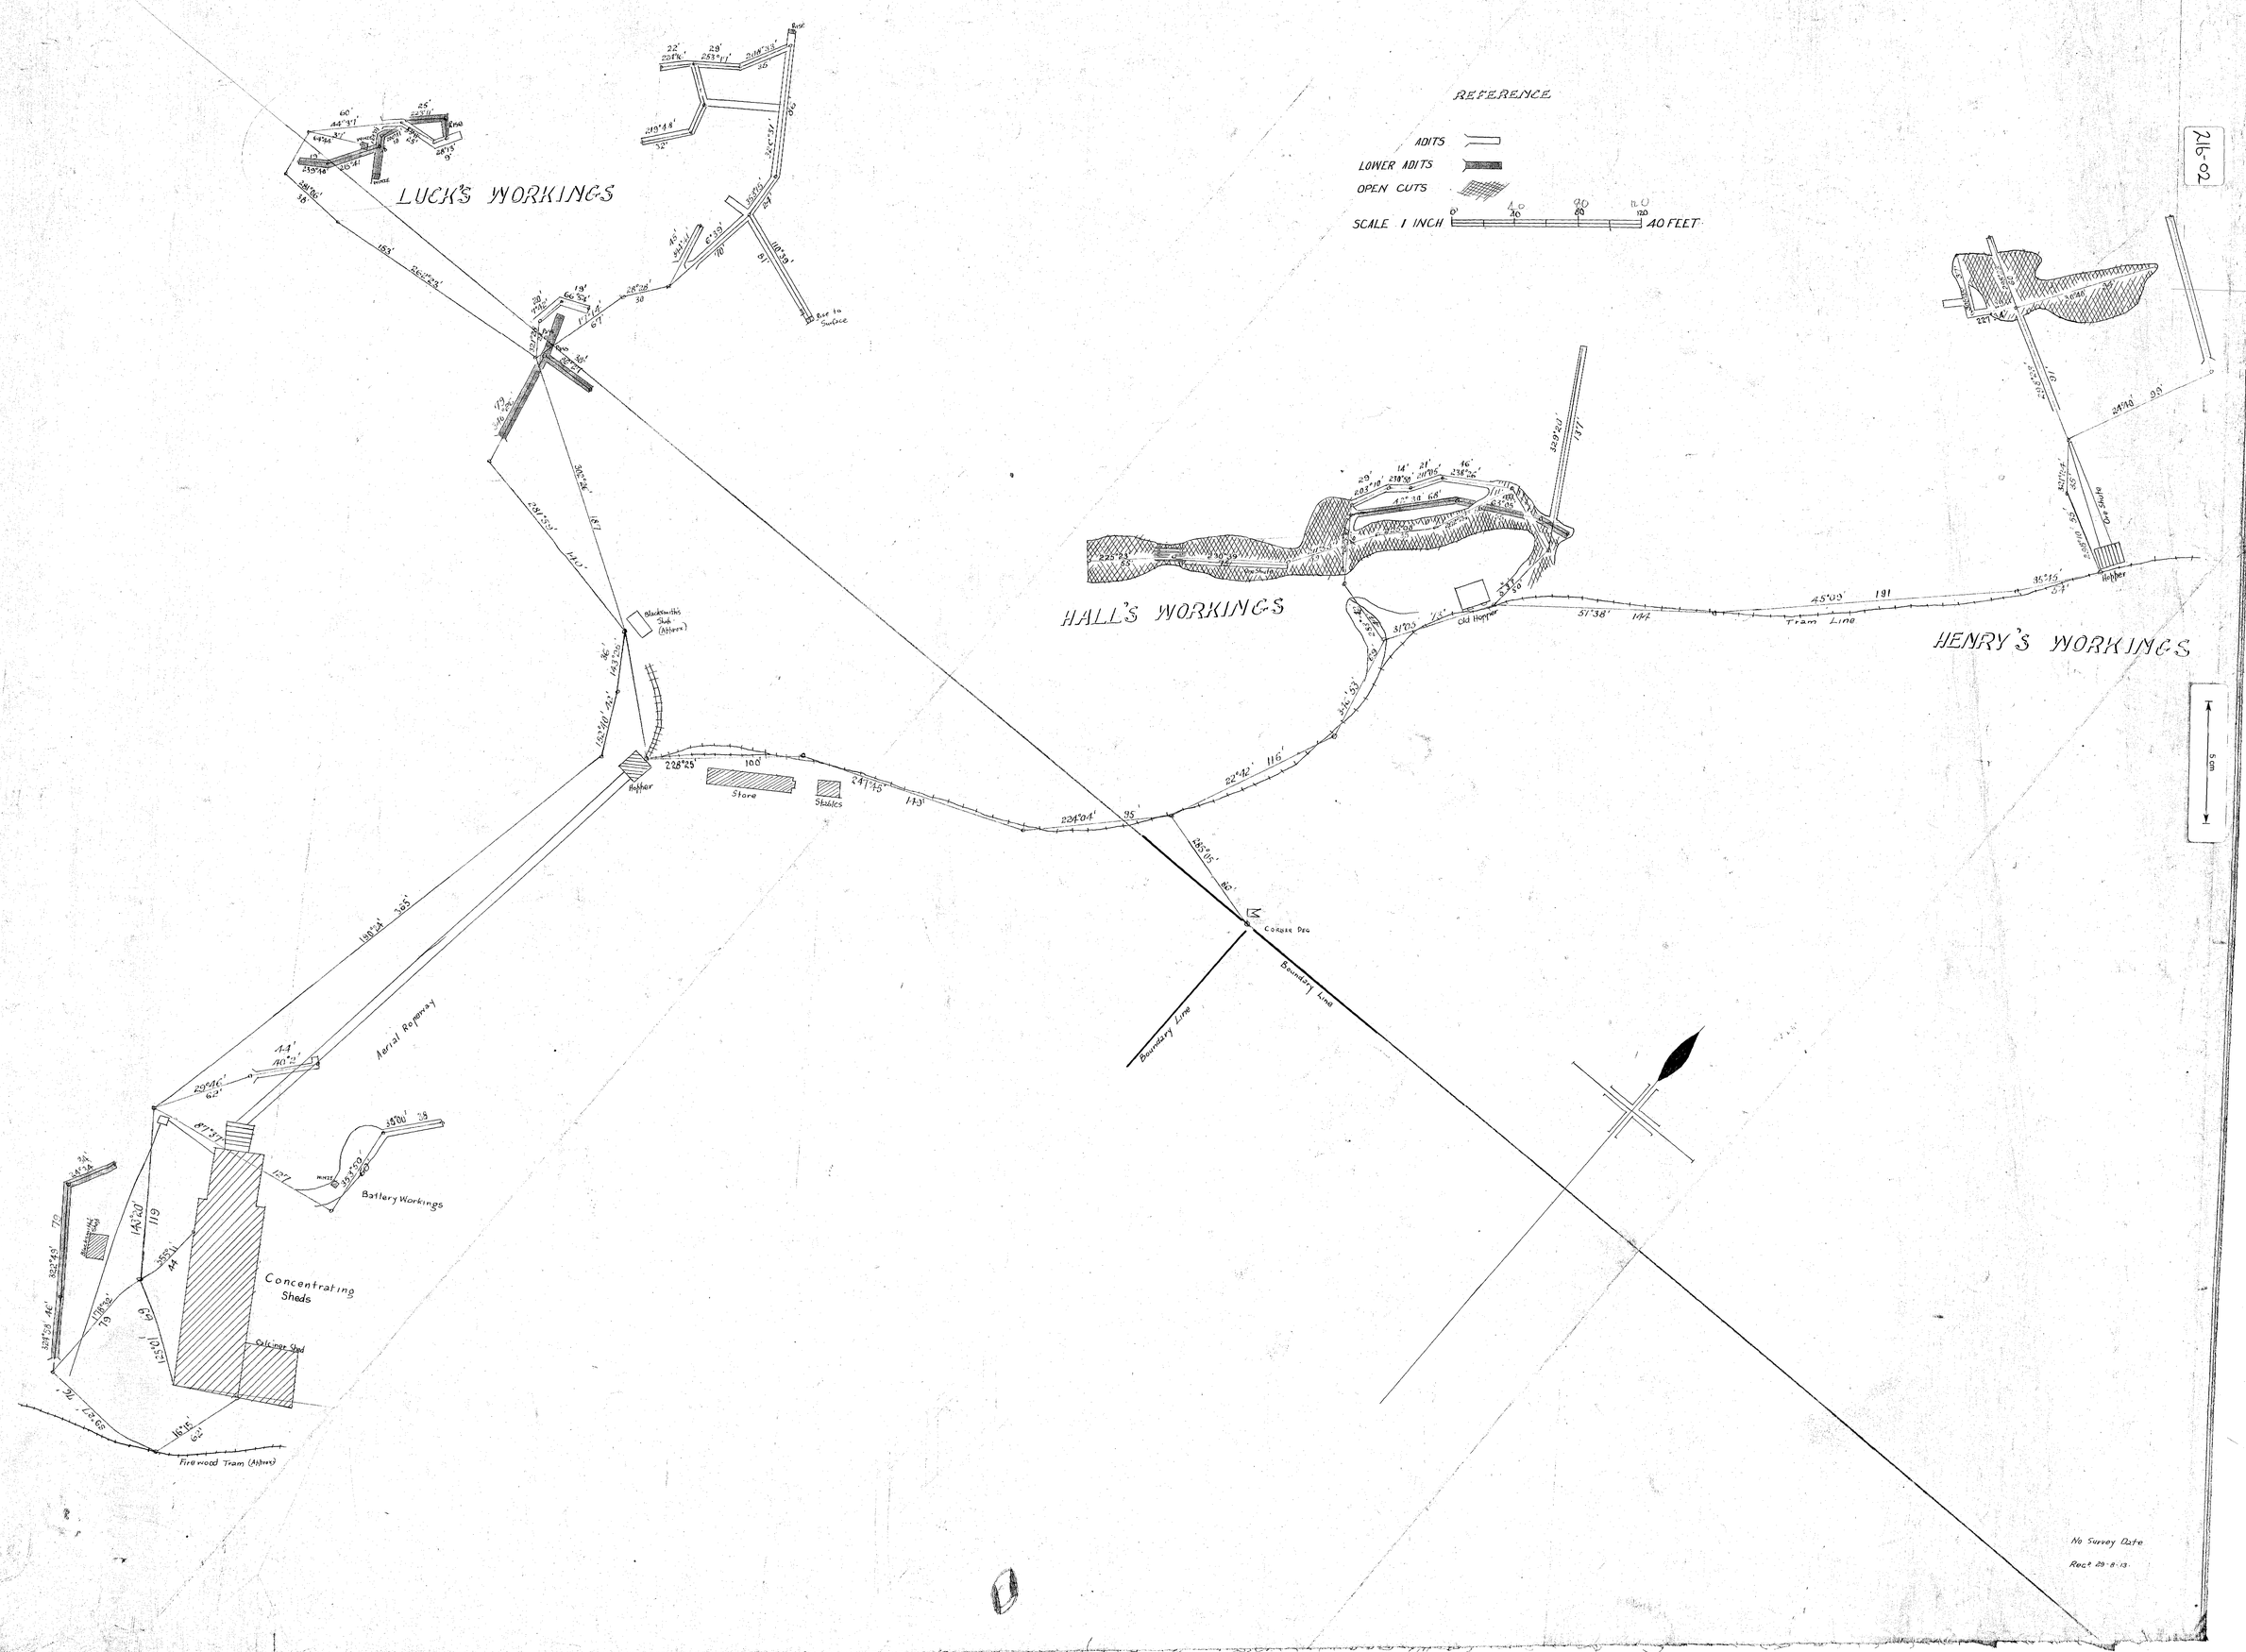

216-02