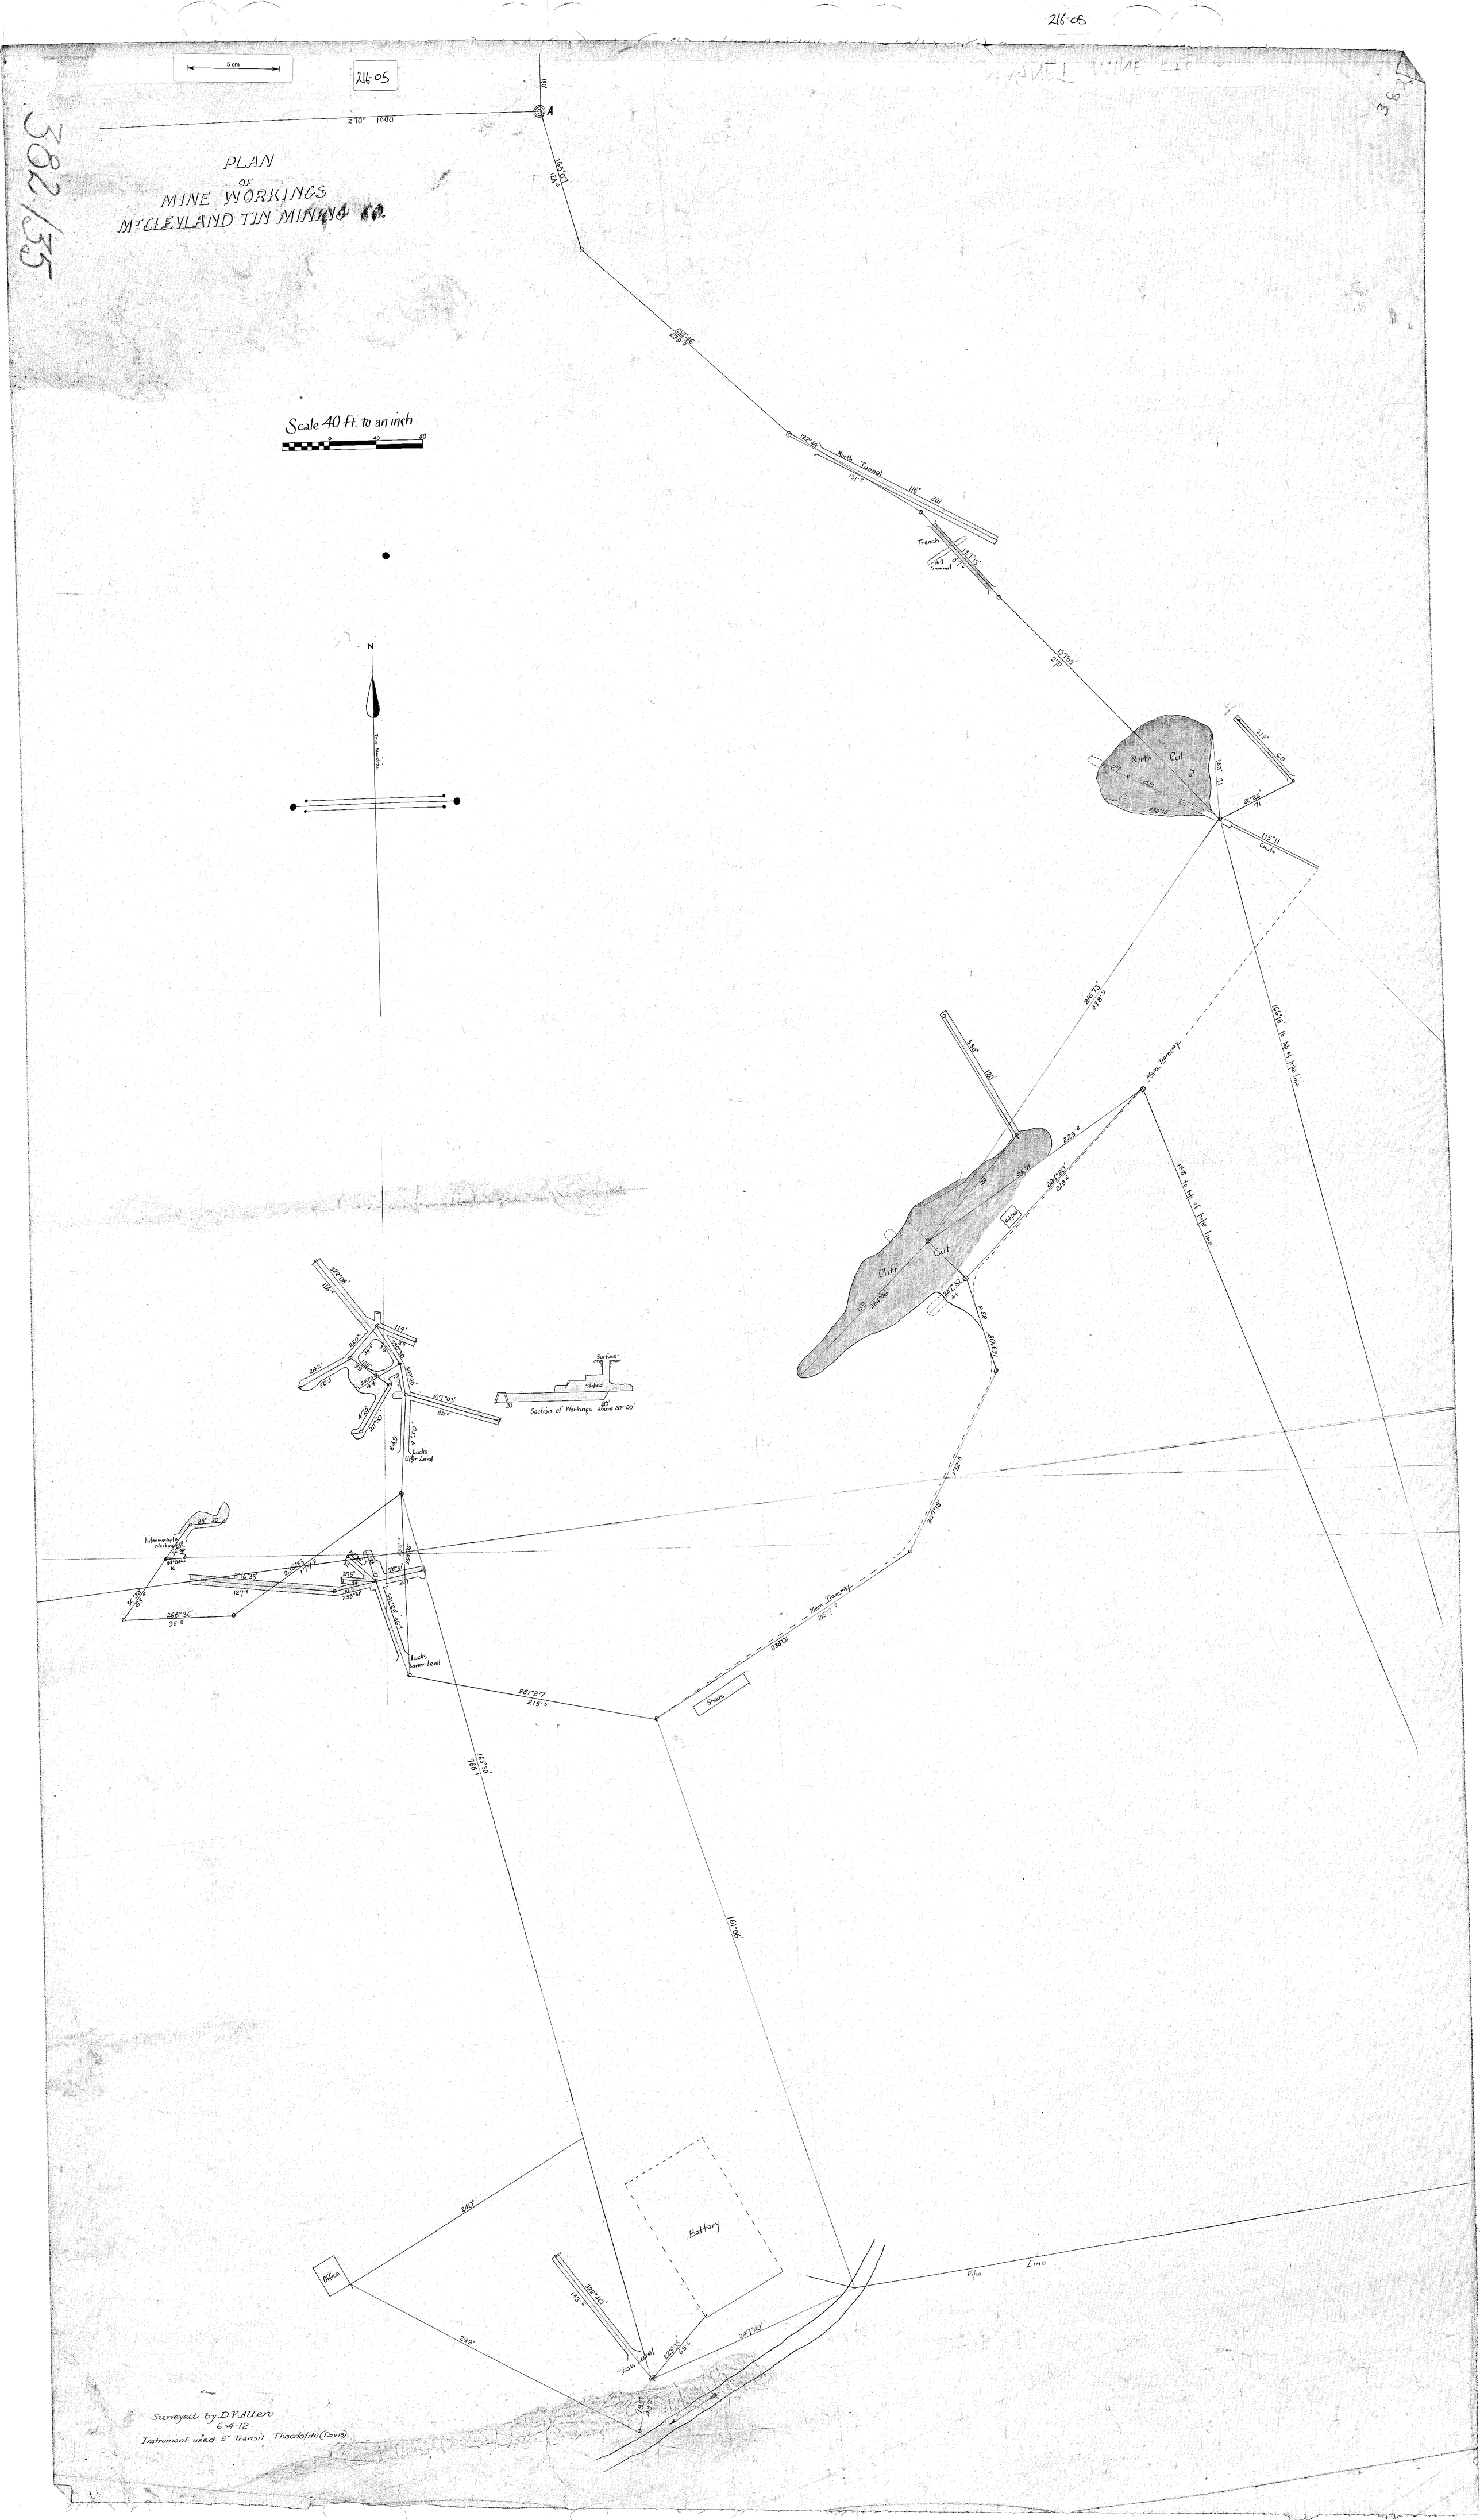
PLAN
OF
MINE WORKINGS
McCLEYLAND TIN MINING CO.
Scale 40 ft. to an inch
North Tunnel
Trench
Will Summit
North Cut
Chute
Main Tramway
Cliff Cut
Lucks Upper Level
Intermediate Workings
Section of Workings above 20-20'
Lucks Lower Level
Sheds
Office
Battery
Pipe Line
Surveyed by D.V. Allen
6-4-12
Instrument used 5" Transit Theodolite (Davis)