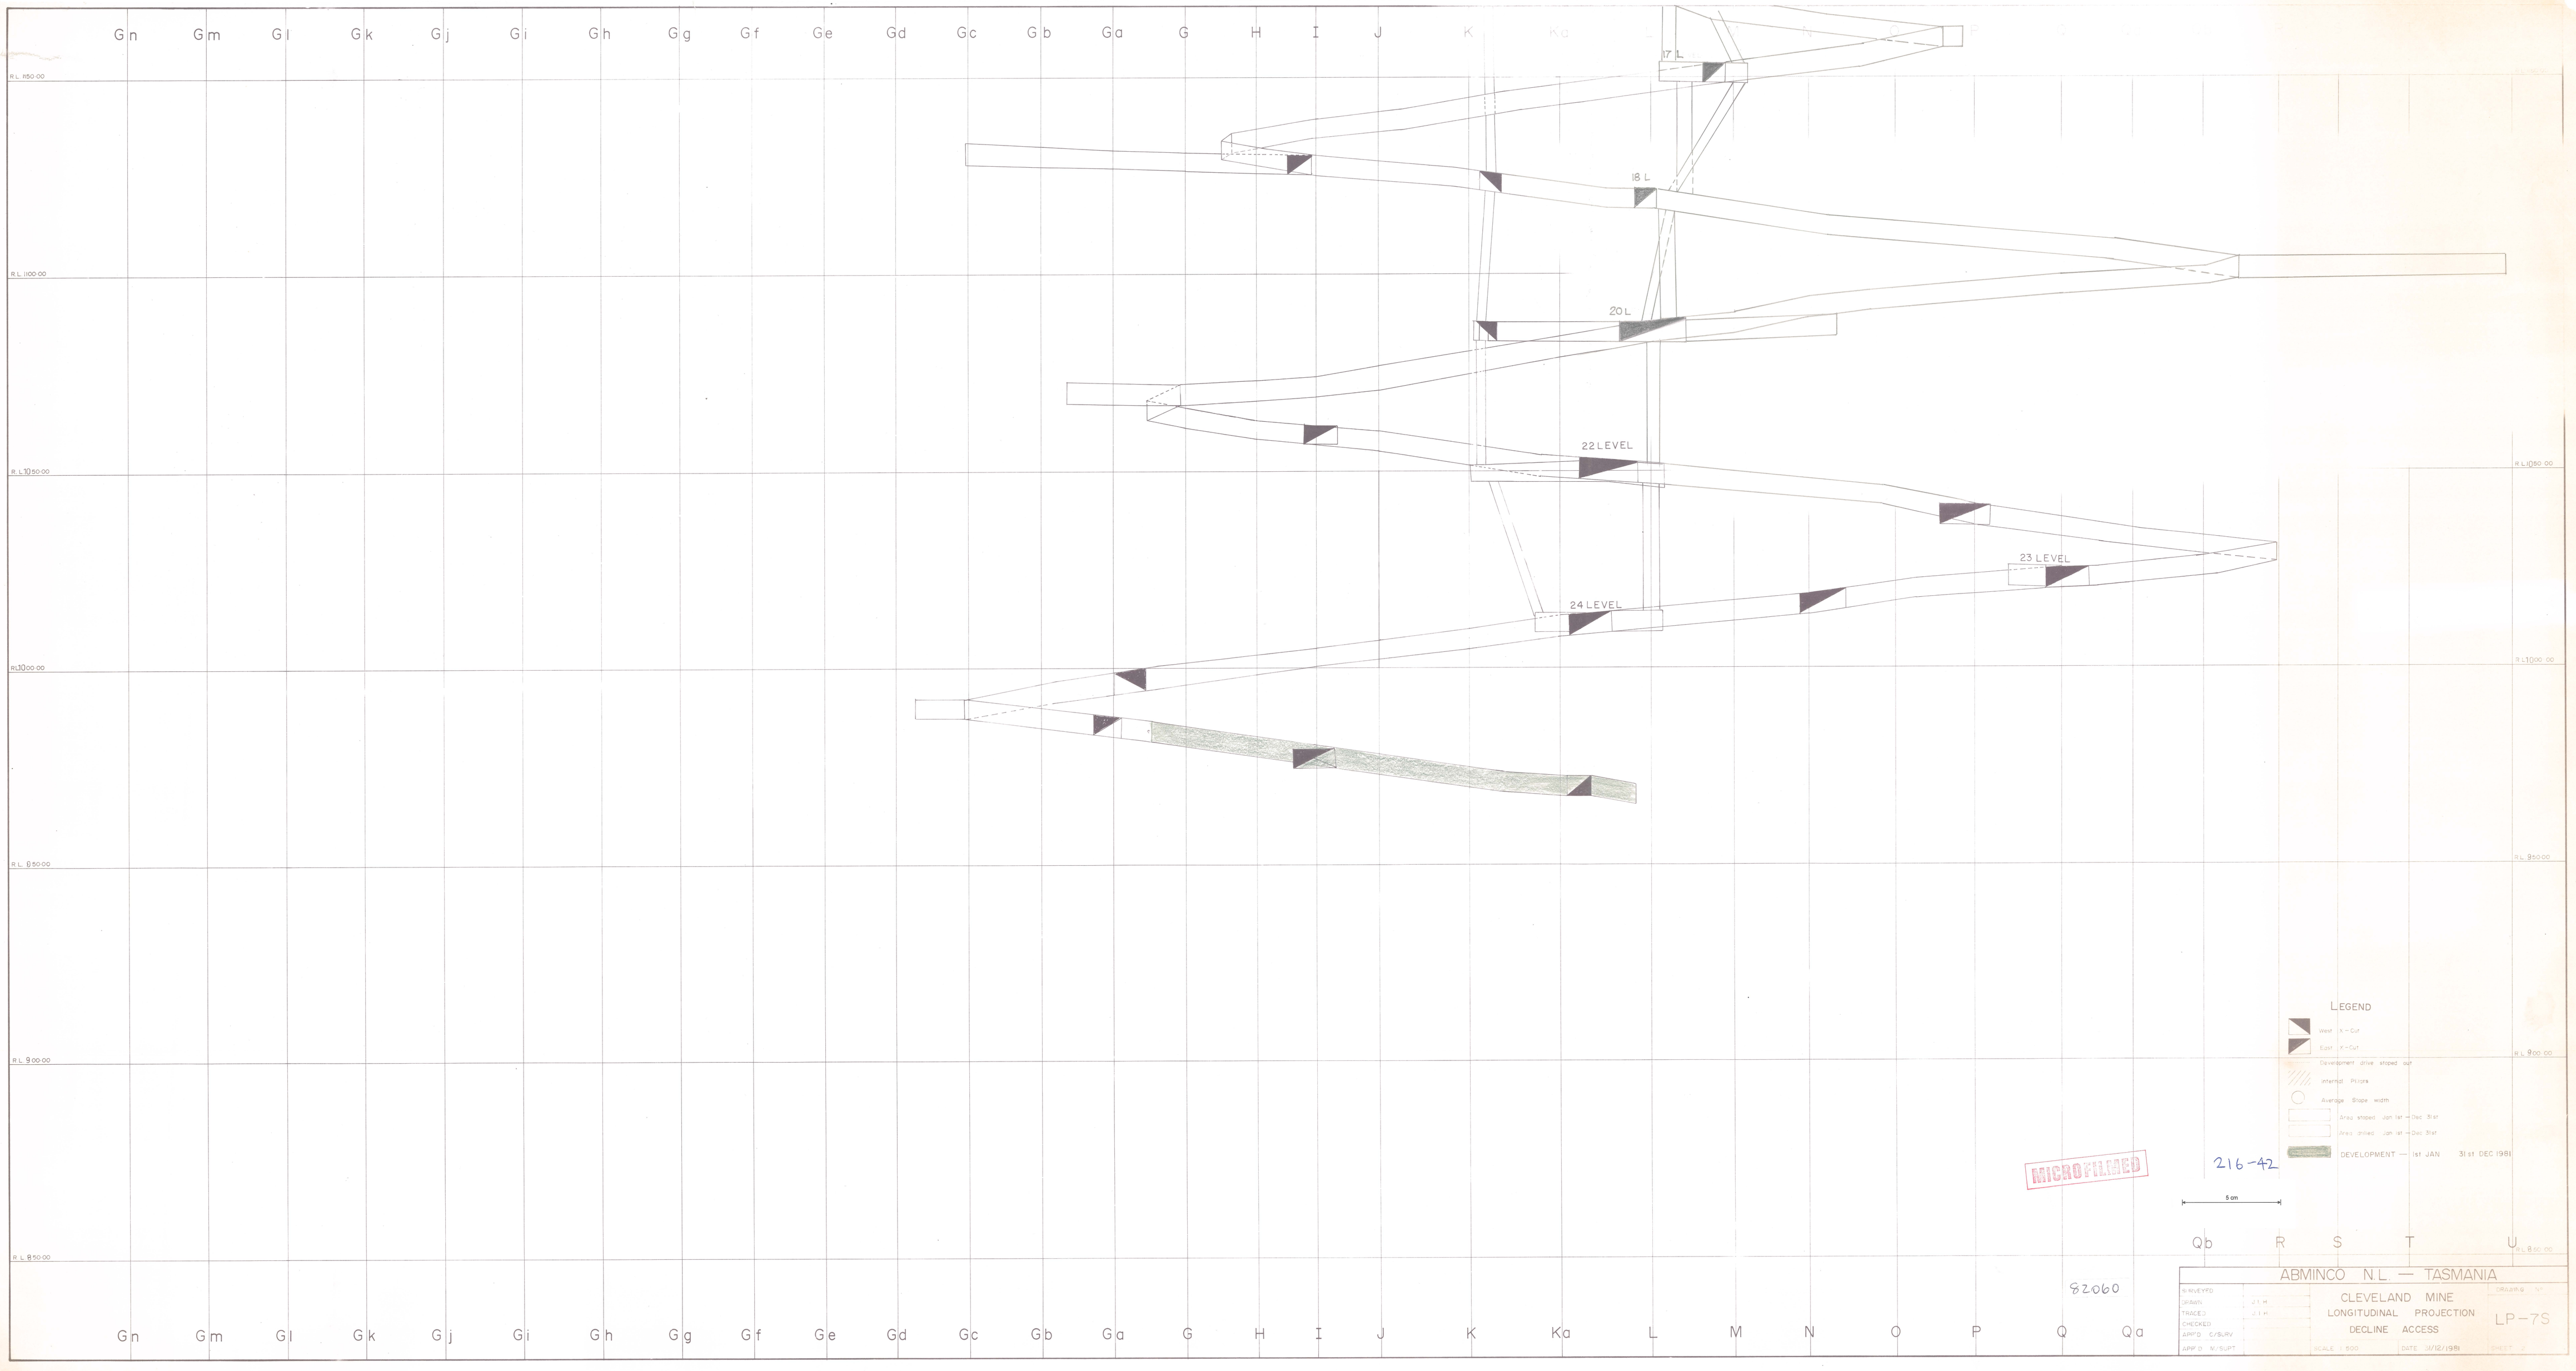
Gn Gm Gl Gk Gj Gi Gh Gg Gf Ge Gd Gc Gb Ga G H I J K Ka L M N O P Q Qa
Qb R S T U
R.L. 1150·00
R.L. 1100·00
R.L. 1050·00
R.L. 1000·00
R.L. 950·00
R.L. 900·00
R.L. 850·00
17 L
18 L
20 L
22 LEVEL
23 LEVEL
24 LEVEL
LEGEND
West X-Cut
East X-Cut
Development drive stoped out
Intended Stope
Average Stope width
Area stoped Jan 1st - Dec 31st
Area stoped Jan 1st - Dec 31st
DEVELOPMENT — 1st JAN 31st DEC 1981
5 cm
MICROFILMED
216-42
82060
ABMINCO N.L. — TASMANIA
SURVEYED
DRAWN J.T.M.
TRACED J.T.M.
CHECKED
APP'D C/SURV.
APP'D M/SUPT.
CLEVELAND MINE
LONGITUDINAL PROJECTION
DECLINE ACCESS
DRAWING No.
LP-7S
SCALE 1:500
DATE 31/12/1981
SHEET No.