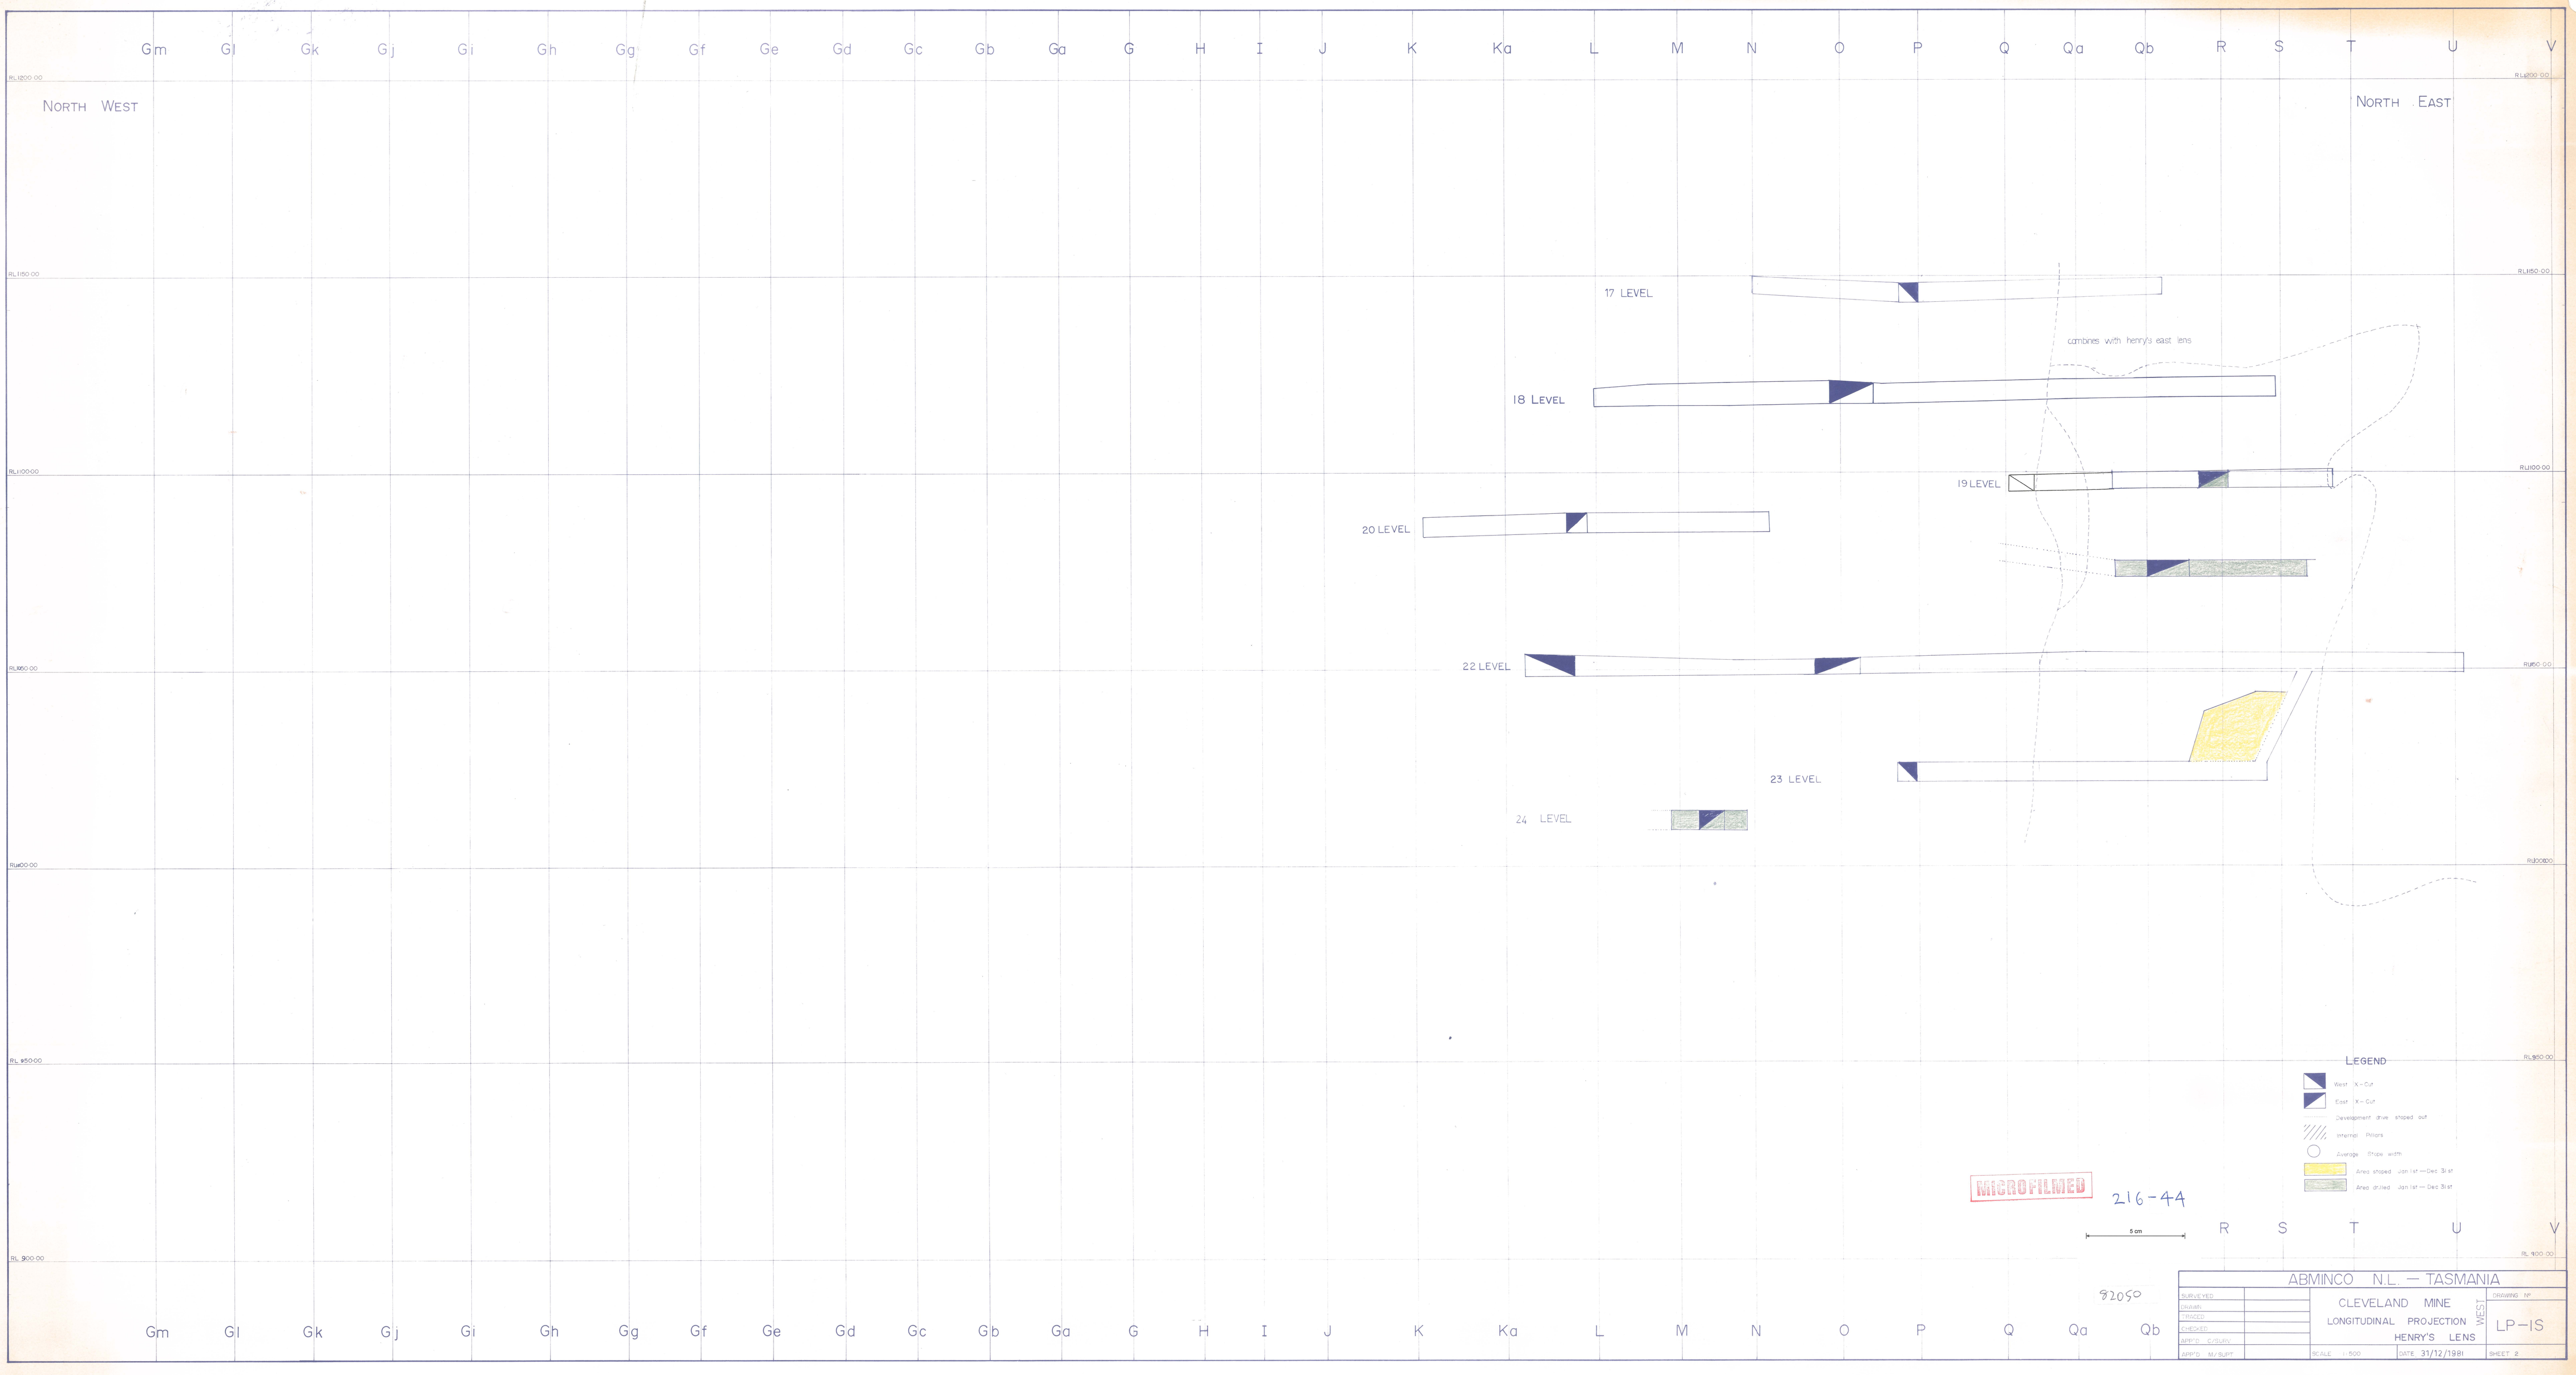
Gm Gl Gk Gj Gi Gh Gg Gf Ge Gd Gc Gb Ga G H I J K Ka L M N O P Q Qa Qb R S T U V
RL 1200.00
NORTH WEST
NORTH EAST
RL 1150.00
17 LEVEL
combines with henry's east lens
18 LEVEL
RL 1100.00
19 LEVEL
20 LEVEL
22 LEVEL
RL 950.00
23 LEVEL
24 LEVEL
RL 850.00
RL 800.00
RL 900.00
LEGEND
West X-Cut
East X-Cut
Development drive stoped out
Intermediate Pillars
Average Stope width
Area stoped Jan 1st — Dec 31st
Area drilled Jan 1st — Dec 31st
MICROFILMED
216-44
5 cm
82050
ABMINCO N.L. — TASMANIA
SURVEYED
DRAWN
TRACED
CHECKED
APP'D ENGINR
APP'D M/SUPT
CLEVELAND MINE
LONGITUDINAL PROJECTION
HENRY'S LENS
WEST
DRAWING No
LP-1S
SCALE 1:500
DATE 31/12/1981
SHEET 2