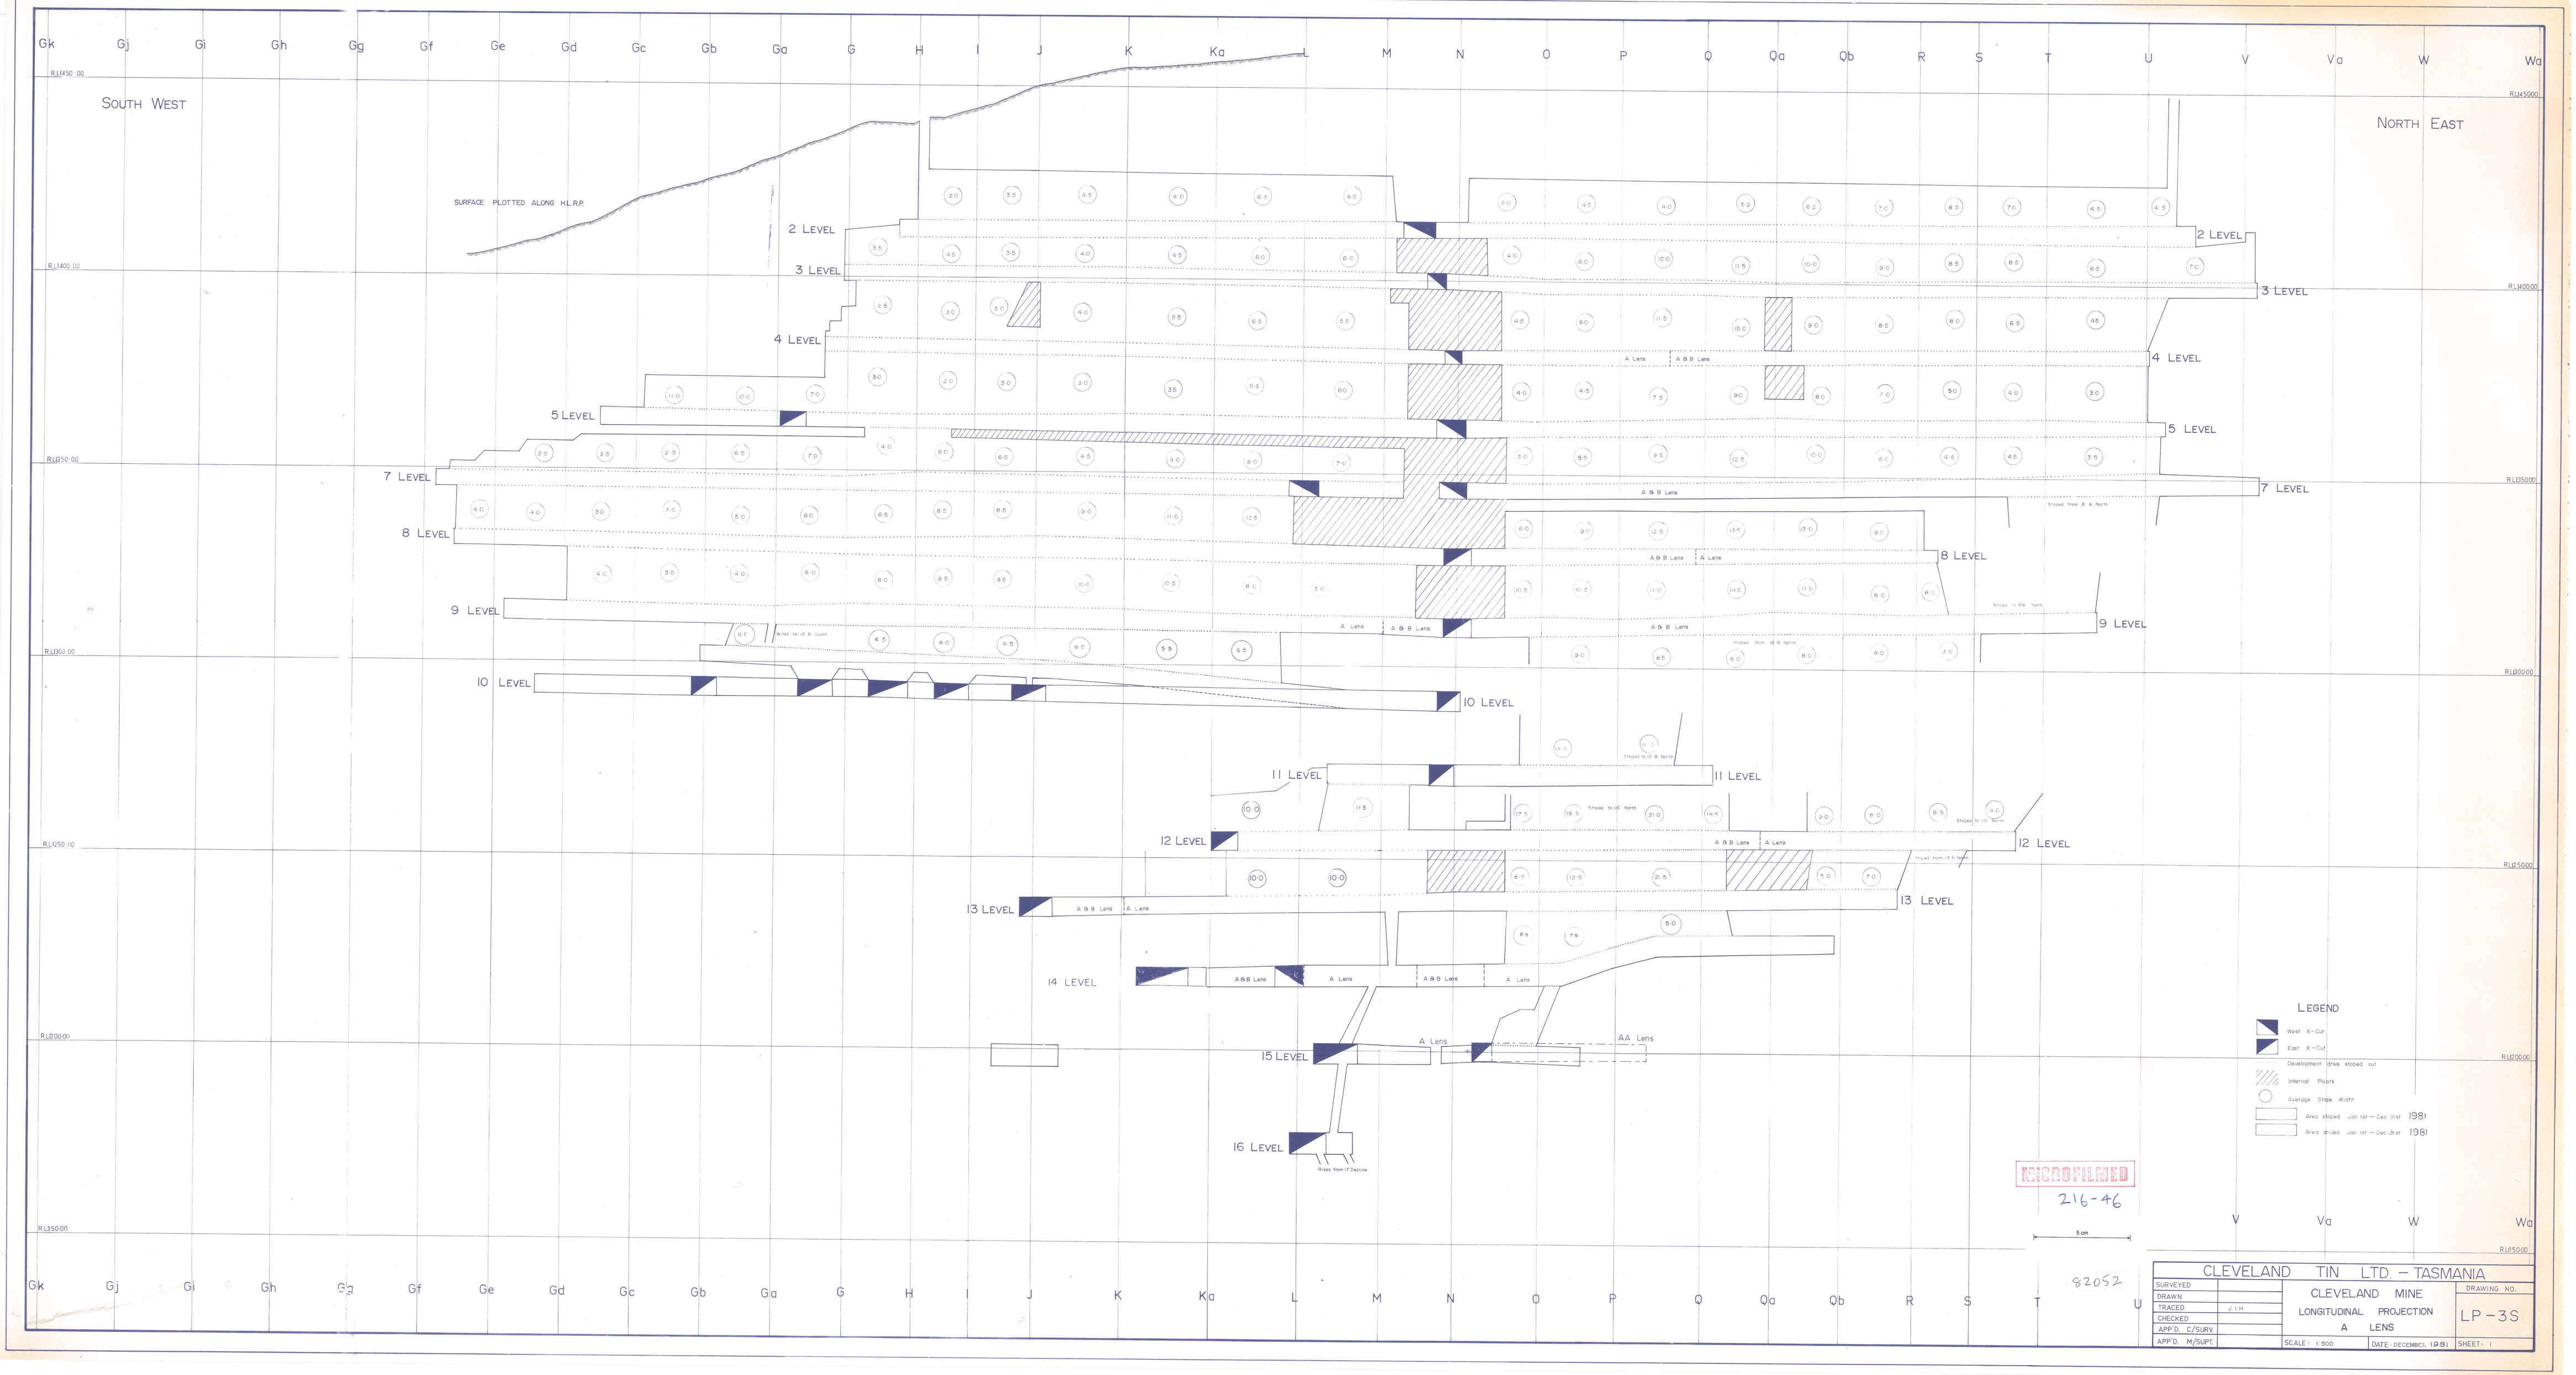
SOUTH WEST
NORTH EAST
SURFACE PLOTTED ALONG H.L.R.P.
2 LEVEL
3 LEVEL
4 LEVEL
5 LEVEL
7 LEVEL
8 LEVEL
9 LEVEL
10 LEVEL
11 LEVEL
12 LEVEL
13 LEVEL
14 LEVEL
15 LEVEL
16 LEVEL
A Lens
A & B Lens
AA Lens
Stoped from 8 B North
Stoped to 8 B North
Stoped to 10 B North
Stoped from 10 B North
Stoped to 10 C North
Stoped from 13 B North
Raise to 10 B South
Raises from 17 Decline
LEGEND
West X-Cut
East X-Cut
Development drive stoped out
Internal Pillars
Average Stope Width
Area stoped Jan 1st — Dec 31st 1981
Area drilled Jan 1st — Dec 31st 1981
MICROFILMED
216-46
5 cm
82052
CLEVELAND TIN LTD. — TASMANIA
SURVEYED
DRAWN
TRACED J.L.H.
CHECKED
APP'D. C/SURV.
APP'D. M/SUPT.
CLEVELAND MINE
LONGITUDINAL PROJECTION
A LENS
DRAWING NO.
LP-3S
SCALE: 1:500
DATE: DECEMBER, 1981
SHEET: 1